

CENTRAL MAPPING AUTHORITY

GEODETIC SURVEY OF NSW

GEODETIC STATION RECONNAISSANCE and MAINTENANCE REPORT


STATION: **ARCADIA** No.: **637**

MAP SHEET SCALE 1:250 000 **CARGELLIGO**

INSPECTED BY: **G. C. HANNA** DATE: **16/5/79**

AUTHORITY: **C.M.A.** FIELD BOOK:

- Description:
1. Cleared by lanes bearing..... *Note: Cross out word or words which do not apply*
 2. Mast & Vanes have been painted white & black respectively.
 3. The station/pillar was unpiled/not unpiled/constructed on.....19..... dimensions now being:
Description of mark.....should be explicit, e.g., S/Steel Pillar Plate, Steel plug-Brass plug, Bolt, G.I. Pipe
Height of mark.....m. ^{above} rock/concrete; Mark is.....m. ^{above} G.L.
 4. A.....~~.....~~ set in conc/rock has been placed/found, bearing.....° M from Mast/Plug/Pillar
 5. A.....~~.....~~ set in conc/rock has been placed/found, bearing.....° M from Mast/Plug/Pillar
 6. A.....~~.....~~ set in conc/rock has been placed/found, bearing.....° M from Mast/Plug/Pillar
 7. A.....~~.....~~ set in conc/rock has been placed/found, bearing.....° M from Mast/Plug/Pillar
 8. Action required:.....

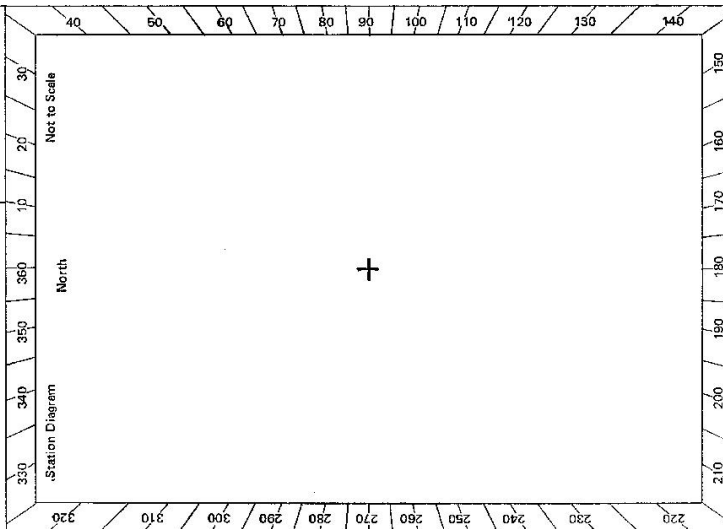

STANDPOINT:

Mark	Direction	Horiz. Distance	Height Difference	Mark	Direction	Horiz. Distance	Height Difference
			above standpt.				above standpt.
			below standpt.				below standpt.
			above standpt.				above standpt.
			below standpt.				below standpt.
Prepared by: *G. Hanna* 16/5/79 Checked: *[Signature]* Noted on U.T.M. Card

STATION ARCADIA	637	Owner's Name: Address: "Arcadia" Phone: Current Occupant: Address: Phone: ACCESS See Google: 8030 - 5 Access Report of 16/5/1971 was found suitable/unavailable.	Trig previously visited 1973 Cairn, mast & vanes seen in centre of small hill. No clearing required Possible drive to from "Arcadia" property	Not to Scale 	Record of Station Date:
St 2733-2 D. West Government Printer Beacon Diagram		This section to be completed by officer constructing pillar. Original station mark found/not found. Description of mark: Original beacon found/not found. Description of beacon: Height Top of Vanes to Top Mark m. Height of mark m. above below G.L. Diameter of Vanes m. Height of Cairn m. Original Beacon has/has not been destroyed by me.			Date: