

GEODETTIC SURVEY OF A.S.W.

CENTRAL MAPPING AUTHORITY

GEODETTIC STATION RECONNAISSANCE and MAINTENANCE REPORT

Description:

1. Cleared by lanes bearing $7-22^{\circ} 32' 56''$, $42-157^{\circ} 10' 14''$, $104-140^{\circ} 10' 14''$ from Trig. Mast $178-192^{\circ} 208-338$.
2. Mast & Vanes have been painted white & black respectively.
3. The station/pillar was ~~unplaced~~ constructed on $12-5-1979$, dimensions now being: Description of mark $5/5 \times 2.4/2.4$ should be explicit, e.g., S/Steel Pillar Plate, Steel plug, Brass plug, Bolt, G.I. Pipe Height of mark 1.35 m. above below rock/concrete; Mark is 3.95 m. Diameter of Vanes (vertical) 0.75 m. Height of Top Vanes to Top Mark/Pillar plate 1.35 m. Diameter of Cairn 0.1 m. Name Plate found/~~not found~~ placed. Length of Mast 1.75 m. (approximate if not unplaced)
4. ~~A. 1.35 m. set in conc/reek has been placed~~/found, bearing $33^{\circ} 33'$ M from Mast/Plug/Pillar
5. A. ~~S.M.~~ set in conc/reek has been placed/found, bearing $353^{\circ} 33'$ M from Mast/Plug/Pillar
6. A. ~~G.I. P.~~ set in conc/reek has been placed/found, bearing $92^{\circ} 2'$ M from Mast/Plug/Pillar
7. A. ~~set in conc/reek has been placed~~/found, bearing $92^{\circ} 2'$ M from Mast/Plug/Pillar
8. Action required:

Note: Cross out word or words which do not apply


STATION: GLENVIEW No.: 6374

MAP SHEET SCALE 1:250 000

INSPECTED BY: M. M. GILLIVRAY

DATE: 14-5-79

AUTHORITY: C.M.A.

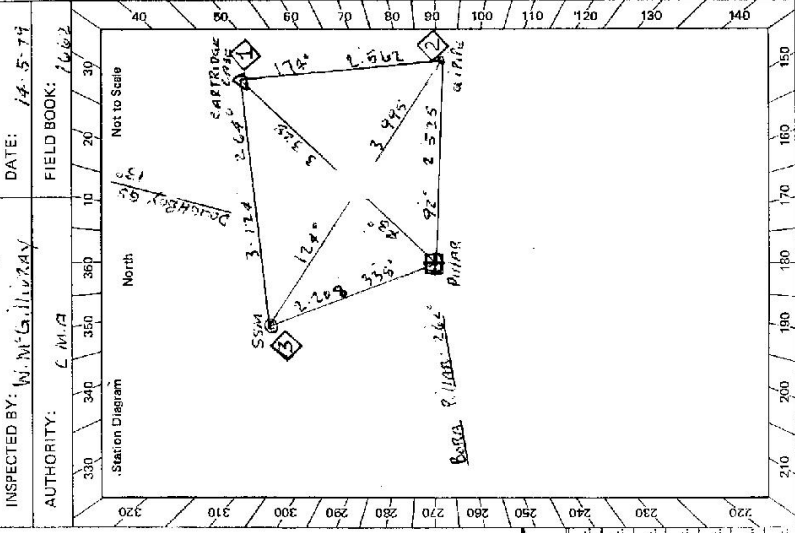

Mark	Direction	Horiz. Distance	Height Difference	Mark	Direction	Horiz. Distance	Height Difference
DOWNSHAY GS	309 59 40		above standpt.	DOWNSHAY GS	309 59 40		above standpt.
LARTRIDGE CAIRN	29 25 40	3.323	below	G.I. PIPE	159 46 25	2.562	above standpt.
G.I. PIPE	18 06 00	2.525	below	GLENVIEW ?	208 27 50	3.179	above standpt.
BORA PILLAR	246 41 30		below	BORA PILLAR	246 47 55		above standpt.
S.S.M.	323 21 50	2.208	below	S.S.M.	745 18 30	3.124	above standpt.
			below				below
			below				below

STANDPOINT: CONC. WDS. PILLAR
 STATION: GLENVIEW C.M.A.

Prepared by: M. M. Gillivray

Checked: M. M. Gillivray

Noted on U.T.M. Card


Checked

SI 2733-2 D. West, Government Printer

STATION GLADVIEW Hill TS 6374

Owner's Name: D.A.M. KATE
 Address:
 Phone:
 Current Occupant:
 Address:
 Phone:

ACCESS
 Access Report of 12/19/64 as found suitable/unsuitable.

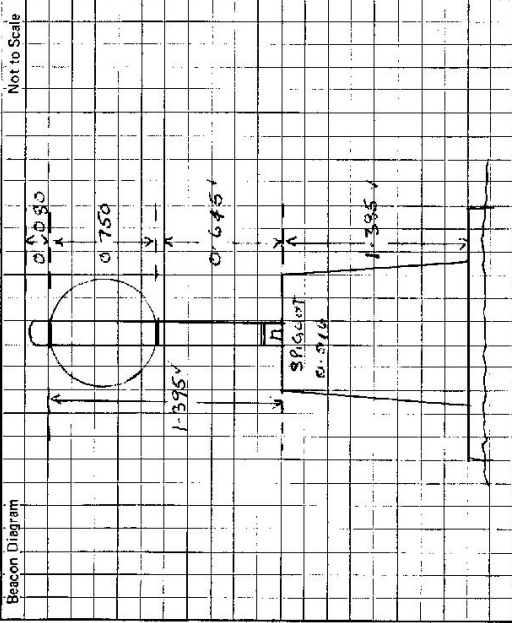

This section to be completed by officer constructing pillar.

Original station mark found/~~not found~~.

Description of mark: CONCRETE PILE

Original beacon found/~~not found~~.

Description of beacon: CONCRETE PILE

Height Top of Vanes to Top Mark: 2.77 m.

Height of mark: 0.23 m. above rock/stone 0.35 m. below G.L.

Diameter of Vanes: 0.75 m. Height of Cairn: 1.30 m.

Original Beacon ~~has~~ been destroyed by me.

Date

Record of Station

GEODETIC SURVEY OF N.S.W.

CENTRAL MAPPING AUTHORITY

GEODETIC STATION RECONNAISSANCE and MAINTENANCE REPORT

- Description:
- Note: Cross out word or words which do not apply
- Cleared by lanes bearing..... from Trig. Mast
 - Mast & Vanes have been painted white & black respectively.
 - The station/pillar was unpiled/not unpiled/constructed on..... dimensions now being: 10.....
 - Description of mark..... should be explicit, e.g., Steel Pillar/Plate, Steel plug, Brass plug, Bolt, G.I. Pipe
 Height of mark.....m. ^{above} rock/concrete; Mark is ^{above} G.L.
 Height of Top Vanes to Top Mark/Pillar platem. Diameter of Vanes (vertical).....m.
 Height of Cairn.....m. Diameter of Cairn.....m. Name Plate found/not found/placed.
 Length of Mast.....m. (approximate if not unpiled)
 - A..... set in concrete/rock has been placed/found, bearing.....° M from Mast/Plug/Pillar
 - A..... set in concrete/rock has been placed/found, bearing.....° M from Mast/Plug/Pillar
 - A..... set in concrete/rock has been placed/found, bearing.....° M from Mast/Plug/Pillar
 - A..... set in concrete/rock has been placed/found, bearing.....° M from Mast/Plug/Pillar
 - Action required:.....

STANDPOINT:

Mark	Direction	Horiz. Distance	Height Difference	Mark	Direction	Horiz. Distance	Height Difference
			above standpt.				above standpt.
			below				below
			above standpt.				above standpt.
			below				below
Prepared by: AS 44-3-80

Checked:


UJ 17/3/80

Noted on U.T.M. Card

St. 2733-1

STATION: GLENVIEW
 MAP SHEET SCALE 1:250 000
 No.: 2229

INSPECTED BY: C. Zahra
 AUTHORITY: CMA
 DATE: 23-10-79
 FIELD BOOK: 1778

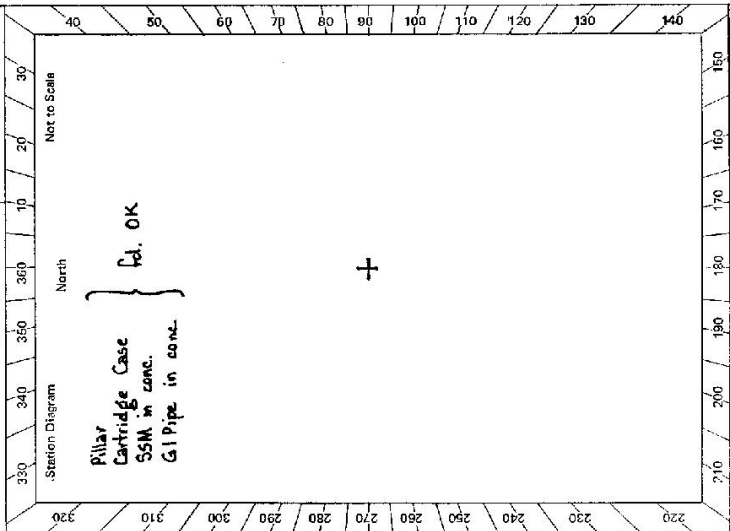

Checked

