

STATION **Lomberton (Pillar) 6379**

Owner's Name: **Ms. W. Whitbread**
 Address: **CARINDA**
 Phone: **0415308**

Current Occupant: **Mr. Whitbread**
 Address:
 Phone:

ACCESS

Access Report of **11/1/1979** was found suitable/unusable.


FEATURES

0.0 Turn Right Hand **Toward Armistade.**
 0.20 Turn Right Sign, **South Lumbering Gun Club.**
 1.70 Turn Right Sign, **Lumbering Gun Club.**
 10.10 Turn Left Sign, **Lumbering Gun Club.**
 17.40 Turn Right Sign, **Lumbering Gun Club.**
 22.10 End of sealed road, **Travel straight ahead.**
 28.30 Owners property on right, **Coaling.**
 30.30 Turn Right over **Gully Sign, Local.**
 30.40 Pass house on left.
 30.50 Through opening in fence, **on left follow track.**
 30.60 Through double iron gates, **follow track.**
 31.40 Through double iron gates, **follow track.**
 31.80 Through double iron gates, **turn right & follow fence.**
 32.30 Turn Left, **leave fence, line & mark own way to bottom of**
 32.40 **padding & gully crossing.**

33.14 33.20 **Gully crossing. Turn left and follow fence.**
 33.30 **Iron gate continue to follow fence.**
 34.3 34.4 34.50 **Gully crossing. Continue following fence**
 34.60 **leave fence & follow faint track toward bulldozed fence or sided hill**
 35.00 **Follow faint track up ridge toward blaze trees.**
 35.40 **Leave vehicle. About 5 minutes early walk to cone obs pillar.**

Date:

Record of Station

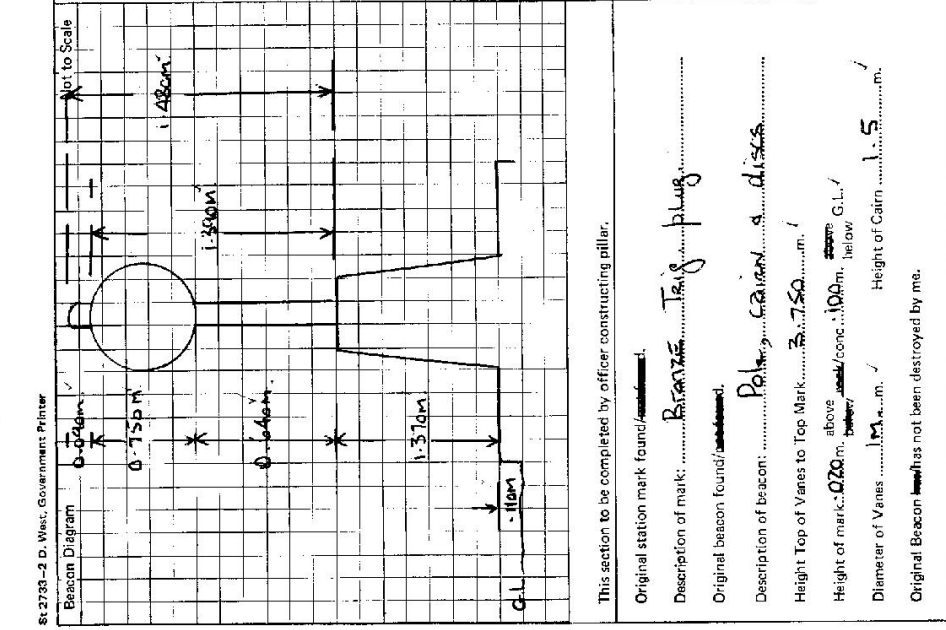

CENTRAL MAPPING AUTHORITY

GEODETIC SURVEY OF N.S.W.

GEODETIC STATION RECONNAISSANCE and MAINTENANCE REPORT

STATION: LOONBERAI (P) No.: 6379

MAP SHEET TAMWORTH SCALE 1:250 000 SH 56-13

INSPECTED BY: E.P. JACKSON DATE: 26/7/1979

AUTHORITY: Geodetic Survey CMA FIELD BOOK: 1751


Description: *Note: Cross out word or words which do not apply*

1. Cleared ~~by~~ ~~beings~~ ~~.....~~ from Trig. Mast
2. Mast & Vanes have been painted white & black respectively.
3. The ~~station~~/pillar was unplaced/~~replaced~~ on ~~JULY.26~~ 19 ~~79~~ dimensions now being:
S/Steel PILLAR Plate in Concrete Observation PILLAR
Description of mark ~~.....~~ should be explicit, eg. S/Steel Pillar Plate, Steel Plug, Brass Plug, Bolt, G.I. Pipe
Height of mark ~~.....~~ m. above rock/concrete; Mark is ~~.....~~ m. above G.L.
Height of Top Vanes to Top ~~.....~~ m. Diameter of Vanes (vertical) 0.752 m.
Height of Cairn ~~.....~~ m. Diameter of Cairn ~~.....~~ m. Name Plate found/~~not found~~
Length of Mast ~~.....~~ m. (approximate if not unplaced) PILLAR Spiggot is 0.015 m above Plate.
4. A. Brass PLUG ~~.....~~ set in conc/~~rock~~ has been ~~placed~~/found, bearing ~~.....~~ M from ~~Mast/Plug~~/Pillar
5. A. S.S.M. N^o 1642 ~~.....~~ set in conc/~~rock~~ has been ~~placed~~/found, bearing ~~.....~~ M from ~~Mast/Plug~~/Pillar
6. A. G.I. Pipe ~~.....~~ set in conc/~~rock~~ has been ~~placed~~/found, bearing ~~.....~~ M from ~~Mast/Plug~~/Pillar
7. A. ~~.....~~ set in conc/rock has been placed/found, bearing ~~.....~~ M from Mast/Plug/Pillar
8. Action required: ~~.....~~

STANDPOINT: s/Steel PILLAR Spiggot			STANDPOINT: S/Steel PILLAR Spiggot			
Mark	Direction	Horiz. Distance	Height Difference	Direction	Horiz. Distance	Height Difference
Brass PLUG found	7° 31' 59"	2.549	1.484 above	GOONCO GOONCO	297° 49' 40"	above standpt.
S.S.M. 1642 fd.	11° 15' 35"	5.206	1.332 above	GOAT MOUNTAIN (P)	18° 19' 04"	above standpt.
G.I. Pipe fd.	188° 35' 52"	2.224	1.262 below	BLACK JACK	101° 38' 48"	above standpt.
MUNDLE	159° 01' 42"		below	YEEROWIN (P)	132° 39' 18"	above standpt.
SNOWDEN	197° 12' 26"		below			above standpt.
GASFARD	214° 14' 58"		below			above standpt.
BELGAMBA	277° 12' 16"		below			above standpt.

Prepared by: *E.P. Jackson* 20/9/1979 Checked: *E.P. Jackson* 7-11-79 *Checked on U.T.M. Grid*

SI 2733-1

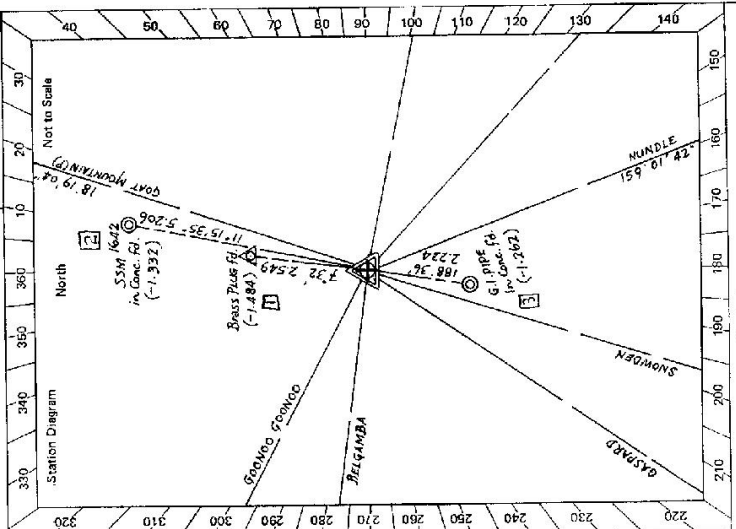

GEODETIC SURVEY OF N.S.W.

CENTRAL MAPPING AUTHORITY


GEODETIC STATION RECONNAISSANCE and MAINTENANCE REPORT

STATION: Loomberah Conc. obs. Pillar No.: 6379

MAPSHEET SCALE 1:250 000

INSPECTED BY: David Knia DATE: 15 September 1983

AUTHORITY: C. M. A. FIELD BOOK: 1946

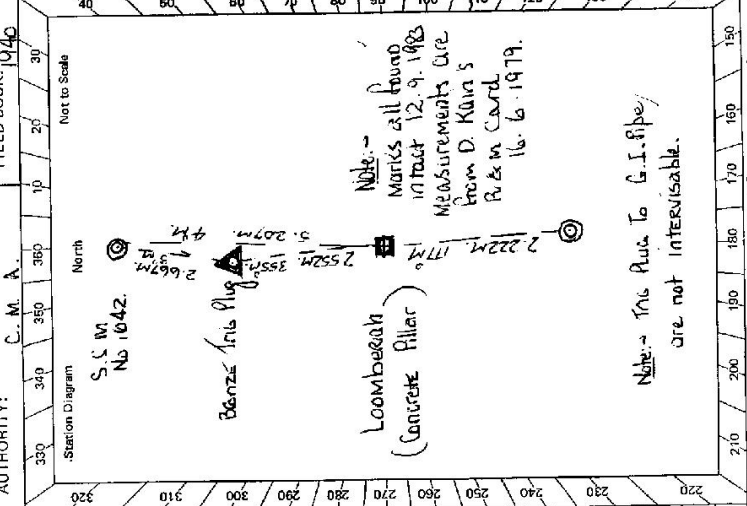

- Description: *Note: Cross out word or words which do not apply*
1. Cleared by ~~hand~~ 16 Perm. 360° *vision* from Trig. ~~Mast~~ Pillar.
 2. Mast & Vanes have been painted white & black respectively. *Ironed & maintained*
 3. The ~~station/pillar~~ was replaced on 12 September 83, dimensions now being: *Central Mapping Authority*
 4. Description of mark: Steel Pillar Plate should be explicit; e.g., S/Steel Pillar Plate, Steel plug, Brass plug, Bolt, G.I. Pipe *Central Mapping Authority*
 5. Height of mark: 1.489 m. *above G.L.* Diameter of Vanes (vertical): 0.150 m.
 6. Height of Top Vanes to Top ~~mark~~ mark 1.425 m. *above G.L.* Diameter of Vanes (vertical): 0.150 m.
 7. Height of Cairn: 0.515 m. *(approximate if not omitted)* Name Plate found/lost/removed/placed 12.9.1983
 8. * Length of Mast: 1.515 m. *(approximate if not omitted)* Central Mapping Authority
- Note: P.V.L. Mast was replaced on 12.9.83 on my visit to this station. (See U.I.M. Card)*
1. A. Strange in plug set in conc/rock has been placed/found, bearing 3.55° *from Mast/Plug/Pillar Loomberah*
 2. A. S.S.M. No. 1042 set in conc/rock has been placed/found, bearing 4.0° *from Mast/Plug/Pillar*
 3. A. G.I. Pipe set in conc/rock has been placed/found, bearing 177.6° *from Mast/Plug/Pillar*
 4. A. set in conc/rock has been placed/found, bearing° *from Mast/Plug/Pillar*

STANDPOINT:

Mark	Direction	Horiz. Distance	Height Difference	Mark	Direction	Horiz. Distance	Height Difference
			above standpt.				above standpt.
			below standpt.				below standpt.
			above standpt.				above standpt.
			below standpt.				below standpt.
STANDPOINT: 16.6.1979 *Checked*

Prepared by: D. Knia Checked: 30/9/83 *Noted on U.I.M. Card*

6. 2735-2 D. West, Government Printer

STATION **Loamberah Concrete obs. Pillar 6379**


Owner's Name: **Mr. W. Whitbread**
 Address: **Caronyra**
 Phone: **69 1508**

Access Owner: **Mr. Davis Jackson**
 Address: **Loamberah**
 Phone: **(657) 69 1553**

ACCESS **12-9-1983**

Access Report of **M. G. 19** was found **unsuitable**.

0.00 **JAMWORTH Post Office Travel North along Fitzroy Street.**
0.20 **Turn Right and Travel towards Memorial**
7.20 **Turn Right Sign "MUNILE"**
7.40 **Turn Right Sign "South Jamworth Gun Club"**
10.10 **Turn Left Sign "Loamberah Gun Club"**
17.40 **Turn Right Sign "Loamberah"**
22.00 **End of sealed road travel straight ahead.**
26.30 **Pass owners property on your R. 11/9, "MUNILE"**
30.30 **Turn Right over level "Sign" "TACAL"**
30.40 **Pass access owners house on your L. 11/5, follow fence.**
30.50 **Through opening in fence on your left, follow fence.**
31.40 **Through double iron gates, follow track.**
31.60 **Through double iron gates, follow track.**
31.80 **Through double iron gates, follow track.**
32.30 **Through double iron gates, follow track.**
33.05 **Continue Banks to Gully crossing, follow fence.**
33.20 **Boundary fence, turn left & follow fence following fence.**
33.70 **Through iron gate and know continue following fence.**
34.50 **Follow bulldozed cutting up hill, right then as far as possible up ridge by vehicle to blaze a row trees.**
35.30 **Left then into saddle on your right then as far as possible up ridge by vehicle to blaze a row trees.**
At 35.50 **klms. five minute easy walk to Loamberah Conc. Pillar.**

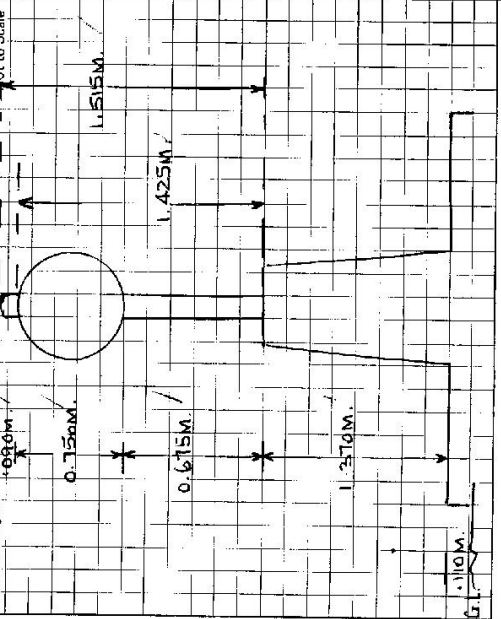

This section to be completed by officer constructing pillar.

Original station mark found/not found.

Description of mark:

Original beacon found/not found.

Description of beacon:

Height Top of Vanes to Top Markm.

Height of mark:m. above G.L. below

Diameter of Vanesm. Height of Cairnm.

Original Beacon has/has not been destroyed by me.

Date

Record of Station