

GEODETIC SURVEY OF M.S.W.


CENTRAL MAPPING AUTHORITY

GEODETIC STATION RECONNAISSANCE and MAINTENANCE REPORT

Description:

- Cleared by lanes bearing  $127^{\circ} 30' 33.3''$  from Trig. Mast
- Mast & Vanes have been painted white & black respectively, ✓
- The station/pillar was ~~not~~ <sup>replaced</sup> ~~not~~ <sup>replaced</sup> constructed on  $19.7.7.7$ , dimensions now being: Description of mark  $S/S$  <sup>above</sup> ~~below~~  $1.30$  m. Diameter of Vanes (vertical)  $0.75$  m. Height of mark  $1.30$  m. Mark is  $1.30$  m. <sup>above</sup> ~~below~~ G.L.
- Height of Top Vanes to Top Mark/Pillar plate  $1.375$  m. Diameter of Vanes (vertical)  $0.75$  m. Height of Cairn  $0.75$  m. Diameter of Cairn  $0.75$  m. Name Plate ~~found/not found~~ placed.
- Length of Mast  $1.475$  m. (approximate if not unplied)
- A  $BRASS$  <sup>above</sup> ~~below~~  $1.30$  m. set in conc/rock has been placed/ found, bearing  $102^{\circ} 30' 00''$  M from Mast/Pillar/Pillar
- A  $S.S.M$  <sup>above</sup> ~~below~~  $1.30$  m. set in conc/rock has been placed/ found, bearing  $136^{\circ} 00' 00''$  M from Mast/Pillar/Pillar
- A  $G.I. PIPE$  <sup>above</sup> ~~below~~  $1.30$  m. set in conc/rock has been placed/ found, bearing  $50^{\circ} 00' 00''$  M from Mast/Pillar/Pillar
- A  $BRASS$  <sup>above</sup> ~~below~~  $1.30$  m. set in conc/rock has been placed/ found, bearing  $200^{\circ} 33' 40''$  M from Mast/Pillar/Pillar
- Action required: .....

STATION: **RASPBERRY** No.: **TS 6380**  
 MAP SHEET SCALE 1:250 000 **DARRIGO**  
 INSPECTED BY: **M. McCallum** DATE: **29.5.79**  
 AUTHORITY: **CMA** FIELD BOOK: **1662**

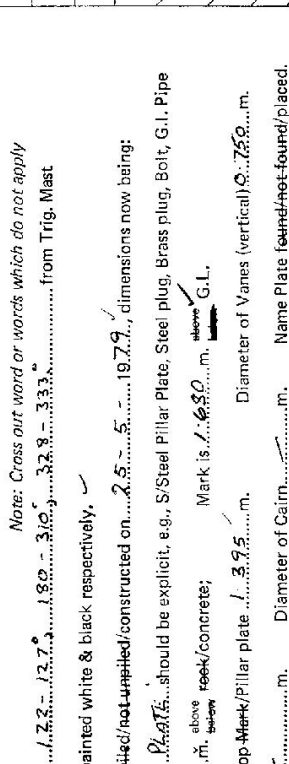

STANDPOINT: <b>CONEC PILLAR</b>			STANDPOINT: <b>BRASS PILLAR</b>				
Mark	Direction	Horiz. Distance	Height Difference	Mark	Direction	Horiz. Distance	Height Difference
OVEN PILLAR	$359^{\circ} 59' 60''$		above standpt.	OVEN PILLAR	$359^{\circ} 59' 60''$		above standpt.
S.S.M	$31^{\circ} 00' 45''$	$2.977$	below standpt.	S.S.M	$104^{\circ} 49' 30''$	$2.727$	below standpt.
BLUE NOBBY P	$113^{\circ} 15' 30''$		above standpt.	BLUE NOBBY P	$113^{\circ} 15' 30''$		above standpt.
G.I. PIPE	$277^{\circ} 00' 30''$	$2.238$	below standpt.	RASPBERRY PILLAR	$161^{\circ} 12' 50''$	$3.434$	below standpt.
BRASS PILLAR	$341^{\circ} 13' 35''$	$3.430$	below standpt.	G.I. PIPE	$200^{\circ} 33' 40''$	$3.779$	below standpt.
			above standpt.				above standpt.
			below standpt.				below standpt.

Prepared by:

Checked: **16.7.79** Noted on U.T.M. Card

GS

<p>St. 2733-2 D. West, Government Printer</p>	<p>STATION <u>RASPBERRY</u> TS <u>6380</u></p>	<p>Owner's Name: .....</p> <p>Address: .....</p> <p>Phone: .....</p>	<p>Current Occupant: .....</p> <p>Address: .....</p> <p>Phone: .....</p>	<p>Access Report of <u>11.5.1971</u> was found suitable/unsuitable.</p> <p style="text-align: center;"><u>ACCESS</u></p> <p>ON <u>ARMIDALE - KEMBLEY ROAD AT STY'S FORESTERY CAMP</u></p> <p><u>0.0 TAKE RASPBERRY ROAD.</u></p> <p><u>4.5 PASS BRUSHWOOD ROAD ON LEFT</u></p> <p><u>11.8 TURN SHARP SIGN RASPBERRY MT.</u></p> <p><u>12.5 TURN SHARP LEFT.</u></p> <p><u>12.8 G.S.</u></p>
<p>Beacon Diagram</p>		<p>Date</p> <p>Record of Station</p>		
<p>This section to be completed by officer constructing pillar.</p>				
<p>Original station mark found/<del>not found</del>.</p>				
<p>Description of mark: <u>B.B.S.S. P.M.G. ✓</u></p>				
<p>Original beacon found/<del>not found</del>.</p>				
<p>Description of beacon: <u>CALIBR. MARK. V.A.M.S. ✓</u></p>				
<p>Height Top of Vane to Top Mark: <u>3.533</u> m.</p>				
<p>Height of mark: <u>0.77</u> m. above <u>0.750</u> ✓ above G.L. below <u>0.000</u> m. below</p>				
<p>Diameter of Vane: <u>0.910</u> m. Height of Caltn: <u>1.20</u> m.</p>				
<p>Original Beacon has/<del>has not</del> been destroyed by me.</p>				