

GEODETIC SURVEY OF A.S.M

CENTRAL MAPPING AUTHORITY

GEODETIC STATION RECONNAISSANCE and MAINTENANCE REPORT

Description:

- Note: Cross out word or words which do not apply
- Cleared by ~~hand~~ to permit ~~vision~~ from Trig. Mast ~~pillar~~ pillar.
 - Mast & Vanes have been painted white & black respectively, ✓
 - The ~~station~~ pillar was ~~constructed~~ constructed on ~~19.1.19~~ 19.1.19, dimensions now being:
Description of mark Steel pillar should be explicit, e.g., S/Steel Pillar Plate, Steel plug, Brass plug, Bolt, G.I. Pipe
Height of mark 1.580 m. ^{above} ~~rock/concrete~~ rock/concrete; Mark is 1.580 m. ^{above} ~~G.L.~~ G.L.
Height of Top Vanes to Top ~~Mark/Pillar plate~~ 1.435 m. Diameter of Vanes (vertical) 0.152 m.
Height of Cairn 0.545 m. Diameter of Cairn 0.152 m. Name Plate ~~placed~~ placed.
Length of Mast 1.580 m. (~~0.152~~)
 - A Brass Pin set in conc/~~rock~~ found, bearing 202.0°M from ~~North~~ North/~~North~~ Pillar
 - A S.S.M. set in conc/~~rock~~ found, bearing 240.0°M from ~~North~~ North/~~North~~ Pillar
 - A G.I. pipe set in conc/~~rock~~ found, bearing 177.0°M from ~~North~~ North/~~North~~ Pillar
 - A Vertical Bourne set in conc/~~rock~~ found, bearing 0.0°M from Mast/~~Plug~~ Pillar

8. Action required: None obs. Pillar

STANDPOINT: <u>Conc. obs. Pillar</u>		STANDPOINT: <u>Brass 1/16" Pin</u>	
Mark	Direction	Horiz. Distance	Height Difference
<u>Brass (P)</u>	<u>0 0 00</u>	<u>0 00 00</u>	<u>above</u> <u>standpt.</u>
<u>G.I. Pipe</u>	<u>45 08 00</u>	<u>3 276</u>	<u>below</u> <u>standpt.</u>
<u>Brass 1/16" Pin</u>	<u>71 26 18</u>	<u>4 803</u>	<u>below</u> <u>standpt.</u>
<u>S.S.M.</u>	<u>112 18 45</u>	<u>3 860</u>	<u>below</u> <u>standpt.</u>
<u>Blue Mtn. (P)</u>	<u>126 57 25</u>	<u>2 333</u>	<u>below</u> <u>standpt.</u>

Prepared by:

Checked by: [Signature] 19/1/23

Noted on U.T.M. Card

Sr 2733-1

STATION: WATERBOURNE (Pillar) No.: TS 6382
 MAP SHEET SCALE 1:250 000
 INSPECTED BY: D.S. KOLA DATE: 14 JUNE 1973
 AUTHORITY: C.M.A. FIELD BOOK: 16820

Station Diagram

North

Net to Scale

Checked

68

Sr 2733-2 D. West, Government Printer


STATION WINTERBOURNE (Pillar) TS 6382

Owner's Name: Ms. P. A. Christmas Current Occupant: Mr. P. A. Christmas
 Address: ALCANTARA STREET Address:
 Phone: 774487 Phone:

ACCESS

Access Report of M. 6/1973 was found suitable/unsuitable.

KMS. 0 0 WALCHA Post Office TRAIL TOWARD UDELLA
0 70 TURN RIGHT SIGN WINTERBOURNE
6 20 DOUBLE WOODEN BRIDGE
7 90 PASS ROAD ON RIGHT SIGN, MOONRA PLAINS
11 00 PASS ROAD ON RIGHT SIGN, EMU CREEK
14 10 END SEALED ROAD
15 10 GRID
15 40 TURN RIGHT SIGN'S TABELAT & WINTERBOURNE
16 10 BRIDGE
17 10 PASS ROAD ON RIGHT SIGN, BANK HUT ROAD
18 60 GRID
24 50 TURN LEFT SIGN WINTERBOURNE ROAD
25 85 GRID SIGN ON GRATE WINTERBOURNE
26 55 PASS HAZELDEWE ROAD ON YOUR LEFT
27 35 GRID
28 10 PASS ROAD ON LEFT
28 80 BRIDGE GRIDS AT 29 80 30 60 31 90 32 40 KMS.
32 50 PASS CUNNINGHAM HOUSE ON LEFT
32 70 TURN LEFT OFF ROAD & FOLLOW FENCE TO GRASS
32 90 TURN GRASS & FOLLOW FENCE TO ANOTHER IRON GATE
33 00 IRON GATE FOLLOW FENCE TRACK
33 10 TURN RIGHT BEHIND FENCE CROSSER & CROSS GULLY
33 40 BLAZE ON TREE FOLLOW TRACK ON LEFT TO GRASS OBS. PILLAR AT 34 30 KMS

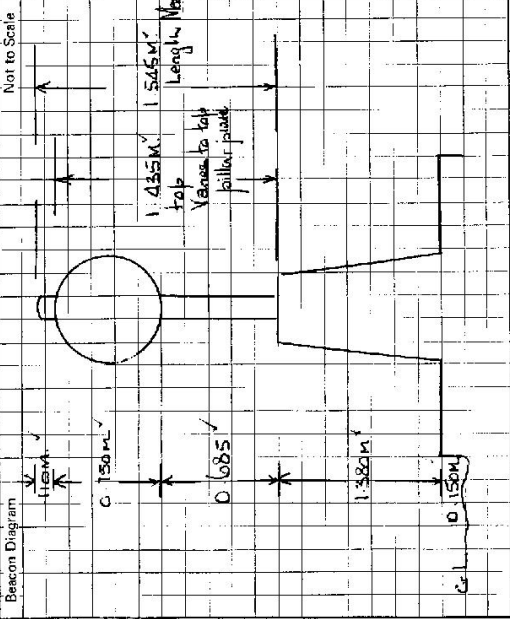

This section to be completed by officer constructing pillar.

Original station mark found/~~not found~~.

Description of mark: Pole 1.1m in grass

Original beacon found/~~not found~~.

Description of beacon: Pole 3.608m in grass

Height Top of Vane to Top Mark: 3.608 m

Height of mark: 0.22 m above grass (conc) 1.0 m above grass G.L.

Diameter of Vane: 1.0 m. Height of Cairn: 1.632 m.

Original Beacon ~~has~~ has not been destroyed by me.

Date	Record of Station