

7-4-96

CENTRAL MAPPING AUTHORITY
Department of Lands

Trigonometrical Survey of N.S.W.

STATION ANDERSONS SUGARLOAF 6387

Co: **Dudley** Ph: **Bellbrook**
Map Sheet: **Macksville** No: **9436**
Inspected by: **L.R. Hollis** Date: **Nov 1976**
Authority: **CMA** Field Book: **1532**

This Trig. Station has been:


1. Completely cleared to permit **360**° vision to surrounding Trigs.
2. Cleared by lanes bearing **354.1 M - 2.50° M** from Trig. Mast
3. Trig. Mast & Vanes have been painted white & black respectively. ✓
4. The Trig. was ~~unpiled~~/not unpiled, dimensions now being:

Description of mark..... should be explicit, e.g. Steel plug, Brass plug, Bolt, G.I. Pipe
Height of mark..... m ^{above}/_{below} rock/concrete..... m ^{above}/_{below} G.L.
Height of Top Vanes to Top Mark..... m. Diameter of Vanes (vertical) **0.76m.**
Height of Cairn..... 1.0 m. Diameter of Cairn..... 2.0 m.
Length of Mast..... m. (approximate if not unpiled)

5. A..... set in conc/rock has been placed..... m. bearing.....°M from Trig. Mast
6. A..... set in conc/spoil has been placed..... m. bearing.....°M from Trig. Mast
7. A..... set in conc/soil has been placed..... m. bearing.....°M from Trig. Mast
8. A..... set in conc/rock has been placed..... m. bearing.....°M from Trig. Mast
9. Connection..... to..... m. bearing.....°M
10. Connection..... to..... m. bearing.....°M
11. Connection..... to..... m. bearing.....°M
12. Connection..... to..... m. bearing.....°M
13. Diff. Ht. is..... m. ^{above}/_{below}
14. Diff. Ht. is..... m. ^{above}/_{below}
15. Diff. Ht. is..... m. ^{above}/_{below}
16. Diff. Ht. is..... m. ^{above}/_{below}

Prepared by: *[Signature]* Checked: *[Signature]*

Noted on U.T.M. Card

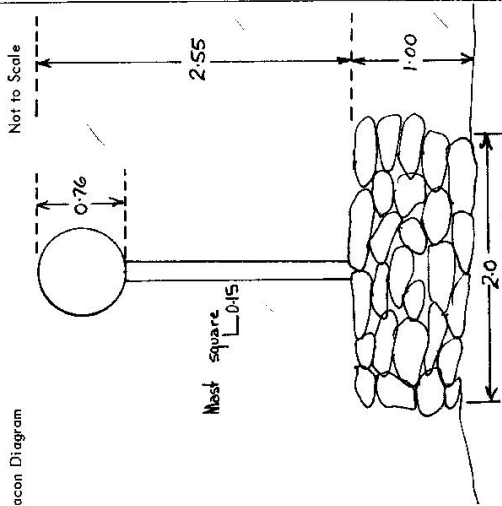

Date	Record of Station

Checked

STATION ANDERSONS SUGARLOAF 6387

Owners Name: Mr. Cecil M. Mearns

Address:

Current Occupant:


Address:

Access Nov 1976

At 0.0 km : Willawarren P.O. Take
road to Bellbrook &
Armidale.
17.3 Bridge over Midnight Ck
See diagram


Station Diagram

North

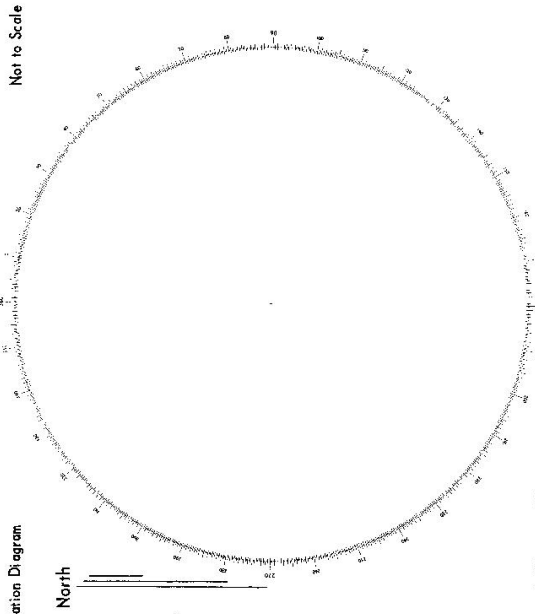

List of Observed Directions:-

Station:		Standpoint:	
Station	Direction	Station	Direction

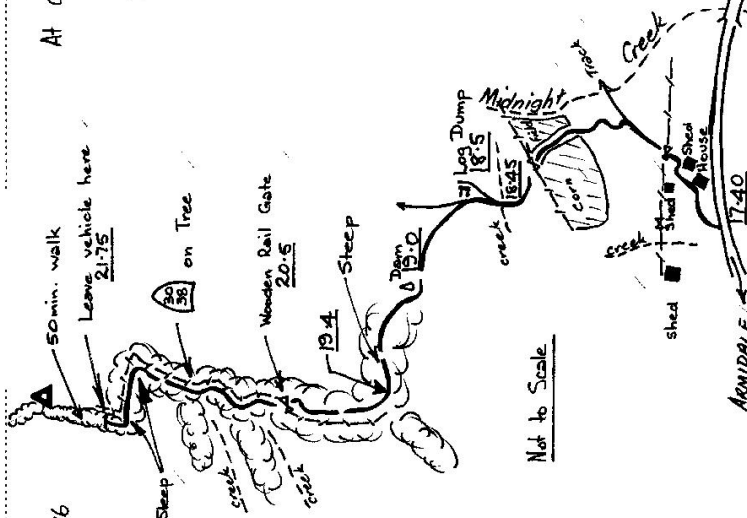

Not to Scale

CENTRAL MAPPING AUTHORITY

GEODETIC SURVEY OF M.S.W.

GEODETIC STATION RECONNAISSANCE and MAINTENANCE REPORT

Description:

Note: Cross out word or words which do not apply

1. Cleared by lanes bearing.....~~358°~~.....to.....~~2.93°~~..... from Trig. Mast
2. Mast & Vanes have been painted white & black respectively. ✓
3. The station/pillar was ~~unplaced/lost/unretrieved~~/constructed on.....~~19th~~....., dimensions now being: Description of mark.....~~1.1m x 1.1m~~..... should be explicit, e.g., S/Steel Pillar Plate, Steel plug, Brass plug, Bolt, G.I. Pipe Height of mark.....~~1.1m~~.....m. above ~~conk/concrete~~ below ~~below~~ Mark is.....~~1.215~~.....m. above G.L. Height of Top Vanes to Top ~~Mast~~/Pillar plate.....~~1.1m~~.....m. ✓ Diameter of Vanes (vertical).....~~1.1m~~.....m. Height of Cairn.....m. Diameter of Cairn.....m. Name Plate ~~found/lost/unretrieved~~/placed. ✓ Length of Mast.....m. (approximate if not unplied)
4. A.....~~Bears Trig~~.....set in conc/~~conk~~ has been ~~placed~~/found, bearing.....~~111~~.....°M from ~~Mast/Ding~~/Pillar
5. A.....~~S.S.M. (N1)~~.....set in conc/~~conk~~ has been ~~placed~~/found, bearing.....~~158~~.....°M from ~~Mast/Ding~~/Pillar
6. A.....~~S.S.M. (N2)~~.....set in conc/~~conk~~ has been ~~placed~~/found, bearing.....~~187~~.....°M from ~~Mast/Ding~~/Pillar
7. A.....set in conc/~~conk~~ has been placed/found, bearing.....°M from Mast/Plug/Pillar
8. Action required:.....

STANDPOINT: Pillar Plate		STANDPOINT: Bears Trig Plate	
Mark	Direction	Horiz. Distance	Height Difference
DOUBLE HEAD P	0 00 00		above standpt. / below
THE BEARERS GS	261 47 50		above standpt. / below
S.S.M. (N1)	269 32 40	5.358	1.720 above standpt. / below
Bears Trig Plug	291 45 00	2.544	2.033 above standpt. / below
HICKLEY P.	305 40 10		above standpt. / below
S.S.M. (N1)	326 54 10	5.991	1.894 above standpt. / below

Prepared by:

Checked: ~~John M. [Signature]~~ 11/11/19. Noted on U.T.M. Card

St 2733-1

STATION: ~~ANDREWS~~ ~~SULLIVAN~~ (P) No.: 6387

MAP SHEET SCALE 1:250 000

INSPECTED BY: ~~L. R. Woods~~ DATE: 24th June 74

AUTHORITY: ~~C. M. A.~~ FIELD BOOK: 1671

Station Diagram

North

Not to Scale

Checked


SI 2733-2 D. West, Government Printer

STATION **ANDERSON'S SUGARLOAF (P) 6387**

Owner's Name:
 Address:
 Phone:
 Current Occupant: **ANDERSON'S SUGARLOAF**
 Address:
 Phone: **24 - 7 - 79**

Access Report of **22/11/1975** was found suitable/unsuitable.

0-00 **WARRINGHEAD P.D TRAVEL TOWARDS BELMONT.**
 17-40 **MINNIGHT CR.**
 17-50 **TOTAL RIGHT HAND MET HOUSE AND R.M.S.**
 17-60 **ISLAND GRASS**
 18-00 **PASS TRUCK ON R.M.S.**
 18-00 **DOUBLE WINDMILL GRASS**
 18-40 **ISLAND GRASS**
 19-00 **TOTAL LEFT OF RIDGE**
 20-50 **TOTAL LEFT THROUGH WINDMILL GRASS**
 20-51 **TOTAL RIGHT FROM MET TRUCK ALONG TRAVEL.**
 23-30 **LEAVE VEHICLE: 15 MINUTE FINE BLANK.**
 Note **FROM ABOUT 17-40 TO 18-30 TRAVEL ON W**
DLX WINDMILL.

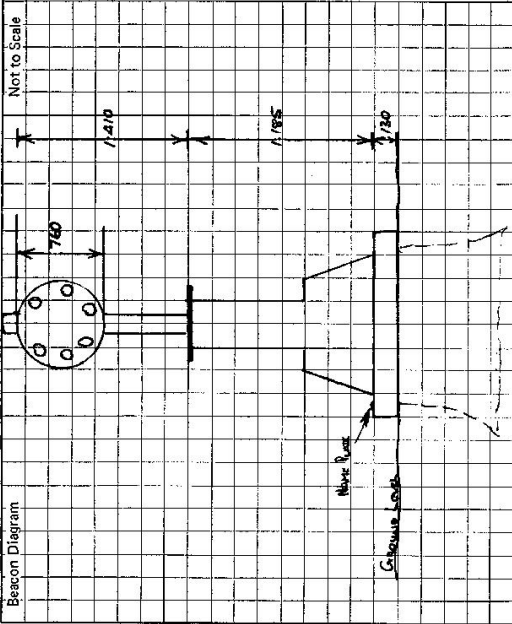

This section to be completed by officer constructing pillar.

Original station mark found/~~not found~~.

Description of mark: **BRICKS TRIP, 1000, 100, 100, 100**

Original beacon found/~~not found~~.

Description of beacon: **WARRINGHEAD P.D. TRAVEL TOWARDS BELMONT**

Height Top of Vanes to Top Mark: **A. 100**

Height of mark: **100** above ~~below~~ conc./conc. **500** m. below G.L.

Diameter of Vanes: **760** m.

Original Beacon has/~~has not~~ been destroyed by me.

Date	Record of Station

CENTRAL MAPPING AUTHORITY

GEODETIC SURVEY OF N.S.W.

GEODETIC STATION RECONNAISSANCE and MAINTENANCE REPORT

Description:

1. Cleared by lanes bearing.....
 Note: Cross out word or words which do not apply

2. Mast & Vanes have been painted white & black respectively.

3. The station/pillar was unpiled/not unpiled/constructed on..... 19....., dimensions now being:

Description of mark..... should be explicit, e.g., S/Steel Pillar Plate, Steel plug, Brass plug, Bolt, G.I. Pipe

Height of mark.....m, above below rock/concrete; Mark is.....m, above below G.L.

Height of Top Vanes to Top Mark/Pillar plate.....m. Diameter of Vanes (vertical).....m.

Height of Cairn.....m. Diameter of Cairn.....m. Name Plate found/not found/placed.

Length of Mast.....m. (approximate if not supplied)

4. A.....set in conc/rock has been placed/found, bearing.....° M from Mast/Plug/Pillar

5. A.....set in conc/rock has been placed/found, bearing.....° M from Mast/Plug/Pillar

6. A.....set in conc/rock has been placed/found, bearing.....° M from Mast/Plug/Pillar

7. A.....set in conc/rock has been placed/found, bearing.....° M from Mast/Plug/Pillar

8. Action required:.....

STANDPOINT:

STANDPOINT:

Mark	Direction	Horiz. Distance	Height Difference	Mark	Direction	Horiz. Distance	Height Difference
			above standpt				above standpt
			below standpt				below standpt
			above standpt				above standpt
			below standpt				below standpt
Prepared by: *v. v. v.*

Checked: *v. v. v.*

17/13/20

Noted on U.T.M. Card

S: 2733-1

Checked

STATION: ANDERSONS SUGARLOAF LSP No.: 6387
 MAPSHEET SCALE 1:250 000
 INSPECTED BY: C. ZANKA
 AUTHORITY: LMA
 DATE: Nov '79
 FIELD BOOK: Access of 25.79
 Error (1000 Log)

