


TS 6398  
No: 4073

STATION: SHEA G. S.

MAP SHEET  
SCALE 1:250 000 DARRIGG

INSPECTED BY: D FREDRIKSEN DATE: 4/8/79

AUTHORITY: C. M. A. FIELD BOOK: 1764

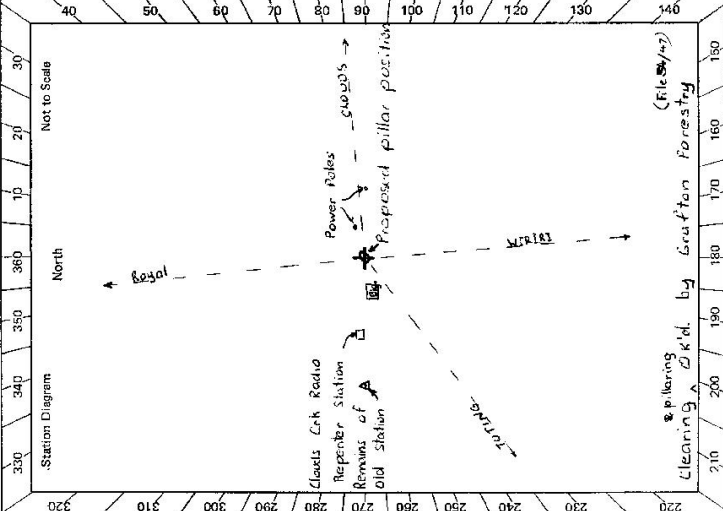

CENTRAL MAPPING AUTHORITY  
GEODETTIC SURVEY OF N.S.W.  
GEODETTIC STATION RECONNAISSANCE and MAINTENANCE REPORT

Description:  
Note: Cross out word or words which do not apply

1. Cleared by lanes bearing *black*.....*2. black*.....*4. lanes*..... from Trig. Mast
2. Mast & Vanes have been painted white & black respectively.
3. The station/pillar was unpiled/not unpiled/constructed on..... 19....., dimensions now being:  
Description of mark.....should be explicit, e.g., S/Steel Pillar Plate, Steel plug, Brass plug, Bolt, G.I. Pipe  
Height of mark.....m. <sup>above</sup> rock/concrete; Mark is.....m. <sup>above</sup> G.L.  
Height of Top Vanes to Top Mark/Pillar plate.....m. Diameter of Vanes (vertical).....m.  
Height of Cairn.....m. Diameter of Cairn.....m. Name Plate found/not found/placed.  
Length of Mast.....m. (approximate if not unpiled)
4. A.....set in conc/rock has been placed/found, bearing.....° M from Mast/Plug/Pillar
5. A.....set in conc/rock has been placed/found, bearing.....° M from Mast/Plug/Pillar
6. A.....set in conc/rock has been placed/found, bearing.....° M from Mast/Plug/Pillar
7. A.....set in conc/rock has been placed/found, bearing.....° M from Mast/Plug/Pillar
8. Action required:.....*4. lanes*.....*5. cleared*.....*See Note on U.T.M. Card*

STANDPOINT:			
Mark	Direction	Horiz. Distance	Height Difference
			above standpt.
			below
			above standpt.
			below
Prepared by: D. FREDRIKSEN 10/8/79 Checked: *W. J. ... 24/8/79* Noted on U.T.M. Card

61

St 2733-2 D. West, Government Printer

Beacon Diagram	Not to Scale	
<p style="text-align: center;">STATION SHEP C.S. TS 6398</p> <p>Owner's Name: SHEP, KNOR, STIE FOREST                      Address: FORESTY COMMUNISSI...                      Phone: GRAFTON</p> <p>Current Occupant: .....                      Address: .....                      Phone: .....</p> <p>ACCESS 4-8-1979</p> <p>Access Report of 19 was found suitable/suitable.</p> <p><u>FEATURE</u></p> <p>0.4 AT CLOUDS CREEK FORESTRY CAMP 67 km from GRAFTON &amp; 134 km from                      ARMADALE heading north towards Grafton.                      1.1 Bridge over Clouds Creek                      1.5 End of bitumen                      3.6 Turn LEFT along dirt road. Track to right Deadman Range Rd SP                      At Trig on L.N.S. of road near repeater station</p> <p>Note: 1 or 2 lanes should be cleaned before constructing the                      pillar to ensure there is no interference from surrounding                      structures.</p>		
<p>This section to be completed by officer constructing pillar.</p> <p>Original station mark found/not found.</p> <p>Description of mark: .....</p> <p>Original beacon found/not found.</p> <p>Description of beacon: .....</p> <p>Height Top of Vanes to Top Mark: .....m.</p> <p>Height of mark: .....m. above rock/conc .....m. below G.L.</p> <p>Diameter of Vanes .....m. Height of Cairn .....m.</p> <p>Original Beacon has/has not been destroyed by me.</p>		
	Date	
	Record of Station	



G:

STATION <b>SHEA G.S. (PILLAR) TS 6398</b>	Owner's Name: <b>SHEAS KING STATE FOREST</b> Address: <b>GRAFTON</b> Phone: ..... Current Occupant: ..... Address: ..... Phone: ..... ACCESS <b>2-10-1999</b> Access Report of: /10 ..... found suitable/unusable.
Beacon Diagram Not to Scale 	This section to be completed by officer constructing pillar. Original station mark found/ <del>not found</del> . Description of mark: <b>CART. RIDGE CASE IN ROCK</b> Original beacon found/ <del>not found</del> . Description of beacon: ..... Height Top of Vanes to Top Mark: ..... m. Height of mark: <b>0.02</b> / above rock/ <del>some</del> <b>3.00</b> / above / below G.L. Diameter of Vanes: ..... m. Height of Cairn: ..... m. Original Beacon <del>has</del> /has not been destroyed by me.
KMS / 0.0 / 0.4 / 1.1 / 1.5 / 3.6	AT CLOUDS CREEK FORESTRY CAMP 67km FROM GRAFTON 134km FROM ARNIDALE HEADING NORTH TOWARDS GRAFTON BRIDGE OVER CLOUDS CREEK END OF BITUMEN TURN LEFT ALONG DIRT ROAD (TRACK TO DEAD MAN'S RANGE R.H.S.) AT TRIG ON L.H.S. NEAR REPEATER STATION
Date	Record of Station