



STATIONTS 5976 WAKKA(P) 6418


Current Occupant.....

Owners Name... F. Farrell

Address... NADGEE NATIONAL MAPPING


Access... Site also National Mapping Summary 6-5-1978

Ac 6:55,000, NADGEE

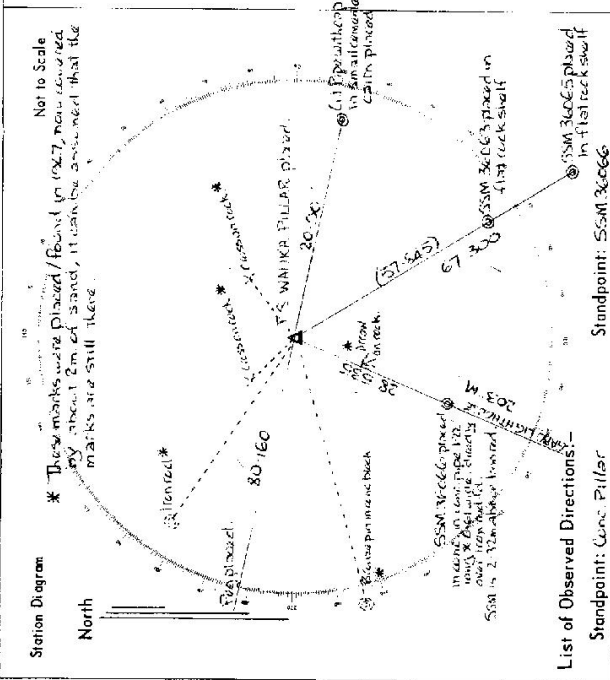

List of Observed Directions:-

Standpoint: CONE PILLAR		
Station	Direction	Station
PE5	282° 30' 22.0	T'S WAKKA (P)
T'S CAROLINE LIGHTHOUSE	203° 00' 00.0	T'S WAKKA (P)
G.P.PE	102° 47' 20.0	T'S WAKKA (P)
SSM 36065	148° 44' 29.7	T'S WAKKA (P)
SSM 36065	148° 44' 11.6	T'S WAKKA (P)
Standpoint: T85		
Station	Direction	Station
SSM 36066	203° 07' 21.0	T'S ALLAN (P)
		T'S CAROLINE (P)
		T'S WAKKA (P)
		T'S CAROLINE LIGHTHOUSE

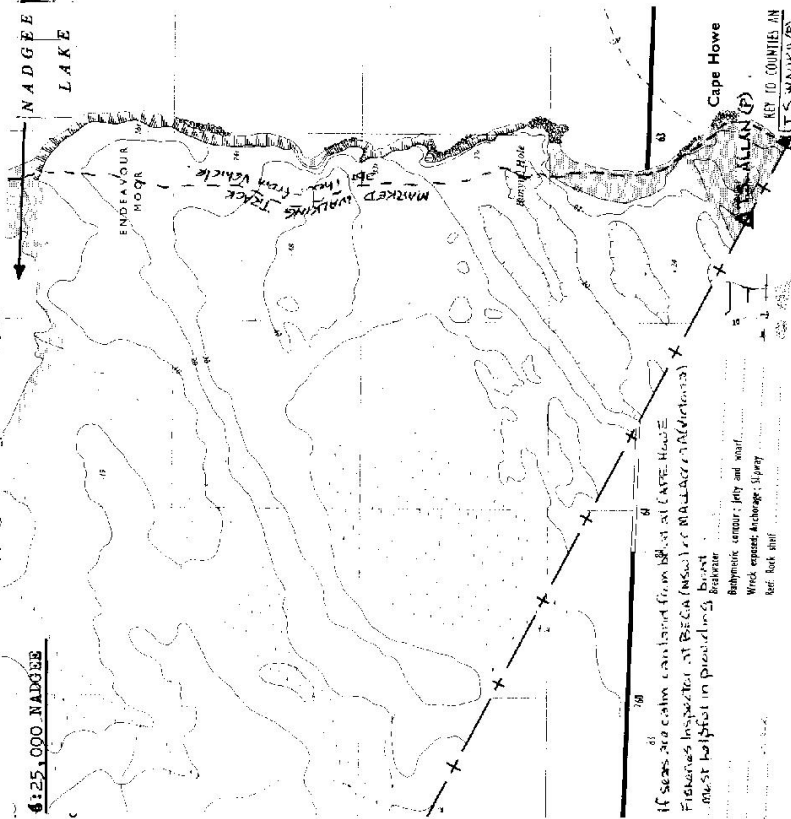

CAPE HOWE (P)  
REF TO COASTS AN  
REF TO COASTS AN  
REF TO COASTS AN