

STATION ~~SECRET~~ LOCKERBY (P) TS 6421

Owner Name: TONY WALKINSOJA

Current Occupant: T. WALKINSOJA


Address: SOUTH VALLEY

Address


ASHFORD - EMMANVILLE RD

30-3-1919

Access From ASHFORD RD (0.0 km) TRAVEL TOWARDS BOONSHAW TAKING RIGHT TURN TO EMMANVILLE (JUST BEYOND SEVERAL RIVER BRIDGE) TRAVEL TO LEFT TURN INTO SOUTH VALLEY (SIGNPOST) AT 17.6 km. FOLLOW MAIN TRACK FOR 3.7 km TO TURN ON LEFT. TAKE RIGHT TURN THROUGH GATE FOR 1.0 km TO TRACK ON LEFT. FOLLOW THE TRACK NORTH FOR APPROX. 1.5 km. FROM HERE VEER LEFT AND WORK WAY UP AND AROUND CLEAR ROCKY RIDGE TO TS. AT A FURTHER 1.6 km (ROUTE CAN DRIVE IN FOR F100)

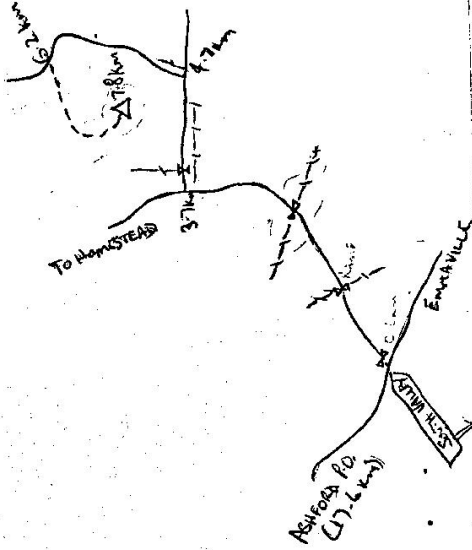

Not to Scale

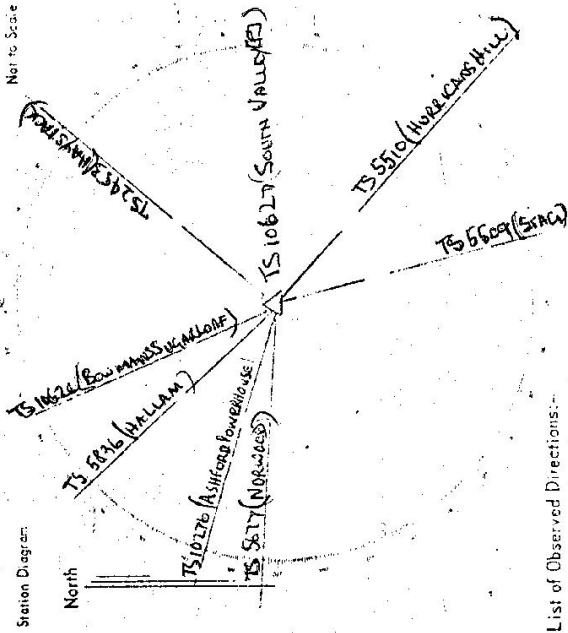

List of Observed Directions:-

Station	Direction	Station	Direction
ASHFORD TS	1651200	HALLAM TS	3161625
BOONSHAW & LONE (P)	3350000	ASHFORD POWERHOUSE (RES)	2865054
HOBBS HILL TS	1333738		
NORTH HILL TS	2335445		

Standpoint: South Valley Hallam

TS 6421

GEODETTIC SURVEY OF N.S.W.

CENTRAL MAPPING AUTHORITY

GEODETTIC STATION RECONNAISSANCE and MAINTENANCE REPORT

STATION: **LOCKERBY (P)** No.: **Lands Dept**

MAP SHEET SCALE 1:250 000

INSPECTED BY: **J. Sherwin** DATE: **JUL 1979**

AUTHORITY: **C.M.A.** FIELD BOOK:

INVERELL

Note: Cross out word or words which do not apply

1. Cleared by lanes bearing..... from Trig. Mast

2. Mast & Vanes have been painted white & black respectively.

3. The station/pillar was ~~replaced~~ constructed on..... 19....., dimensions now being:

Description of marks: ~~Steel~~ **Steel** should be explicit, e.g., S/Steel Pillar Plate, Steel plug, Brass plug, Bolt, G.I. Pipe

Height of mark.....m. ^{above} ~~below~~ rock/concrete; Mark is.....m. ^{above} ~~below~~ G.L.

Height of Top Vanes to Top Mark/Pillar plate.....m. Diameter of Vanes (vertical).....m.

Height of Cairn.....m. Diameter of Cairn.....m. Name Plate found/not found/placed.

Length of Mast.....m. (approximate if not unplied)


4. A.....set in conc/rock has been placed/found, bearing.....°M from Mast/Plug/Pillar

5. A.....set in conc/rock has been placed/found, bearing.....°M from Mast/Plug/Pillar

6. A.....set in conc/rock has been placed/found, bearing.....°M from Mast/Plug/Pillar

7. A.....set in conc/rock has been placed/found, bearing.....°M from Mast/Plug/Pillar

8. Action required:.....

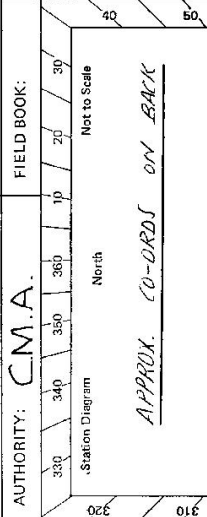

Mark	Direction	Horiz. Distance	Height Difference	Mark	Direction	Horiz. Distance	Height Difference
			above standpt.				above standpt.
			below standpt.				below standpt.
			above standpt.				above standpt.
			below standpt.				below standpt.
STANDPOINT:

Prepared by:.....

Checked:.....

Noted on U.T.M. Card

S: 2733-1

Sr 2739-2 D. West, Government Printer

<p>Beacon Diagram</p> <table border="1" style="width: 100%; border-collapse: collapse;"> <tr> <td style="width: 10%; text-align: center;">E</td> <td style="width: 10%; text-align: center;">N</td> <td style="width: 10%; text-align: center;">W</td> <td style="width: 10%; text-align: center;">S</td> <td style="width: 10%; text-align: center;">NE</td> <td style="width: 10%; text-align: center;">NW</td> <td style="width: 10%; text-align: center;">SW</td> <td style="width: 10%; text-align: center;">SE</td> </tr> <tr> <td style="text-align: center;">3</td> <td style="text-align: center;">3</td> <td style="text-align: center;">5</td> <td style="text-align: center;">0</td> <td style="text-align: center;">6</td> <td style="text-align: center;">7</td> <td style="text-align: center;">5</td> <td style="text-align: center;">7</td> </tr> <tr> <td style="text-align: center;">1</td> <td style="text-align: center;">3</td> <td style="text-align: center;">5</td> <td style="text-align: center;">0</td> <td style="text-align: center;">6</td> <td style="text-align: center;">7</td> <td style="text-align: center;">5</td> <td style="text-align: center;">7</td> </tr> <tr> <td style="text-align: center;">0</td> <td style="text-align: center;">0</td> <td style="text-align: center;">0</td> <td style="text-align: center;">0</td> <td style="text-align: center;">0</td> <td style="text-align: center;">0</td> <td style="text-align: center;">0</td> <td style="text-align: center;">0</td> </tr> </table> <p>331 345 675 7039</p>	E	N	W	S	NE	NW	SW	SE	3	3	5	0	6	7	5	7	1	3	5	0	6	7	5	7	0	0	0	0	0	0	0	0	<p>Not to Scale</p> <p>A Approx Coordinates</p> <p>by resection 52-11-19</p>	<p>STATION SOUTH VALLEY LOCKERBY</p> <p>TS 6421</p>	<p>Owner's Name:</p> <p>Address: SOUTH VALLEY</p> <p>Phone:</p>	<p>Current Occupant:</p> <p>Address:</p> <p>Phone:</p>	<p>ACCESS</p> <p>Access Report of 1/19/19 was found suitable/unsuitable.</p>		<p>Date</p> <p>Record of Station</p>
E	N	W	S	NE	NW	SW	SE																																
3	3	5	0	6	7	5	7																																
1	3	5	0	6	7	5	7																																
0	0	0	0	0	0	0	0																																
<p>This section to be completed by officer constructing pillar.</p> <p>Original station mark found/not found.</p> <p>Description of mark:</p> <p>Original beacon found/not found.</p> <p>Description of beacon:</p> <p>Height Top of Vanes to Top Mark.....m.</p> <p>Height of mark.....m. above rock/cone.....m. below G.L.</p> <p>Diameter of Vanes.....m. Height of Cairn.....m.</p> <p>Original Beacon has/has not been destroyed by me.</p>																																							

CENTRAL MAPPING AUTHORITY

GEODETTIC SURVEY OF N.S.W.
GEODETTIC STATION RECONNAISSANCE and MAINTENANCE REPORT

- Description: *Note: Cross out word or words which do not apply*
1. Cleared by fanes bearing..... 360° from Trig. Mast
 2. Mast & Vanes have been painted white & black respectively.
 3. The station/pillar was unpiled/~~not unpiled~~/~~constructed~~ on..... $23/7/1982$ dimensions now being: Description of mark *S. Pillar* should be explicit, e.g., S/Steel Pillar Plate, Steel plug, Brass plug, Bolt, G.I. Pipe
Height of mark..... m. above rock/concrete; Mark is..... m. above G.L.
Height of Top Vanes to Top Mark/Pillar plate..... m. Diameter of Vanes (vertical)..... m.
Height of Cairn..... m. Diameter of Cairn..... m. Name Plate found/not found/placed.
Length of Mast..... m. (approximate if not unpiled)
 4. A..... set in conc/rock has been placed/found, bearing..... $^\circ$ M from Mast/Plug/Pillar
 5. A..... set in conc/rock has been placed/found, bearing..... $^\circ$ M from Mast/Plug/Pillar
 6. A..... set in conc/rock has been placed/found, bearing..... $^\circ$ M from Mast/Plug/Pillar
 7. A..... set in conc/rock has been placed/found, bearing..... $^\circ$ M from Mast/Plug/Pillar
 8. Action required: *Paint Pillar, Place SATELLITE MARKS*.....


STANDPOINT:

Mark	Direction	Horiz. Distance	Height Difference	Mark	Direction	Horiz. Distance	Height Difference
			above standpt.				above standpt.
			below				below
			above standpt.				above standpt.
			below				below
Prepared by: *Abby Garside* 8/11/82 Checked: *Checked*

SI 2735-1

Noted on U.T.M. Card

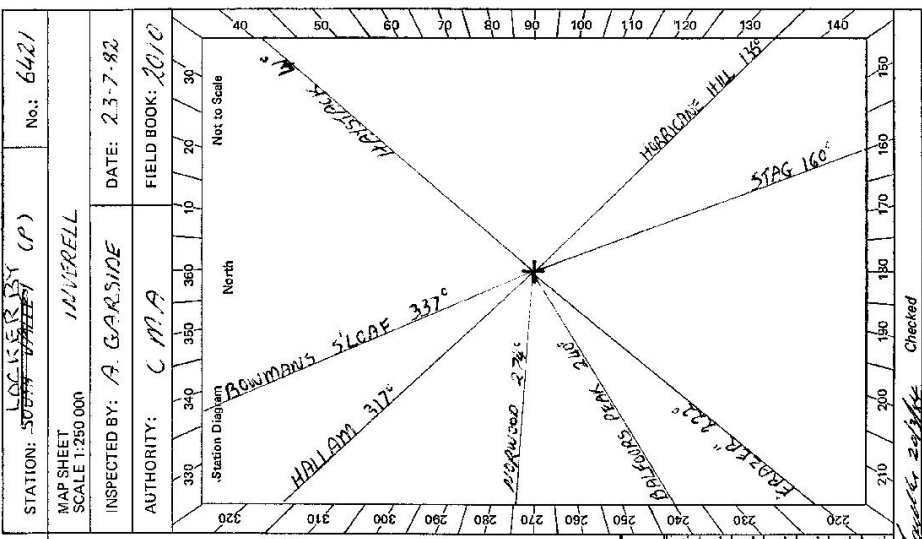

STATION: ~~SOUTH~~ LOCKERBY (P) No.: 6421
MAP SHEET INVERELL
SCALE 1:250 000
INSPECTED BY: A. GARSIDE DATE: 23-7-82
AUTHORITY: C.M.A. FIELD BOOK: 2010

STATION SOUTH VALLEY LOCKERBY (P) TS 6421


Owner's Name: DE. M. A. RETALAKA
 Address: SOUTH VALLEY
 Phone: ASHFORD 55

Current Occupant:
 Address:
 Phone:

ACCESS

Access Report of 16/1985 was found suitable/unsuitable.

- 0.00 ASHFORD P.O. HEAD NORTH
- 0.2 TURN LEFT
- 0.4 TURN RIGHT
- 3.5 TURN RIGHT TOWARDS BOWSHAW & TEXAS
- 4.9 TURN RIGHT TOWARDS "EMMAVILLE 60"
- 16.7 PASS ROAD ON RIGHT
- 17.5 TURN LEFT OVER GRD SIGN '3 SOUTH VALLEY RD'
- 19.8 GRID
- 21.15 TURN RIGHT FOLLOWER LIVES ALONG TRACK STRAIGHT AHEAD TAKE RIGHT FORK ABOUT 1 KM FURTHER ON)
- 21.4 DOUBLE IRON GATES
- 22.2 TURN LEFT THROUGH WIRE GATE OPPOSITE WOODY IRON GATE
- 23.55 TURN LEFT JUST BEFORE DOUBLE IRON GATE AND FOLLOW FENCE
- 24.0 WIRE GATE MAKE OWN WAY UP HILL ON LEFT TO TRIG
- 24.5 SOUTH VALLEY G.S.

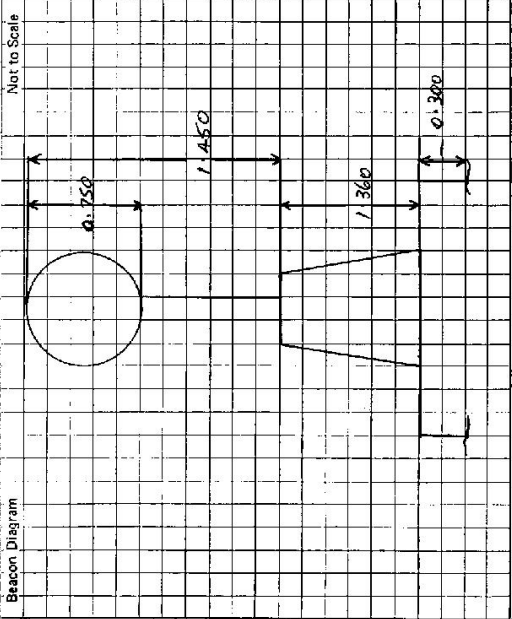

This section to be completed by officer constructing pillar.

Original station mark found/not found.

Description of mark:

Original beacon found/not found.

Description of beacon:

Height Top of Vanes to Top Mark:m.

Height of mark:m. above G.L. below

Diameter of Vanesm.

Original Beacon has/has not been destroyed by me.

Date	Record of Station