

CENTRAL MAPPING AUTHORITY

GEODETIC SURVEY OF N.S.W.

GEODETIC STATION RECONNAISSANCE and MAINTENANCE REPORT

Description:

Note: Cross out word or words which do not apply

- Cleared by James bearing... from Trig. Mast
- Mast & Vanes have been painted white & black respectively.
- The station/pillar was unpiled/not unpiled/constructed on... dimensions now being:
  - Description of mark: ...
  - Height of mark: ...m. above rock/concrete; Mark is ...m. above G.L.
  - Height of Top Vanes to Top Mark/Pillar plate ...m. Diameter of Vanes (vertical).....m.
  - Height of Cairn.....m. Diameter of Cairn.....m. Name Plate found/not found/placed.
  - Length of Mast.....m. (approximate if not unpiled)
- A.....set in conc/rock has been placed/found, bearing.....° M from Mast/Plug/Pillar
- A.....set in conc/rock has been placed/found, bearing.....° M from Mast/Plug/Pillar
- A.....set in conc/rock has been placed/found, bearing.....° M from Mast/Plug/Pillar
- A.....set in conc/rock has been placed/found, bearing.....° M from Mast/Plug/Pillar
- Action required... New station established if required

STANDPOINT: Visible stations

Mark	Approx. Elev. Brg.	Horiz. Distance	Height Difference	Mark	Direction	Horiz. Distance	Height Difference
WILIRI	255'	13 km	above standpt.	CAMPION	191	17 km	above standpt.
SHEA	294'	15 "	above standpt.				above standpt.
CLOUDS	315'	10 "	above standpt.				above standpt.
JESSE SMITH	49	7 "	above standpt.				above standpt.
MOONBL	154	22 "	above standpt.				above standpt.
TUTING	267	23 "	above standpt.				above standpt.
MOLETON	38	14 "	above standpt.				above standpt.

Prepared by: D. Fredrikson 24/10/79 Checked:

Noted on U.T.M. Card

SI 2738-1


FLAGGY G.S.(R)

STATION: 6426 MAPS HAT No.: 6426

MAP SHEET SCALE 1:250 000 DORRIGOO

INSPECTED BY: D. FREDRIKSEN DATE:

AUTHORITY: C.M.A. FIELD BOOK:

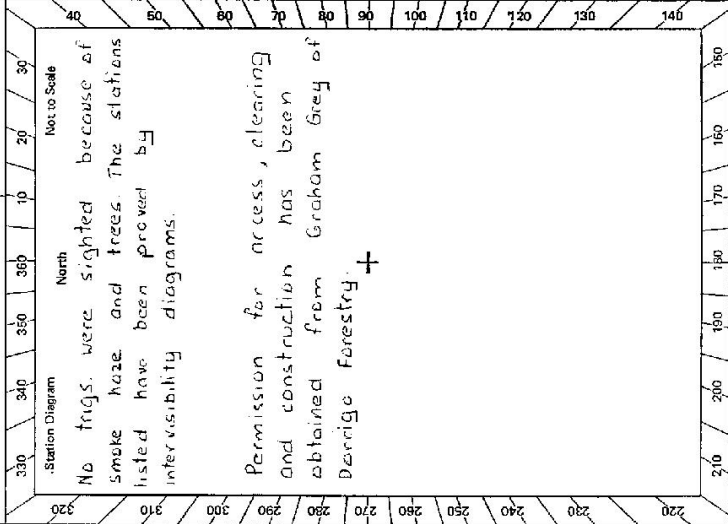

Checked

61 2733-2 D. West, Government Printer

STATION OLD MANS HAT (P) JS 6426

<p>Owner's Name: Wild Cattle Creek State Forest                  Address: DERRIGO FORESTRY COMMISSION                  Phone: .....                  Current Occupant: .....                  Address: .....                  Phone: .....</p>	<p>ACCESS                  Report of [unclear] was found suitable/unsuitable.                  Feature                  CASCADE PD heading North. (Cascade is 20km North of DORRIGO)                  Turn LEFT along Moses Road Forest Rd on R.H.S.                  Pass "Measuring Hut Forest Rd" on R.H.S.                  Veer RIGHT at "Wattle Flat Forest Rd"                  Turn RIGHT along "Orange Trees Forest Rd"                  Pass "Mabong Forest Rd" on R.H.S.                  Pass Turn off to Cascade GS. on R.H.S.                  Pass "Mines Rd" on R.H.S.                  Pass "Pine Rd" on R.H.S.                  Pass "Forked Rd" on R.H.S.                  Pass a small knob on L.H.S.                  Veer RIGHT off track just before it goes down hill and head along top of ridge in N.N.E. direction for about 150m to spot suitable for trig station</p> <p>Easy 2WD access</p>
--	---

Date	Record of Station

Beacon Diagram

Not to Scale							

This section to be completed by officer constructing pillar.

Original station mark found/not found. ....

Description of mark: ....

Original beacon found/not found. ....

Description of beacon: ....

Height Top of Vanes to Top Mark: .....m.

Height of mark: .....m. above G.L.      .....m. below

Diameter of Vanes: .....m.      Height of Cairn: .....m.

Original Beacon has/has not been destroyed by me.

GEODETTIC SURVEY OF N.S.W.

CENTRAL MAPPING AUTHORITY

**GEODETTIC STATION RECONNAISSANCE and MAINTENANCE REPORT**

**STATION:** FLAGG 73 No.: 6426  
*Base: Pillars Mast (Concrete)*

**MAP SHEET:** Doubled  
 SCALE: 1:250 000

**INSPECTED BY:** L. J. HARRIS **DATE:** 12th December '14

**AUTHORITY:** Central Mapping Authority **FIELD BOOK:** 1471

- Description:**  
 Note: Cross out word or words which do not apply
1. Cleared by lances bearing... ~~31° 40' 37\"~~... ~~54° 46' 50\"~~... ~~133° 46' 19\"~~... ~~302° 40' 31\"~~... from Trig. Mast
  2. Mast & Vanes have been painted white & black respectively. ✓
  3. The station/pillar was ~~unplaced/not unplaced~~/constructed on... ~~211.10m~~... dimensions now being:  
 Description of mark... ~~None~~... should be explicit, e.g., S/Steel Pillar Plate, Steel plug, Brass plug, Bolt, G.I. Pipe  
 Height of mark... ~~1.1216~~... m. <sup>above</sup> ~~rock/concrete~~; Mark is... ~~1.850~~... m. <sup>above</sup> G.L. ✓  
 Height of Top Vanes to Top ~~Mark~~/Pillar plate ... ~~1.400~~... m. Diameter of Vanes (vertical)... ~~750~~... m.  
 Height of Cairn... ~~211.10~~... m. Diameter of Cairn... ~~150~~... m. Name Plate found/not found/placed.  
 Length of Mast... ~~1.1216~~... m. (approximate if not unplaced)
  4. A... ~~Cairn~~... set in conc/~~rock~~ has been placed/~~found~~, bearing... ~~302~~... M from ~~Mark~~/Pillar
  5. A... ~~Cairn~~... set in conc/~~rock~~ has been placed/~~found~~, bearing... ~~138~~... M from ~~Mark~~/Pillar
  6. A... ~~Cairn~~... set in conc/~~rock~~ has been placed/~~found~~, bearing... ~~138~~... M from Mast/Plug/Pillar
  7. A... ~~Cairn~~... set in conc/~~rock~~ has been placed/~~found~~, bearing... ~~138~~... M from Mast/Plug/Pillar
  8. Action required:.....

Mark	Direction	Horiz. Distance	Height Difference	Mark	Direction	Horiz. Distance	Height Difference
<u>Cairn P</u>	<u>0 00 40</u>		<u>above standpt.</u>	<u>Cairn P</u>	<u>0 00 40</u>		<u>above standpt.</u>
<u>Jessie Smith P</u>	<u>94 36 70</u>		<u>above standpt.</u>	<u>Jessie Smith P</u>	<u>94 27 10</u>		<u>above standpt.</u>
<u>G.I. Pipe</u>	<u>218 21 40</u>	<u>3.802</u>	<u>above standpt.</u>	<u>Pillar Mast</u>	<u>174 57 30</u>	<u>2.592</u>	<u>above standpt.</u>
<u>Cairn Mast</u>	<u>357 58 00</u>	<u>2.516</u>	<u>below standpt.</u>	<u>C. Pipe</u>	<u>203 19 30</u>	<u>below</u>	<u>below standpt.</u>
			<u>above standpt.</u>				<u>above standpt.</u>
			<u>below standpt.</u>				<u>below standpt.</u>
			<u>above standpt.</u>				<u>above standpt.</u>
			<u>below standpt.</u>				<u>below standpt.</u>

STANDPOINT: Pillar Mast      STANDPOINT: Cairn Mast

Prepared by: \_\_\_\_\_      Checked: \_\_\_\_\_

Noted on U.T.M. Card

SR 2733-2 D. West, Government Printer

<p>Beacon Diagram</p>	<p>STATION <u>D. S. Vane's Hat (S) TS 6426</u></p> <p>Owner's Name: .....</p> <p>Address: .....</p> <p>Phone: .....</p> <p>Current Occupant: <u>Fernando Amador Nino</u></p> <p>Address: <u>D. S. Vane's Hat</u></p> <p>Phone: <u>12-12-1979</u></p> <p>ACCESS <u>12-12-1979</u></p> <p>Access Report of <u>12/12/19</u> <u>was found suitable/unavailable.</u></p> <p>Notes:</p> <p>0000 Doubtful P.O. Team Not to Contact</p> <p>1300 P.O. Team found at Public Market on R.H.S.</p> <p>1400 Cross Used Camp Level</p> <p>1630 Twp Left Side Camp</p> <p>1635 Twp R.H. Side</p> <p>1840 Bikes with Saw Mill on Left</p> <p>1845 A Fenced 2 Kilometers to Camp (D)</p> <p>0000 Camp P.O. Team Not</p> <p>0730 Twp Left Side Near Rock Forest on</p> <p>340 Twp R.H. Side Near Welcome Flat Forest on</p> <p>550 Twp Left Side Outside Forest Forest on</p> <p>1545 Twp Left Side</p> <p>1600 Ground Station</p>	<p>Date</p> <p>Record of Station</p>
<p>This section to be completed by officer constructing pillar.</p> <p>Original station mark found/not found. <u>Not Station</u></p> <p>Description of mark: .....</p> <p>Original beacon found/not found.</p> <p>Description of beacon: .....</p> <p>Height Top of Vanes to Top Mark .....m.</p> <p>Height of mark .....m. above G.L. below</p> <p>Diameter of Vane .....m. Height of Cairn .....m.</p> <p>Original Beacon has/has not been destroyed by me.</p>		

Tous Visibles No:

Jesse Summit 55'  
 Mount of 84  
 Mount of 113  
 Beacon of 161  
 Mount of 174  
 Mount of  
 Clouds of 304