

CENTRAL MAPPING AUTHORITY

GEODETIC SURVEY OF M.S.W.

GEODETIC STATION RECONNAISSANCE and MAINTENANCE REPORT

- Description: *Note: Cross out word or words which do not apply*
- Cleared by lanes bearing..... from Trig. Mast
 - Mast & Vanes have been painted white & black respectively.
 - The station/pillar was unpiled/not unpiled/constructed on.....19....., dimensions now being: Description of mark.....should be explicit, e.g., S/Steel Pillar Plate, Steel plug, Brass plug, Bolt, G.I. Pipe
Height of mark.....m. ^{above} rock/concrete; Mark is.....m. ^{above} G.L.
 - Height of Top Vanes to Top Mark/Pillar plate.....m. Diameter of Vanes (vertical).....m.
 - Height of Cairn.....m. Diameter of Cairn.....m. Name Plate found/not found/placed.
 - Length of Mast.....m. (approximate if not unpiled)
 - A.....set in conc/rock has been placed/found, bearing.....°M from Mast/Plug/Pillar
 - A.....set in conc/rock has been placed/found, bearing.....°M from Mast/Plug/Pillar
 - A.....set in conc/rock has been placed/found, bearing.....°M from Mast/Plug/Pillar
 - A.....set in conc/rock has been placed/found, bearing.....°M from Mast/Plug/Pillar
 - Action required:.....

STANDPOINT:

| Mark | Direction | Horiz. Distance | Height Difference | Mark | Direction | Horiz. Distance | Height Difference |
|------|-----------|-----------------|-------------------|------|-----------|-----------------|-------------------|
| | | | above standpt. | | | | above standpt. |
| | | | below | | | | below |
| | | | above standpt. | | | | above standpt. |
| | | | below | | | | below |
Prepared by: *Checked*


St 2733-1

STATION: JESSE SMITH S.S. TS No.: 6431

MAP SHEET SCALE 1:250 000 DORRIGOLD 1:100,000

INSPECTED BY: R. COOK DATE: 1-3-78

AUTHORITY: C.M.A. FIELD BOOK:
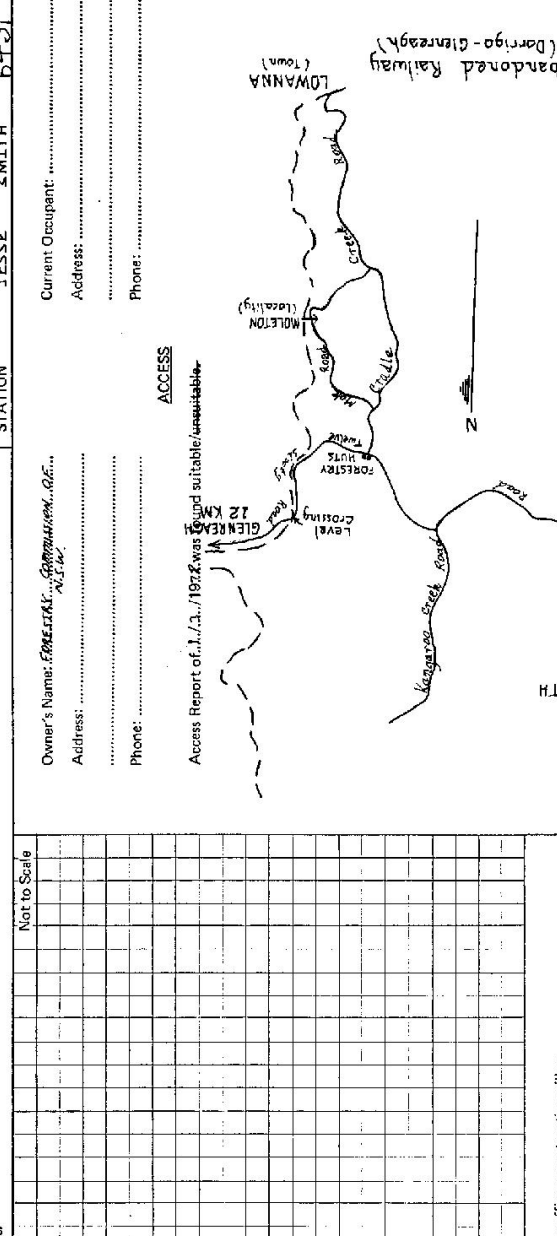
| | | | |
|--|---|---|--|
| SK 2735-2 D. West, Government Printer Beacon Diagram Not to Scale | STATION JESSE SMITH TS 6431 | Owner's Name: EMMETT G. FORESTAL, GLENKERRIE, N.S.W. Address: Phone: Current Occupant: Address: Phone: ACCESS Access Report of 1.1.1. / 1972 was found suitable / unsuitable .  | |
| This section to be completed by officer constructing pillar. Original station mark found/not found. Description of mark: Original beacon found/not found. Description of beacon: Height Top of Vanes to Top Mark m. Height of mark m. above G.L. / below Diameter of Vanes m. Height of Cairn m. Original Beacon has/has not been destroyed by me. | | Date 1-3-78 | Record of Station Common, Park, and Abney Full Access To, via, Kinkilly Road, to the North and East. |

St 2733-2 D. West, Government Printer

| | | |
|--------------------|---------------------------------|--|
| Beacon Diagram | STATION JESSE SMITH G S IS 6431 | Owner's Name: RANGAROD RIVER STATE FOREST Current Occupant: Address: WLONG Sub district Address: Phone: 01-foresting Commission Phone: Phone: 0065 HARBOUR Phone: ACCESS 13-8-1979 . Access Report of/10.....was found suitable/in suitable. Feature Golden Dog Hotel, GLENREAGH. heading north towards GRAFTON 0.4 Turn LEFT towards 'Tailo wadjah, Molebn, Lowana, Dorrigo, 2.0 did railway crossing. 8.5 Turn RIGHT along 'TWELVE SIXTY FOREST RD' and keep on main roads. 15.3 on main railway crossing. 18.2 keep on 'BLACK MTN. FOREST RD'. Dorrigo is 50 km from here. 20.6 Veer LEFT along 'BLACK MTN. FOREST RD' 27.8 Veer RIGHT along 'JESSIE SMITH FOREST RD.' 28.6 Veer LEFT up hill 28.9 fit Trig and fire tower. |
| | | Date Record of Station |

This section to be completed by officer constructing pillar.

Original station mark found/not found.
 Description of mark:
 Original beacon found/not found.
 Description of beacon:m.
 Height Top of Vanes to Top Markm.
 Height of markm. above G.L. below G.L.
 Diameter of Vanesm. Height of Cairnm.
 Original Beacon has/has not been destroyed by me.

GEODETTIC SURVEY OF N.S.W.

CENTRAL MAPPING AUTHORITY

GEODETTIC STATION RECONNAISSANCE and MAINTENANCE REPORT

Description:

1. Cleared by lanes bearing $128^{\circ} 46' 51''$, $173^{\circ} 11' 13''$, $196^{\circ} 01' 29''$, $292^{\circ} 34' 09''$, $345^{\circ} 28' 55''$ from Trig. Mast
 Note: Cross out word or words which do not apply
2. Mast & Vanes have been painted white & black respectively.
3. The station/pillar was ~~unplaced~~ ~~not unplaced~~ /constructed on 27.10 dimensions now being:
 S/Steel Plate
 Description of mark 19.79 should be explicit, e.g., S/Steel Pillar Plate, Steel plug, Brass plug, Bolt, G.I. Pipe
 Height of mark 3.75 m. above ~~mark~~ ~~below~~ concrete; Mark is 1.545 m. above G.L.
 Height of Top Vanes to Top ~~mark~~ /Pillar plate 1.45 m. Diameter of Vanes (vertical) 0.756 m.
 Height of Cairn 0.45 m. Diameter of Cairn 0.45 m. Name Plate ~~found~~ ~~not found~~ /placed.
 Length of Mast 0.45 m. (approximate if not unplaced)
4. ~~Conc. Mark~~ set in conc/~~mark~~ has been placed/~~found~~, bearing 172° from ~~mark~~ /Pillar
5. ~~A. TRIG PILE~~ set in conc/~~mark~~ has been placed/~~found~~, bearing 217° from ~~mark~~ /Pillar
6. ~~A.~~ set in conc/~~mark~~ has been placed/~~found~~, bearing 0° from Mast/~~mark~~ /Pillar
7. ~~A.~~ set in conc/~~mark~~ has been placed/~~found~~, bearing 0° from Mast/~~mark~~ /Pillar
8. Action required: ~~Conc. Obs. Pile~~

STANDPOINT: ~~Conc. Obs. Pile~~

STANDPOINT: ~~BRASS TRIG PILE~~


| Mark | Direction | Horiz. Distance | Height Difference | Mark | Direction | Horiz. Distance | Height Difference |
|--------------------|-----------|-----------------|-------------------|--------------------|-----------|-----------------|-------------------|
| GEORGES KNOB G.S. | 0 00 00 | | standpt. above | GEORGES KNOB G.S. | 0 00 00 | | standpt. above |
| KOURANDOWNE G.S. | 44 24 00 | | standpt. above | KOURANDOWNE G.S. | 44 23 10 | | standpt. above |
| CONC. MARK IN CONC | 206 01 20 | 3 888 | standpt. below | CONC. OBS. PILLAR | 71 56 05 | 4 026 | standpt. above |
| BRASS TRIG PILE | 251 58 30 | 4 025 | standpt. below | CONC. MARK IN CONC | 126 37 50 | 3 090 | standpt. above |
| | | | standpt. below | | | | standpt. below |
| | | | standpt. above | | | | standpt. above |
| | | | standpt. below | | | | standpt. below |
| | | | standpt. above | | | | standpt. above |
| | | | standpt. below | | | | standpt. below |

Prepared by: *[Signature]*

Checked: *[Signature]*

Noted on U.T.M. Card

S. 2733-1

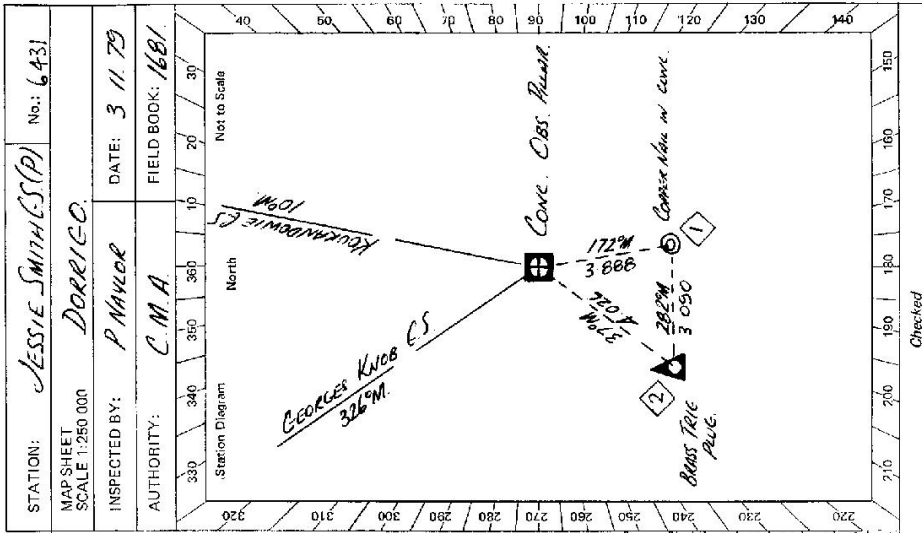

STATION: JESSIE SMITH G.S. (P) No.: 6431

MAP SHEET SCALE 1:250 000

INSPECTED BY: P NAVAR

DATE: 3 11 79

AUTHORITY: C.M.A.

FIELD BOOK: 1681

Checked

GS 24

| | |
|---|--|
| STATION <i>JESSE SMITH GS (P) 6431</i> | Owner's Name: Address: Phone: Current Occupant: Address: Phone: ACCESS Access Report of <i>13.10.1979</i> was found suitable/..... |
| Beacon Diagram Not to Scale | This section to be completed by officer constructing pillar. Original station mark found/ not found . Description of mark: <i>BRASS TREE POLE</i> Original beacon found/ not found . Description of beacon: <i>COPPER POLE & DISC</i> Height Top of Vanes to Top Mark: <i>3.605</i> m. Height of mark: <i>0.025</i> m. above mark G.L. Diameter of Vanes: <i>0.76</i> m. below mark Height of Cairn: <i>0.90</i> m. Original Beacon has/ has not been destroyed by me. |
| Date | Record of Station |

GEODETIC SURVEY OF N.S.W.

CENTRAL MAPPING AUTHORITY

GEODETIC STATION RECONNAISSANCE and MAINTENANCE REPORT

Description:

1. Cleared by lances bearing..... from Trig. Mast
2. Mast & Vanes have been painted white & black respectively.
3. The station/pillar was unpiled/not unpiled/constructed on.....19....., dimensions now being:
Description of mark.....should be explicit, e.g., S/Steel Pillar Plate, Steel plug, Brass plug, Bolt, G.I. Pipe
Height of mark.....m. above rock/concrete; Mark is.....m. above G.L.
Height of Top Vanes to Top Mark/Pillar platem. Diameter of Vanes (vertical).....m.
Height of Cairn.....m. Diameter of Cairn.....m. Name Plate found/not found/placed.
Length of Mastm. (approximate if not unpiled)
4. A.....set in conc/rock has been placed/found, bearing.....°M from Mast/Plug/Pillar
5. A.....set in conc/rock has been placed/found, bearing.....°M from Mast/Plug/Pillar
6. A.....set in conc/rock has been placed/found, bearing.....°M from Mast/Plug/Pillar
7. A.....set in conc/rock has been placed/found, bearing.....°M from Mast/Plug/Pillar
8. Action required:.....

Notes: Cross out word or words which do not apply

STATION: *Jessie Smith (S.P.)* No.: *6431*
 MAP SHEET SCALE 1:250 000
 INSPECTED BY: *P. Naylor* DATE: *3-11-79*
 AUTHORITY: *C.M.A.* FIELD BOOK: *1681*

Station Diagram

Not to Scale

| STANDPOINT: | | | |
|-------------|-----------|-----------------|-------------------|
| Mark | Direction | Horiz. Distance | Height Difference |
| | | | above standpt. |
| | | | below |
| | | | above standpt. |
| | | | below |
Prepared by:

Checked:

Noted on U.T.M. Card

GEODETTIC SURVEY OF N.S.W.

CENTRAL MAPPING AUTHORITY

GEODETTIC STATION RECONNAISSANCE and MAINTENANCE REPORT

- Description: *Note: Cross out word or words which do not apply*
- Cleared by lanes bearing..... from Trig, Mast
 - Mast & Vanes have been painted white & black respectively.
 - The station/pillar was unpiled/not unpiled/constructed on..... 19..... dimensions now being:
Description of mark..... should be explicit; e.g., S/Steel Pillar Plate, Steel plug, Brass plug, Bolt, G.I. Pipe
Height of mark..... m. ^{above} _{below} rock/concrete; Mark is..... m. ^{above} _{below} G.L.
Height of Top Vanes to Top Mark/Pillar plate..... m. Diameter of Vanes (vertical)..... m.
 - Diameter of Cairn..... m. Name Plate found/not found/placed.
Length of Mast..... m. (approximate if not unpiled)
 - A..... set in conc/rock has been placed/round, bearings..... M from Mast/Plug/Pillar
 - A..... set in conc/rock has been placed/round, bearing..... M from Mast/Plug/Pillar
 - A..... set in conc/rock has been placed/round, bearing..... M from Mast/Plug/Pillar
 - A..... set in conc/rock has been placed/round, bearing..... M from Mast/Plug/Pillar
 - Action required:.....

STANDPOINT:

| Mark | Direction | Horiz. Distance | Height Difference | Mark | Direction | Horiz. Distance | Height Difference |
|------|-----------|-----------------|-------------------|------|-----------|-----------------|-------------------|
| | | | above standpt | | | | above standpt |
| | | | below standpt | | | | below standpt |
| | | | above standpt | | | | above standpt |
| | | | below standpt | | | | below standpt |
| | | | above standpt | | | | above standpt |
| | | | below standpt | | | | below standpt |
| | | | above standpt | | | | above standpt |
| | | | below standpt | | | | below standpt |

Prepared by:

Checked:

Noted on J.M. Card

STATION: **JESSIE SMITH (P)** No.: **TS 6431**


MAP SHEETS SCALE 1:250 000

INSPECTED BY: **R. FINEWAY**

DATE: **21/10/86**

AUTHORITY: **S.R.A.**

FIELD BOOK:

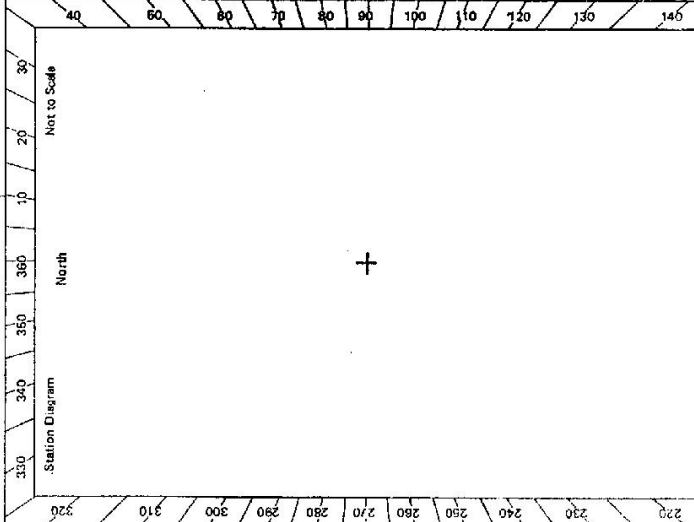

Checked: *[Signature]*

GS 24

13

STATION: **JESSIE SMITH (P) 6431**

Current Occupant:
 Address:
 Phone:

Name:
 Address:
 Phone:

Report of ~~11/10/1988~~ was found suitable/unavailable.

ACCESS:

Record of Station

B 2733-2 D. W&L Government Printer

