

CENTRAL MAPPING AUTHORITY

GEODETTIC SURVEY OF N.S.W


GEODETTIC STATION RECONNAISSANCE and MAINTENANCE REPORT

STATION: **MARTIN**
 No.: **2995**

MAP SHEET
 SCALE 1:250 000
GRAFTON

INSPECTED BY: **J. FARMING**
 DATE: **2nd August 99**

AUTHORITY: **CMAA**
 FIELD BOOK: **1765**

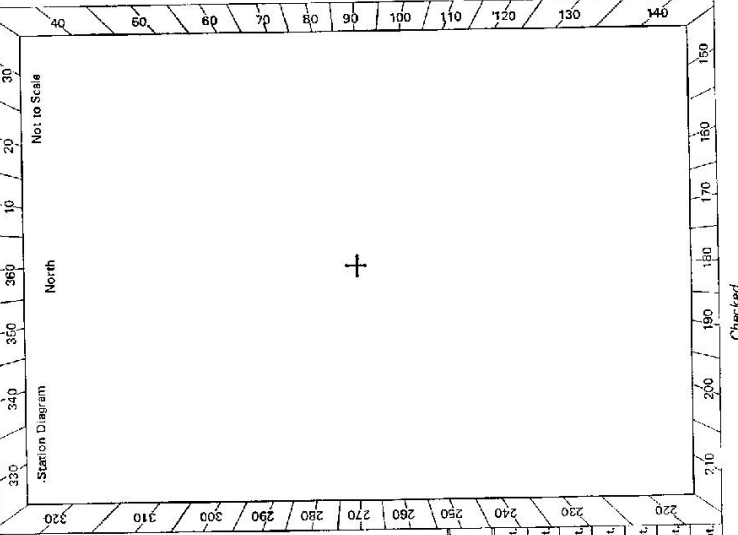

- Description:
 1. Cleared by lanes bearing **360° Southeast timber**. Note: Cross out word or words which do not apply from Trig. Mast
 2. Mast & Vanes have been painted white & black respectively.
 3. The station ~~pillar~~ **was supplied/not supplied/constructed on 2nd August 1977**, dimensions now being:
 Description of mark..... should be explicit, e.g., S/Steel Pillar Plate, Steel plug, Brass plug, Bolt, G.I. Pipe
 Height of mark..... m. above rock/concrete; Mark is..... m. above G.L.
 Height of Top Vanes to Top Mark/Pillar plate..... m. Diameter of Vanes (vertical)..... m.
 Height of Cairn..... m. Diameter of Cairn..... m. Name Plate ~~found~~/not found/..... m.
 Length of Mast..... m. (approximate if not unpled)
 4. A **Satellite marks found to be Stable** set in conc/rock has been placed/found, bearing.....° M from Mast/Plug/Pillar
 5. A..... set in conc/rock has been placed/found, bearing.....° M from Mast/Plug/Pillar
 6. A..... set in conc/rock has been placed/found, bearing.....° M from Mast/Plug/Pillar
 7. A..... set in conc/rock has been placed/found, bearing.....° M from Mast/Plug/Pillar
 8. Action required: **1 days clearing for 2 required lines**
2 days clearing for 3 required lines
Construct Pillar

| STANDPOINT: | | STANDPOINT: | | STANDPOINT: | | STANDPOINT: | |
|-------------|--------------|-----------------|-------------------|-------------|--------------|-----------------|-------------------|
| Trigs | Mark Sighted | Horiz. Distance | Height Difference | Hills | Mark Sighted | Horiz. Distance | Height Difference |
| Conroy | 17 | 15.0 | above standpt. | Royal | 245 | 20.2 | above standpt. |
| Rockview | 89 | 6.8 | above standpt. | Blackhole | 279 | 18.6 | below standpt. |
| Blaxland | 87 | 7.3 | above standpt. | Bowd | 281 | 17.3 | above standpt. |
| | | | above standpt. | WIMBIE | 313 | 13.5 | above standpt. |
| | | | below standpt. | | | | below standpt. |
| | | | above standpt. | | | | above standpt. |
| | | | below standpt. | | | | below standpt. |
| | | | above standpt. | | | | above standpt. |
| | | | below standpt. | | | | below standpt. |

Prepared by: **J. Farming** Checked: **W. Patten 24/9/99** Noted on U.T.M. Card

SR-2733--2 D. West, Government Printer

STATION **MARTIN TS 6436**

Owner's Name: **Vicent Crown Land**
 Address: **Land Dept**
 Station: **Station**
 Phone: **Permission granted to work at try**

Trip in road reserve not on
 Leave to anyone... Clearing will not
 involve cutting trees on anyone
 else's land.

ACCESS **2-8-1919**
4W1


Access Report of **1962** was found ~~unsuitable~~ **unsuitable**.

Access 1

0 0 **Stk Grafton P.O** travel west **Cuyler Highway**
7 23 Turn left **Old Glen Limes Road**
36 5 Pass road **RHS** sign **DEPART**
43 27 At blazed trees on crest of rise turn north off road onto faint track
43 96 At blazed trees turn right follow blazed track up ridge to trig
44 43 Trig

Access 2

0 00 **Nymbada Public School** travel north
1 38 Turn left Sign "To Old Glen Limes Road"
5 05 Grid
9 56 AS at **43.67** Above

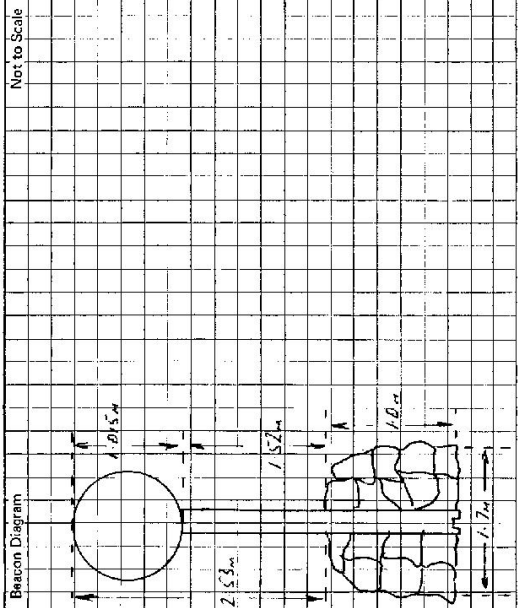

This section to be completed by officer constructing pillar.

Original station mark found/not found.

Description of mark:

Original beacon found/not found.

Description of beacon:

Height Top of Vanes to Top Mark:m.

Height of mark:m. above rock/cand. below G.L.

Diameter of Vanes:m. Height of Cairn:m.

Original Beacon has/has not been destroyed by me.

| | |
|------|-------------------|
| Date | Record of Station |
| | |
| | |
| | |
| | |

CENTRAL MAPPING AUTHORITY

GEODETIC SURVEY OF M.S.W.

GEODETIC STATION RECONNAISSANCE and MAINTENANCE REPORT

STATION: MARTIN TS No.: 6436

MAP SHEET SCALE 1:250 000 GRAFTON

INSPECTED BY: H.C. BORDER DATE: 10-10-79

AUTHORITY: C.M.A. FIELD BOOK: 1680

Description:
 1. Cleared by lanes bearing..... 360°
 Note: Cross out word or words which do not apply

2. Mast & Vanes have been painted white & black respectively. ✓
 from Trig. Mast PILLAR

3. The ~~station~~ pillar was ~~replaced/re-erected~~/constructed on 15-9-1979, dimensions now being:

Description of mark: ~~S/S Pillar~~ ~~Plates~~ should be explicit. e.g., S/Steel Pillar Plate, Steel plug, Brass plug, Bolt, G.I. Pipe

Height of mark: 1.380 m. ^{above rock/concrete;} Mark is 1.560 m. ^{above G.L.}

Height of Top Vanes to Top Mark/Pillar plate 1.390 m. Diameter of Vanes (vertical) 0.755 m.

Height of ~~Coin~~..... m. Diameter of ~~Coin~~..... m. Name Plate found/not found/~~placed~~.

Length of Mast 1.470 m. (approximate if not unplied)

4. A. G.I. PIPE..... set in conc/feek has been ~~placed~~/found, bearing 90° M from Mast/Plug/Pillar

5. A. TRIG PLUG..... set in conc/feek has been ~~placed~~/found, bearing 102° M from Mast/Plug/Pillar

6. A. S.S.M..... set in conc/feek has been ~~placed~~/found, bearing 344° M from Mast/Plug/Pillar

7. A..... set in conc/rock has been placed/~~found~~, bearing.....° M from Mast/Plug/Pillar

8. Action required: NIL

STANDPOINT: CONC. PILLAR

| Mark | Direction | Horiz. Distance | Height Difference | Mark | Direction | Horiz. Distance | Height Difference |
|-------------|-----------|-----------------|-------------------|-------------------|-----------|-----------------|-------------------|
| ROCKVIEW OP | 359 59 60 | | above standpt. | ROCKVIEW OP | 359 59 60 | | above standpt. |
| G.I. PIPE | 54 40 50 | 6.231 | 1.678 | G.I. PIPE | 47 58 00 | 4.014 | 0.031 |
| TRIG PLUG | 66 32 10 | 2.292 | 1.645 | LOFTY T.S | 133 33 40 | | above standpt. |
| LOFTY T.S | 133 32 10 | | above standpt. | LOFTY OP | 133 34 10 | | above standpt. |
| LOFTY OP | 133 32 40 | | above standpt. | ROYAL OP | 196 10 10 | | above standpt. |
| ROYAL OP | 196 08 40 | | above standpt. | CONC. OBS. PILLAR | 246 31 20 | 2.294 | 1.648 |
| S.S.M | 305 20 30 | 2.147 | 1.627 | S.S.M | 274 53 30 | 3.868 | 0.019 |


STANDPOINT: TRIG PLUG

| Mark | Direction | Horiz. Distance | Height Difference |
|-------------------|-----------|-----------------|-------------------|
| CONC. OBS. PILLAR | 246 31 20 | 2.294 | 1.648 |
| S.S.M | 274 53 30 | 3.868 | 0.019 |

Prepared by: H.C. BORDER

Checked:


Noted on U.T.M. Card

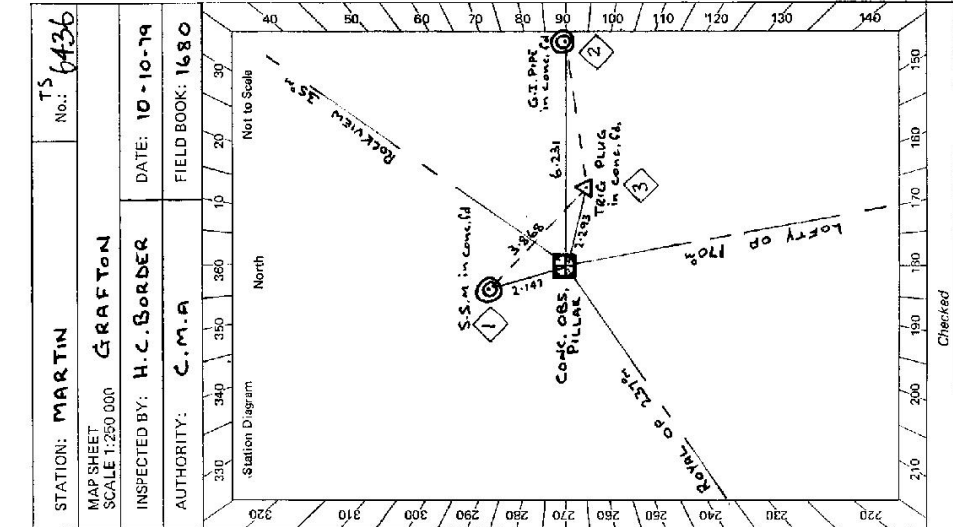

Checked

Br 2733-2 D. West, Government Printer

Beacon Diagram

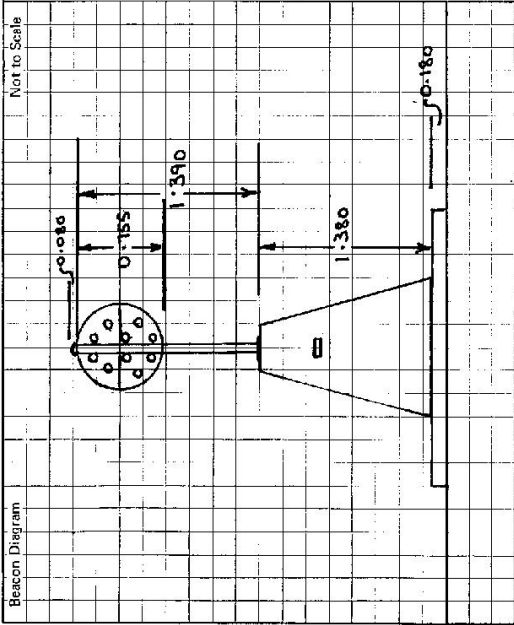

STATION MARTIN TS 6436

Owner's Name: **Vasant Cawas Lamb**
 Address:
 Phone:

Current Occupant:
 Address:
 Phone:

ACCESS 10-10-1979

Access Report of 2.8.1979 was found ~~unsuitable~~/unsuitable.

- 0.00 From Nymboide Public School travel north
- 1.40 Turn left. Sign: to Glen Innes Road.
- 4.70 Sign: Glen Innes Rd, 15km.
- 5.05 Grid
- 9.60 Blazed Trees, turn onto faint track on ~~right~~ land side
- 9.90 Blazed Trees, turn Right up ridge
- 10.40 Concrete Obv, Pillar

This section to be completed by officer constructing pillar.

Original station mark found/~~not found~~.

Description of mark: **Steel Tri. Plug in conc. Cd**

Original beacon found/~~not found~~.

Description of beacon: **Cairn Mast + Vanes**

Height Top of Vanes to Top Mark: **3.660** m.

Height of mark: **0.015** m. above ~~below~~ **0.100** m. above ~~below~~ G.L.

Diameter of Vanes: **1.100** m. Height of Cairn: m.

Original Beacon has/~~has not been~~ destroyed by me.

Date

Record of Station