

6437

CENTRAL MAPPING AUTHORITY

GEODETTIC STATION RECONNAISSANCE and MAINTENANCE REPORT


STATION: N/111801 No.: 3582

MAP SHEET SCALE 1:250 000

INSPECTED BY: J FAWNING DATE: 2nd August 19

AUTHORITY: CMA FIELD BOOK: 1765

Description:
 1. Cleared by lanes bearing... surrounded by trees... from Trig, Mast
 Note: Cross out word or words which do not apply
 2. Mast & Vanes have been painted white & black respectively.
 3. The station/pillar was applied/not applied/constructed on 2nd August 19. 2.2m, dimensions now being:
 Description of mark... should be explicit, e.g., S/Steel Pillar Plate, Steel plug, Brass plug, Bolt, G.I. Pipe
 Height of mark... m. above rock/concrete; Mark is... m. above G.L.
 Height of Top Vanes to Top Mark/Pillar plate... m. Diameter of Vanes (vertical)... m.
 Height of Cairn... m. Diameter of Cairn... m. Name Plate found/not found/placed.
 Length of Mast... m. (approximate if not unplied)
 4. A... S.S.M. set in conc/rock has been placed/found, bearing... 352.0° M from Mast/Plug/Pillar 4.13m
 5. A... G.I. Pipe set in conc/rock has been placed/found, bearing... 264.0° M from Mast/Plug/Pillar 3.42m
 6. A... set in conc/rock has been placed/found, bearing... ° M from Mast/Plug/Pillar
 7. A... set in conc/rock has been placed/found, bearing... ° M from Mast/Plug/Pillar
 8. Action required: May bearing for required in order to observe precisely sighted to Trig.
 Construct zone Pillar

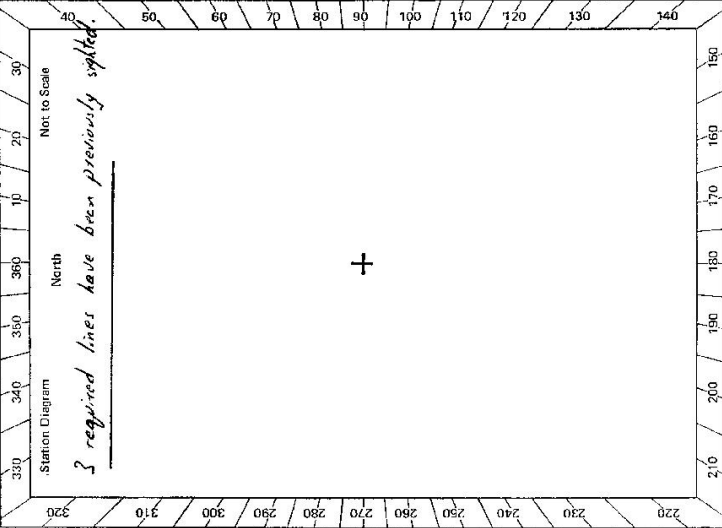

STANDPOINT:	Grid Direction	Horiz. Distance	Height Difference	Mark/Bearing	Direction	Horiz. Distance	Height Difference
Bearing Required				Additional Bearing			
Martin	133		above standpt.	Blackland	117		above standpt.
Blackhole	233		above standpt.	Royal	178		above standpt.
Lungbung	324		above standpt.	Royd	231		above standpt.
			above standpt.				above standpt.
			above standpt.				above standpt.
Prepared by: J Fawning. Checked: W. Pathe 24/9/23. Noted on U.T.M. Card

CENTRAL MAPPING AUTHORITY

GEODETIC SURVEY OF N.S.W.

GEODETIC STATION RECONNAISSANCE and MAINTENANCE REPORT

STATION: N Y M B O I No.: 6437

MAP SHEET SCALE 1:250 000 GRAFTON

INSPECTED BY: H.C. BORDER DATE: 9-10-79

AUTHORITY: C.M.A. FIELD BOOK: 1680

Description: *Note: Cross out word or words which do not apply*

1. Cleared by lanes bearing 103° to 225° 3.5m to 3.9m from Trig. Mast Pillar 351° to 45°

2. Mast & Vanes have been painted white & black respectively. /

3. The station/pillar was ~~unplaced/not-erected~~/constructed on S-9 19.19 dimensions now being:

Description of mark: S/Steel Pillar Plate should be explicit, e.g., S/Steel Pillar Plate, Steel plug, Brass plug, Bolt, G.I. Pipe

Height of mark: 1.365 m. ^{above}/_{below} rock/concrete; Mark is 1.515 m. ^{above}/_{below} G.L.

Height of Top Vanes to Top Mark/Pillar plate 1.450 m. Diameter of Vanes (vertical) 0.755 m.

Height of G.I. Pipe 1.530 m. Diameter of G.I. Pipe 1.530 m. Name Plate found/~~not-found~~/placed.

Length of Mast 1.530 m. (approximate if not unpled)

4. A. S.S.M. set in conc/~~rock~~ has been ~~placed~~/found, bearing 53° M from Mast/Plug/Pillar

5. A. Conc. Case set in conc/~~rock~~ has been ~~placed~~/found, bearing 130° M from Mast/Plug/Pillar

6. A. G.I. Pipe set in conc/~~rock~~ has been ~~placed~~/found, bearing 188° M from Mast/Plug/Pillar

7. A. set in conc/~~rock~~ has been placed/found, bearing M from Mast/Plug/Pillar


8. Action required: N/A

STANDPOINT: CONC. OBS. PILLAR			STANDPOINT: CAET, CASE			
Mark	Direction	Horiz. Distance	Height Difference	Direction	Horiz. Distance	Height Difference
BLACKHOLE T.S.	359 59 60		above standpt.	BLACK HOLE T.S.	359 59 60	above standpt.
SSM in conc. fd.	193 12 00	2500	below standpt.	G.I. PIPE	40 02 40 34 05	above standpt.
MARTIN Pillar	259 38 20		above standpt.	CONC. OBS. PILLAR	90 12 00 39 00	above standpt.
Conc. Case	170 12 50	3901	below standpt.	S.S.M.	176 20 00 41 33	above standpt.
ROYAL OP	304 12 40		above standpt.	MARTIN PILLAR	259 37 00	above standpt.
G.I. Pipe	326 55 20	3127	below standpt.	ROYAL OP	304 12 00	below standpt.


Prepared by: H.C. BORDER

Checked:

Noted on U.T.M. Card

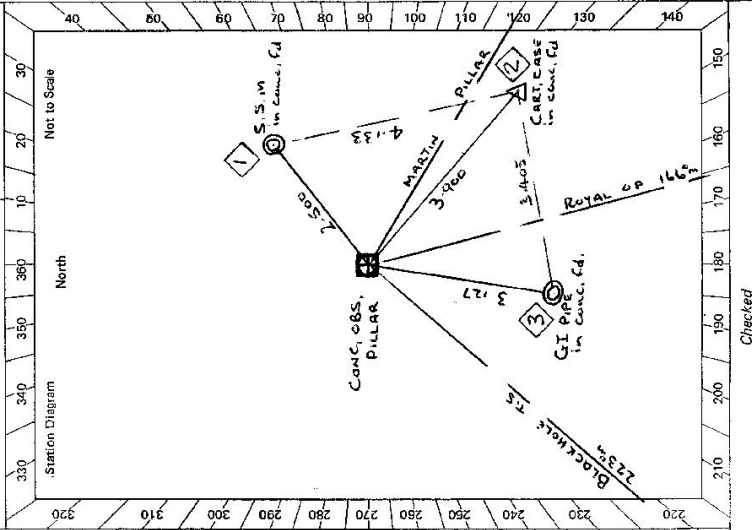


Checked

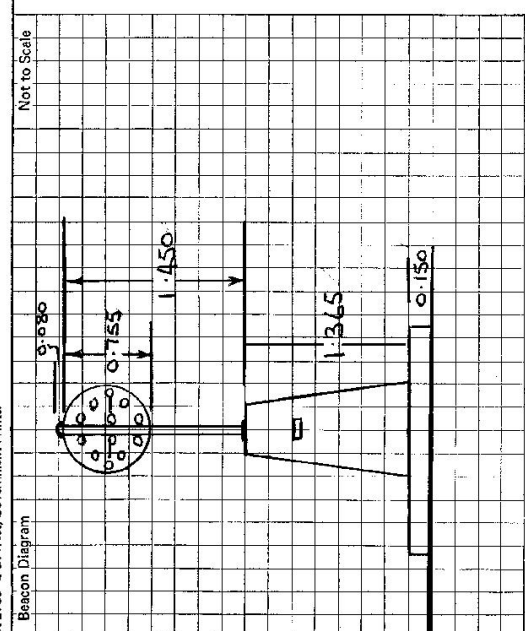STATION N14501 TS 6437	Owner's Name: MR JOHN LLOYD Address: COLLETTS ISLANDS Via ULMAORA Phone: 44 8241 (TASCARIA) Current Occupant: Address: Phone: ACCESS Access Report of 18/10/19 was found suitable/ unsuitable for: J. FANNING
Beacon Diagram Not to Scale 	This section to be completed by officer constructing pillar. Original station mark found/ not found . Description of mark: <u>Cart Case in concrete</u> Original beacon found/ not found . Description of beacon: <u>Cairn Mast + Vanes</u> Height Top of Vanes to Top Mark: <u>3.630</u> m. Height of mark: <u>0.020</u> m. <u>above</u> below G.L. Diameter of Vanes: <u>1.000</u> m. Height of Cairn: <u>1.000</u> m. Original Beacon has been been destroyed by <u>Mr. L. NICHOLAS</u>
	Date Record of Station

SI 2753--2 D. West, Government Printer

STATION NYMBOI TS 6437

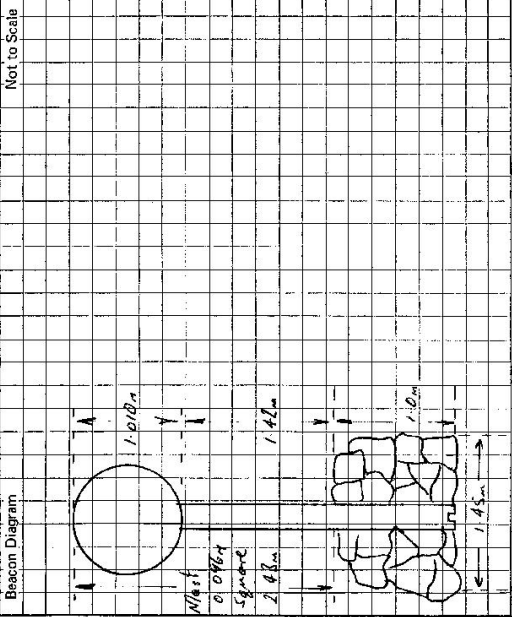

Owner's Name: John P Lloyd
 Address: Coletts Island
 Phone: Via Ulmara
44 8291 (Tasmania)

Current Occupant: James servants to
 Address: erecting a pillar and any
altering necessary
 Phone: 2-8-1979

Access Report of 1962 was found unsuitable (unsuitable).

Access

0.50 South Grafton P.O. travel west on Gwydir Highway
 7.23 Turn left "Old Grafton Glen Innes Road"
 26.0 Take road to right at top of Barracumbi range Sign DOBEY
 6.88 Pass road R.H.S. to DOBEY
 7.07 Barbed wire gate
 8.95 Pass track R.H.S.
 9.49 Barbed wire gate
 9.68 Take left fork
 9.82 Barbed wire gate
 10.02 Take right fork
 10.79 Barbed wire gate
 11.17 Trig

This section to be completed by officer constructing pillar.

Original station mark found/not found.

Description of mark:

Original beacon found/not found.

Description of beacon:

Height Top of Vanes to Top Mark:m.

Height of mark:m. above G.L. below

Diameter of Vanesm. Height of Cairnm.

Original Beacon has/has not been destroyed by me.

Date	Record of Station