

CENTRAL MAPPING AUTHORITY

GEODETIC SURVEY OF A.S.W.

GEODETIC STATION RECONNAISSANCE and MAINTENANCE REPORT

Description:

- Cleared by vanes bearing  $28^{\circ}$   $\rightarrow$   $36^{\circ}$   $\rightarrow$   $15^{\circ}$   $\rightarrow$   $201^{\circ}$   $\rightarrow$   $202^{\circ}$   $\rightarrow$   $197^{\circ}$  from Trig. Mast  
*Note: Cross out word or words which do not apply*
- Mast & Vanes have been painted white & black respectively.
- The station/~~pillar~~ ~~was unplaced~~/~~not unplaced~~/~~constructed~~ on  $30.8$  ~~ft~~  $1972$ , dimensions now being:  
Description of mark.....should be explicit, e.g., S/Steel Pillar Plate, Steel plug, Brass plug, Bolt, G.I. Pipe  
Height of mark.....m. <sup>above</sup> rock/concrete; Mark is.....m. <sup>above</sup> G.L.
- Height of Top Vanes to Top Mark/Pillar plate.....m. Diameter of Vanes (vertical)..... $2.25$  m.
- Height of Cairn..... $2.2$  m. Diameter of Cairn..... $2.3$  m. Name Plate ~~found~~/~~not found~~/~~placed~~.
- Length of Mast..... $3.2$  m. (approximate if not unplaced)
- A..... $5.5$  M.....set in conc/~~tee~~ has been placed/~~found~~/~~found~~, bearing..... $234^{\circ}$  M from Mast/~~Plug~~/~~Pillar~~  $3.42$
- A.....set in conc/rock has been placed/~~found~~/~~found~~, bearing..... $^{\circ}$  M from Mast/~~Plug~~/~~Pillar~~
- A.....set in conc/rock has been placed/~~found~~/~~found~~, bearing..... $^{\circ}$  M from Mast/~~Plug~~/~~Pillar~~
- A.....set in conc/rock has been placed/~~found~~/~~found~~, bearing..... $^{\circ}$  M from Mast/~~Plug~~/~~Pillar~~
- Action required:  $4$  day ~~clearing~~ ~~for necessary lines~~

STANDPOINT:

Trig	Mark	Sighted	Direction	Height Difference		Direction	Clearance	Height	Height Difference	
				above	below				above	below
Capmanhurst	8	11.3	Hill	Sighted	85	34.6	Clear	248m	Clear	248m
Edgcombe	94	28.4	Roval	Sighted	203	26.1	Clear	156m	Clear	156m
Arctodgety	259	15.8	Camelback	Sighted	327	22.8	Clear	248m	Clear	248m
Pineleis	67	21.1	Walker	Sighted	298		Clear		Clear	
Blaxland	173	27.4								
Glenugie	126									

Prepared by: J. Fanning

Checked:


24/1/79

Noted on U.T.M. Card

S: 2735-1

STATION: RAMORNE  
MAP SHEET SCALE 1:250 000  
INSPECTED BY: J. FANNING  
AUTHORITY: C.M.A.

No.: 2838  
DATE: 30 July 79  
FIELD BOOK: 1765

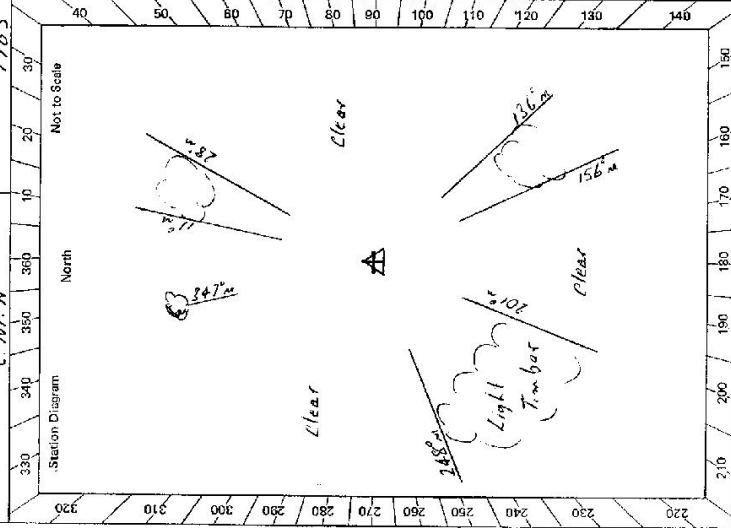

Checked

<p>STATION <b>Rampenie (Roof-Top Pillar.) TS6438</b></p> <p>Owner's Name: <b>Mr. Bruce Pickett</b>                  Address: <b>Rampenie</b>                  Phone: <b>Capitaniwest 471348</b></p> <p>Current Occupant: .....                  Address: .....                  Phone: .....</p> <p>ACCESS                  Access Report of <b>20/1/19</b> was found suitable/<del>unsuitable</del>.</p>	<p>Beacon Diagram</p> <p>Ground Level</p> <p>This section to be completed by officer constructing pillar.</p> <p>Original station mark found/<del>not found</del></p> <p>Description of mark: <b>Cartridge Case</b></p> <p>Original beacon found/<del>not found</del></p> <p>Description of beacon: <b>Pole, Cairn &amp; Disk</b></p> <p>Height Top of Vanes to Top Mark: <b>3.295</b> m.</p> <p>Height of mark: <b>0.15</b> m. <small>above</small> <del>below</del> G.L.</p> <p>Diameter of Vanes: <b>0.22</b> m. <small>above</small> <del>below</del> G.L.</p> <p>Height of Cairn: <b>1.880</b> m.</p> <p>Original Beacon has/<del>has not</del> been destroyed by me.</p>
<p>Date</p>	<p>Record of Station</p>

GEODETTIC SURVEY OF N.S.W.

CENTRAL MAPPING AUTHORITY

GEODETTIC STATION RECONNAISSANCE and MAINTENANCE REPORT


Description:

1. Cleared by ~~hand~~ excavator to point vision from Trig. Mast Pillar.   
 Note: Cross out word or words which do not apply.
2. Mast & Vanes have been painted white & black respectively.
3. The ~~station~~ pillar was ~~re-erected~~ re-erected /constructed on 4.5m diameter 19.7m, dimensions now being:   
 Description of mark: pillar black should be explicit, e.g., S/Steel Pillar Plate, Steel plug, Brass plug, Bolt, G.I. Pipe
- Height of mark: 3.9m above concrete Mark is at G.L.
- Height of Top Vanes to Top Mark/Pillar plate 3.9m. Diameter of Vanes (vertical) 1.5m.
- Height of Cairn: 0m. Diameter of Cairn: 0m. Name Plate: ~~placed~~ /placed.
- Length of Mast 1.4m. (~~approximate if not measured~~)
4. Cartridge case set in conc/rock has been ~~placed~~ /found, bearing 338° M from ~~Mast/Pillar~~ /Pillar
5. A S.S.M. set in conc/rock has been ~~placed~~ /found, bearing 269° M from ~~Mast/Pillar~~ /Pillar
6. A S.S.M. set in conc/rock has been placed /found, bearing 0° M from Mast/Plug/Pillar
7. A S.S.M. set in conc/rock has been placed /found, bearing 0° M from Mast/Plug/Pillar
8. Action required: Cartridge case

STANDPOINT:	Roof - Top	Observation	Pillar	STANDPOINT:	Cartridge case		
Mark	Direction	Horiz. Distance	Height Difference	Mark	Direction	Horiz. Distance	Height Difference
Pinnacles (P)	0 00 00	0 00 00	above standpt.	Pinnacles (P)	0 00 00	0 00 00	above standpt.
Edgecombe (Pillar)	26 39 56	26 39 56	above standpt.	Edgecombe (Pillar)	26 39 56	26 39 56	above standpt.
S.S.M.	211 01 00	3.59	below standpt.	Roof - Top Pillar	101 15 52	2.124	above standpt.
Cartridge case	281 15 05	2.121	below standpt.	S.S.M.	176 13 34	3.498	below standpt.
Copmanhurst (P)	300 44 21	300 44 21	above standpt.	Copmanhurst (P)	300 44 03	5	below standpt.
			below standpt.				above standpt.

Prepared by: \_\_\_\_\_ Checked: \_\_\_\_\_  
 Noted on U.T.M. Card

SI 2753-1

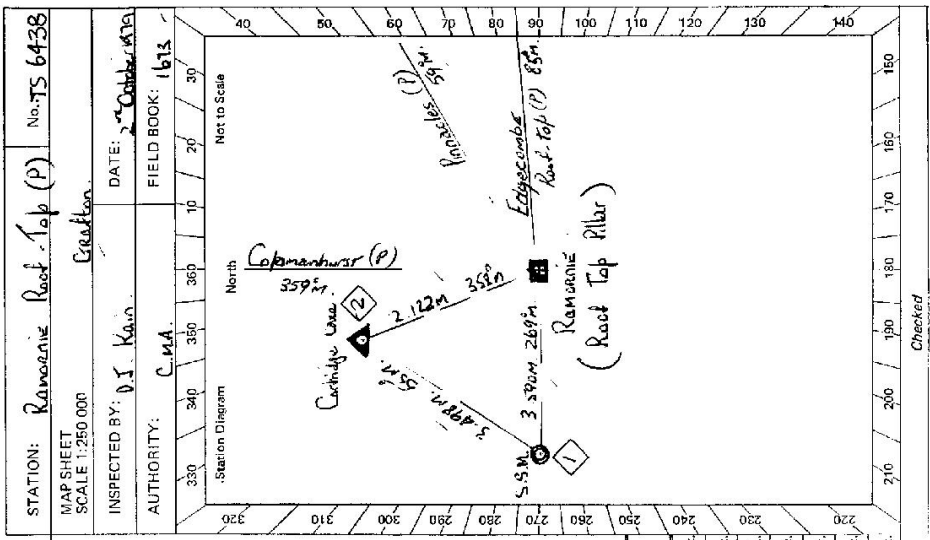

Checked

<p>STATION <b>RANDORNIE TS 6438</b></p> <p>Owner's Name: <b>Bruce Baker</b>                  Address: <b>Ramornie</b>                  Phone: <b>01753 712128</b></p> <p>Current Occupant: <b>Owner consents to</b>                  Address: <b>any clearing necessary</b>                  Phone: .....</p> <p>ACCESS <b>30th July 1979</b></p> <p>Access Report of ...../1963 was found <del>unsuitable</del>/unsuitable.</p> <p><b>Access</b>                  0.0 SR Grafton RD travel west towards H-way                  10.23 Bridge over "Cattle Pk"                  20.5 Down house LMS                  22.56 Just over crest of hill through iron gate RHS. Follow up fence line as far as possible.                  5 minute climb to trig</p>	<p>Access Report of ...../1963 was found <del>unsuitable</del>/unsuitable.</p> <p><b>Access</b>                  0.0 SR Grafton RD travel west towards H-way                  10.23 Bridge over "Cattle Pk"                  20.5 Down house LMS                  22.56 Just over crest of hill through iron gate RHS. Follow up fence line as far as possible.                  5 minute climb to trig</p>
<p>Owner's Name: <b>Bruce Baker</b>                  Address: <b>Ramornie</b>                  Phone: <b>01753 712128</b></p>	<p>Current Occupant: <b>Owner consents to</b>                  Address: <b>any clearing necessary</b>                  Phone: .....</p>
<p>ACCESS <b>30th July 1979</b></p>	<p>Access Report of ...../1963 was found <del>unsuitable</del>/unsuitable.</p>
<p><b>Access</b>                  0.0 SR Grafton RD travel west towards H-way                  10.23 Bridge over "Cattle Pk"                  20.5 Down house LMS                  22.56 Just over crest of hill through iron gate RHS. Follow up fence line as far as possible.                  5 minute climb to trig</p>	<p>Access Report of ...../1963 was found <del>unsuitable</del>/unsuitable.</p>
<p>Date</p>	<p>Record of Station</p>

