


STATION: ENGLISH No.: 6444
 MAP SHEET SCALE 1:250 000 ULLADULLA
 INSPECTED BY: H. BORDEK DATE: 6.3.79
 AUTHORITY: C.M.A. FIELD BOOK: 1539

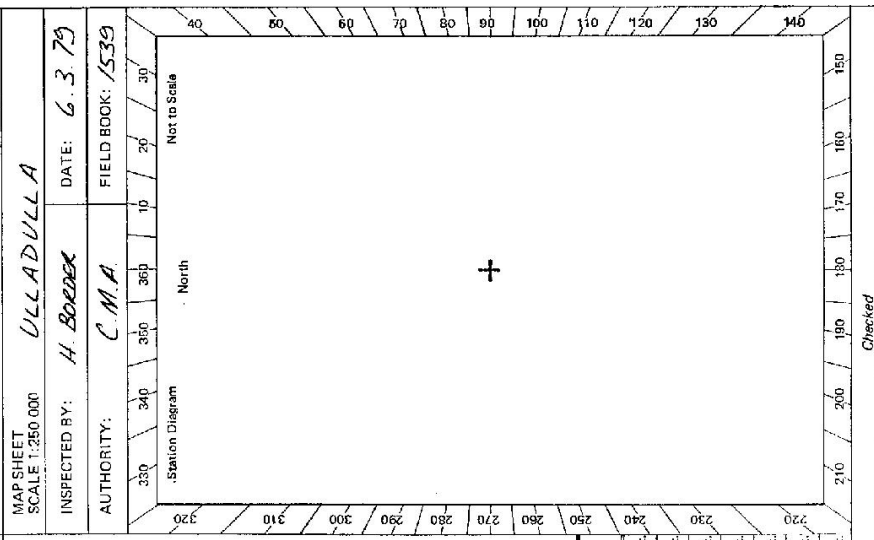

GEODETIC SURVEY OF N.S.W.
 CENTRAL MAPPING AUTHORITY
 GEODETIC STATION RECONNAISSANCE and MAINTENANCE REPORT

Description:
 Note: Cross out word or words which do not apply
 1-2 days cleaning of Suckers required from Trig, Mast

- Cleared by lanes bearing.....
- Mast & Vanes have been painted white & black respectively.
- The station/pillar was ~~unplaced~~ not unplaced/~~constructed~~ on..... 6.3..... 19.79, dimensions now being:
 Description of mark..... should be explicit, e.g., S/Steel Pillar Plate, Steel plug, Brass plug, Bolt, G.I. Pipe
 Height of mark..... m. ^{above} rock/concrete; Mark is..... m. ^{above} G.L.
 Height of Top Vanes to Top Mark/Pillar plate m. Diameter of Vanes (vertical) /..... m.
 Height of Cairn..... m. Diameter of Cairn..... m. Name Plate found/not found/placed.
 Length of Mast..... 3.79 m. (approximate if not unplaced)
- A..... S.S.M..... set in conc/rock has been placed/found, bearing..... M from Mast/Plug/Pillar
- A..... G.I. PIPE..... set in conc/rock has been placed/found, bearing..... M from Mast/Plug/Pillar
- A..... set in conc/rock has been placed/found, bearing..... M from Mast/Plug/Pillar
- A..... set in conc/rock has been placed/found, bearing..... M from Mast/Plug/Pillar
- Action required:..... SITE IS SUITABLE FOR C&C PILLAR.....

STANDPOINT:

Mark	Direction	Horiz. Distance	Height Difference	Mark	Direction	Horiz. Distance	Height Difference
			above standpt.				above standpt.
			below				below
			above standpt.				above standpt.
			below				below
Prepared by: [Signature] 17/4/79. Checked: [Signature] 17/4/79. Noted on U.T.M. Cart


STATION **ENGLISH TS 6444**

Owner's Name:
 Address:
 Phone:
 Current Occupant:
 Address:
 Phone:

ACCESS

Access Report of 6.3/1979 was found suitable/unsuitable.
KM

- 0.0 NERLICA HOTEL - Travel towards Bradwood
- 3.6 Take Road to CALLEN - GOULBURN on R.H.S. Sign post - NOWRA BG
- NERLICA A, BRADWOOD 49, BOULBURN 75, CALLEN 15.
- 7.4 Cross Bridge
- 7.65 Pass property "CORANG" on R.H.S.
- 10.7 Turn off new sealed road onto the old gravel road.
- 10.9 From the old gravel road turn onto gravel road on L.H.S.
- 11.5 Gate
- 12.5 Intersection of tracks, turn right to gate. To left - property owner
- 13.2 Gate
- 13.7 Turn through double gates on R.H.S.
- Follow track through timber to station
- 14.0 ENGLISH GEODETIC STATION.

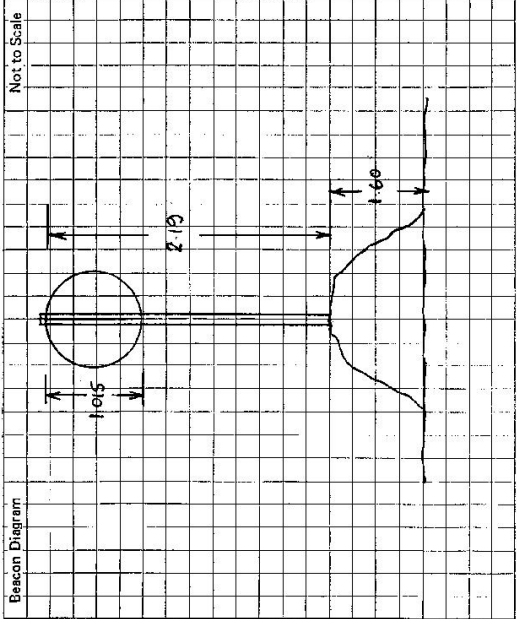

This section to be completed by officer constructing pillar.

Original station mark found/not found.

Description of mark:

Original beacon found/not found.

Description of beacon:

Height Top of Vanes to Top Markm.

Height of markm. above G.L.
 below

Diameter of Vanesm.

Height of Cairnm.

Original Beacon has/has not been destroyed by me.

Date	Record of Station

GEODETTIC SURVEY OF NSLW

CENTRAL MAPPING AUTHORITY

GEODETTIC STATION RECONNAISSANCE and MAINTENANCE REPORT

STATION: ENGLISH G.S.O.P. No.: 73 644

MAP SHEET SCALE 1:280,000 ULLADULLA

INSPECTED BY: H.C. BORDER DATE: 10-9-79

AUTHORITY: C.M.A. FIELD BOOK: 014-11

Station Diagram
Not to Scale

Trig. Pkgs. in rock to 2
G.I. PIPE in conc. cl. 6.527
CONC. OBS. PILLAR

- Description: 155.5 to 225.5 335 to 345 from Trig. Mast/Pillar
- Note: Cross out word or words which do not apply
- Cleared by lanes bearing.....
 - Mast & Vanes have been painted white & black respectively. ✓
 - The station/pillar was ~~unplaced~~ constructed on 19.7.79 dimensions now being:
 - Description of mark: S/S Plate
 - Height of mark: 1.310 above
 - Height of Top Vanes to Top Mark/Pillar plate: 1.405
 - Height of Mast: 1.485
 - A. G.I. PIPE set in conc/rock has been placed/found, bearing 217.0°M from Mast/Pillar
 - A. S.S.M set in conc/rock has been placed/found, bearing 302.0°M from Mast/Pillar
 - A. TRIG. PLUG set in conc/rock has been placed/found, bearing 307.0°M from Mast/Pillar
 - A. set in conc/rock has been placed/found, bearing.....°M from Mast/Pillar
 - Action required: none. Plate required.

Mark	Direction	Horiz. Distance	Height Difference	Mark	Direction	Horiz. Distance	Height Difference
MEANGORA T.S.	354 59 60		above standpt.	MEANGORA	359 54 60		above standpt.
G.I. PIPE	217 53 30	6.527	above standpt.	CONC. OBS. PILLAR	127 03 30	5.952	above standpt.
S.S.M	300 01 20	3.007	above standpt.	S.S.M	134 09 30	2.994	above standpt.
TRIG. PLUG	307 05 10	5.954	above standpt.	G.I. PIPE	712 26 40	3.196	above standpt.
			below				below
			below				below
STANDPOINT: CONC. OBS. PILLAR

STANDPOINT: TRIG. PLUG


Prepared by: H.C. BORDER

Checked: [Signature]

Noted on U.T.M. Card

Sr: 2733-2 D. West, Government Printer

STATION ENGLISH TS 6444

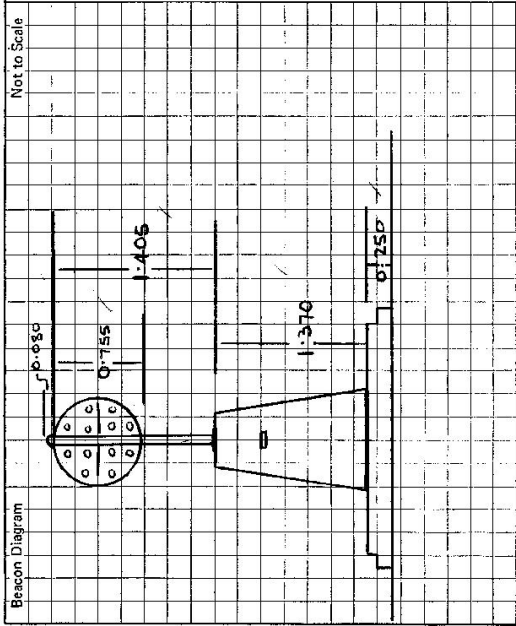

Current Occupant: Softwoods Forests P/L
 Address: P.O. Box 9 (Grazing only)
 Phone:

Owner's Name: CROWN LAND
 Address: FORESTY COMMISSION
SARUMANS BAY T.Q. 17931
 Phone:

ACCESS
 Access Report of 6/3/1919 was found suitable/~~unsuitable~~.

This section to be completed by officer constructing pillar.

Original station mark found/~~not found~~.
 Description of mark: Bronze Trig Pillar
 Original beacon found/~~not found~~.
 Description of beacon: Cairn Mast + Vanes
 Height Top of Vanes to Top Mark: 3.705 m.
 Height of mark: 0.440 m. above rock/~~above~~ 0.0 m. above G.L. ~~below~~
 Diameter of Vanes: 1.015 m. Height of Cairn: 1.500 m.
 Original Beacon has/~~has been~~ destroyed by me.

Date	Record of Station

CENTRAL MAPPING AUTHORITY

GEODETIC SURVEY OF N.S.W.
 GEODETIC STATION RECONNAISSANCE and MAINTENANCE REPORT

STATION: **ENGLISH** No.: **6444**
 MAP SHEET SCALE 1:250 000 **ULLADULLA**
 INSPECTED BY: **R ELLIS** DATE: **16/3/18**
 AUTHORITY: **C. M. A.** FIELD BOOK: **L0136**

Station Diagram
 Not to Scale
 33.5° M
 56.7° M
 75° M
 109° M
 135° M
 155° M
 223° M
 212° M
 22° M
 230° M
 240° M
 250° M
 600° M

- Description:
- Cleared by lanes bearing 33.5° & 75.5° ; 15.5° & 22.5° .
 Note: Cross out word or words which do not apply
 - Mast & Vanes have been painted white & black respectively.
 The station/pillar was unpainted/constructed on $11/07/1979$, dimensions now being:
 Description of mark: ~~Steel Pillar Plate, Steel Plug, Brass Plug, Bolt, G.I. Pipe~~
 Height of mark: ~~1.405~~ m. above rock/concrete; Mark is ~~1.405~~ m. above G.L.
 Height of Top Vanes to Top Mark/Pillar plate ~~1.405~~ m. Diameter of Vanes (vertical) ~~4.755~~ m.
 Height of Cairn ~~1.405~~ m. Diameter of Cairn ~~1.405~~ m. Name Plate found/not found/placed.
 Length of Mast ~~1.405~~ m. (approximately if not unpiled)
 - A. ~~G.I. Pipe~~ set in conc/rock has been placed/found, bearing ~~22.5~~° M from Mast/Plug/Pillar
 A. ~~Steel Plate~~ set in conc/rock has been placed/found, bearing ~~33.5~~° M from Mast/Plug/Pillar
 A. ~~TRIS. PLUG~~ set in conc/rock has been placed/found, bearing ~~75.5~~° M from Mast/Plug/Pillar
 A. ~~Steel Plate~~ set in conc/rock has been placed/found, bearing ~~15.5~~° M from Mast/Plug/Pillar
 - Action required: ~~SEEKING, REPAIR, TO ENRICH, CORRECT, SINK, & CORRECT~~

STANDPOINT:

Mark	Direction	Horiz. Distance	Height Difference	Mark	Direction	Horiz. Distance	Height Difference
			above standpt.				above standpt.
			below standpt.				below standpt.
			above standpt.				above standpt.
			below standpt.				below standpt.
Prepared by: *Ellis* 4/11/18
 Checked: *Ellis* 8/1/18
 Noted on U.T.M. Card *Ellis* 8/1/18

