

TS 6450


No: 449

STATION: TYRINGHAM G.S.

MAP SHEET
SCALE 1:250 000 DORRIGD

INSPECTED BY: D. FREDRIKSEN DATE: 1/8/79

AUTHORITY: CMA FIELD BOOK: 1764

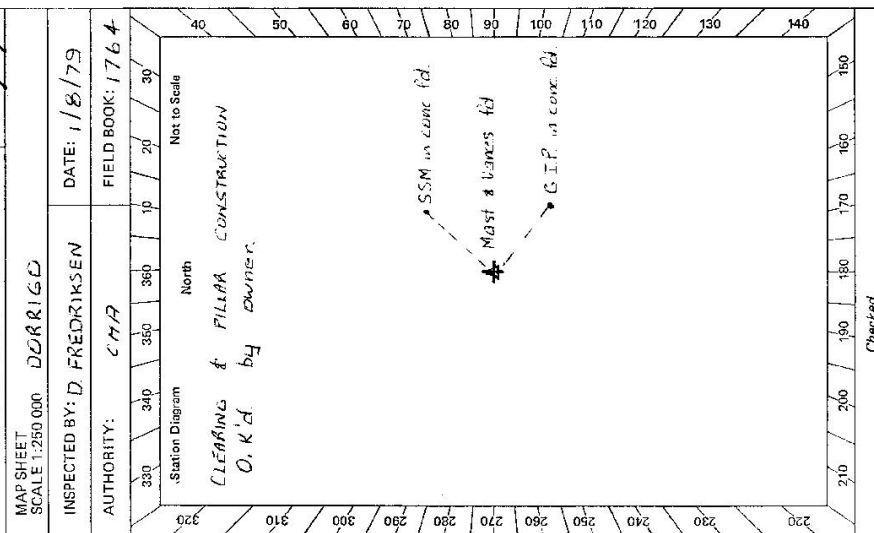

STATION: TYRINGHAM G.S.

MAP SHEET
SCALE 1:250 000 DORRIGD

INSPECTED BY: D. FREDRIKSEN DATE: 1/8/79

AUTHORITY: CMA FIELD BOOK: 1764

Mark	Direction	Horiz. Distance	Height Difference	Mark	Direction	Horiz. Distance	Height Difference
			above standpt.				above standpt.
			below				below
			above standpt.				above standpt.
			below				below
Description:

Note: Cross out word or words which do not apply

- Cleared by lanes bearing. ~~At least~~... ~~to~~... ~~clear~~... ~~3.64~~... from Trig. Mast
- Mast & Vanes have been painted white & black respectively.
- The station/pillar was ~~erected~~/not unplaced/constructed on... ~~1.1~~... ~~1.8~~... 19.72... dimensions now being:
 - Description of mark... should be explicit, e.g., S/Steel Pillar Plate, Steel plug, Brass plug, Bolt, G.I. Pipe
 - Height of mark... above rock/concrete; Mark is... above... below... G.L.
 - Height of Top Vanes to Top Mark/Pillar plate... m. Diameter of Vanes (vertical)... m.
 - Height of Cairn... m. Diameter of Cairn... m. Name Plate ~~found~~/not found/~~placed~~.
 - Length of Mast... m. (approximate if not unplied)
- A... S... M... set in conc/rock ~~has been placed~~/found, bearing... °M from Mast/Plug/Pillar
- A... G.I.P... set in conc/rock has been placed/ found, bearing... °M from Mast/Plug/Pillar
- A... set in conc/rock has been placed/ found, bearing... °M from Mast/Plug/Pillar
- A... set in conc/rock has been placed/ found, bearing... °M from Mast/Plug/Pillar
- Action required... ~~Station~~... ~~is~~... ~~available~~... ~~access~~... ~~by~~... ~~owner~~...

STANDPOINT:

Prepared by: D. FREDRIKSEN 3/8/79

Checked: h. Jahn 24/9/79

Agreed on U.I.M. Card

Checked

CENTRAL MAPPING AUTHORITY


GEODETIC SURVEY OF M.S.H. GEODETIC STATION RECONNAISSANCE and MAINTENANCE REPORT

STATION: T.M.B. 6450 No.: TS 6450

MAP SHEET SCALE 1:250 000

INSPECTED BY: L.A. M... DATE: 3 9 75

AUTHORITY: C.M.A. FIELD BOOK: 1316

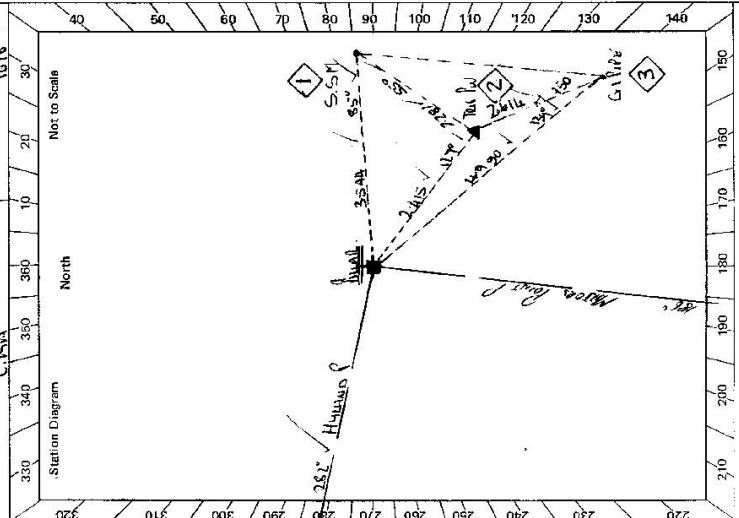

- Description: *Note: Cross out word or words which do not apply*
1. Cleared by lances bearing..... from Trig. Mast
 2. Mast & Vanes have been painted white & black respectively. ✓
 3. The station/pillar was ~~unplaced/not supported~~/constructed on..... 1975, dimensions now being: Description of mark..... should be explicit; e.g., S/Steel Pillar Plate, Steel plug, Brass plug, Bolt, G.I. Pipe
 - Height of mark..... m. above ~~rock/concrete~~ Mark is..... m. above G.L.
 - Height of Top Vanes to Top ~~Mark/Pillar plate~~..... m. Diameter of Vanes (vertical)..... m. ✓
 - Height of Cairn..... m. Diameter of Cairn..... m. Name Plate ~~found/not found~~/placed. ✓
 - Length of Mast..... m. (approximate if not unplied)
 4. A..... set in conc/rock has been ~~placed~~/found, bearing.....°M from ~~Mast/Plug/Pillar~~
 5. A..... set in conc/rock has been ~~placed~~/found, bearing.....°M from ~~Mast/Plug/Pillar~~
 6. A..... set in conc/rock has been ~~placed~~/found, bearing.....°M from ~~Mast/Plug/Pillar~~
 7. A..... set in conc/rock has been placed/found, bearing.....°M from Mast/Plug/Pillar
 8. Action required:.....

STANDPOINT: <i>Place</i>		STANDPOINT: <i>Trig. P.</i>	
Mark	Direction	Horiz. Distance	Height Difference
<i>Hydrant P</i>	0 00 00		above standpt.
<i>S.S.M</i>	172 15 10	3.544	below standpt.
<i>Trig. P.</i>	211 47 32	2.015	below standpt.
<i>G.I.P.</i>	282 12 10	4.950	below standpt.
<i>Mast/Plate P</i>	267 01 50		below standpt.

Prepared by: Checked: L.A. M... Noted on U.T.M. Card

