

CENTRAL MAPPING AUTHORITY

GEODETIC SURVEY OF N.S.W.

GEODETIC STATION RECONNAISSANCE and MAINTENANCE REPORT

Description:

1. Cleared by lances bearing..... 360° VISION *Note: Cross out word or words which do not apply*
2. Mast & Vanes have been painted white & black respectively.
3. The station/pillar was unpiled/~~not applied~~/~~constructed~~ on..... 22.18..... 19.72..... dimensions now being:
Description of mark. BRASS PLUG should be explicit, e.g., S/Steel Pillar Plate, Steel plug, Brass plug, Bolt, G.I. Pipe
Height of mark.....m, above below rock/concrete; Mark is.....m, above below G.L.
Height of Top Vanes to Top Mark/Pillar platem. Diameter of Vanes (vertical).....m.
Height of Cairn.....m. Diameter of Cairn.....m. Name Plate found/not found/placed.
Length of Mastm. (approximate if not unpiled)
4. A.....set in conc/rock has been placed/found, bearing.....°M from Mast/Plug/Pillar
5. A.....set in conc/rock has been placed/found, bearing.....°M from Mast/Plug/Pillar
6. A.....set in conc/rock has been placed/found, bearing.....°M from Mast/Plug/Pillar
7. A.....set in conc/rock has been placed/found, bearing.....°M from Mast/Plug/Pillar
8. Action required:.....

STANDPOINT:

Mark	Direction	Horiz. Distance	Height Difference	Mark	Direction	Horiz. Distance	Height Difference
			above standpt.				above standpt.
			below				below
			above standpt.				above standpt.
			below				below
Prepared by: Alan Woodruff


Checked:

Noted on U.T.M. Card

S: 2733-1

STATION: COOTA G.S.
MAP SHEET SCALE 1:250 000
INSPECTED BY: A.PATTERSON.
AUTHORITY: C.M.A.

No: 163Z
BATHURST.
DATE: 12.9.79
FIELD BOOK: 1774.

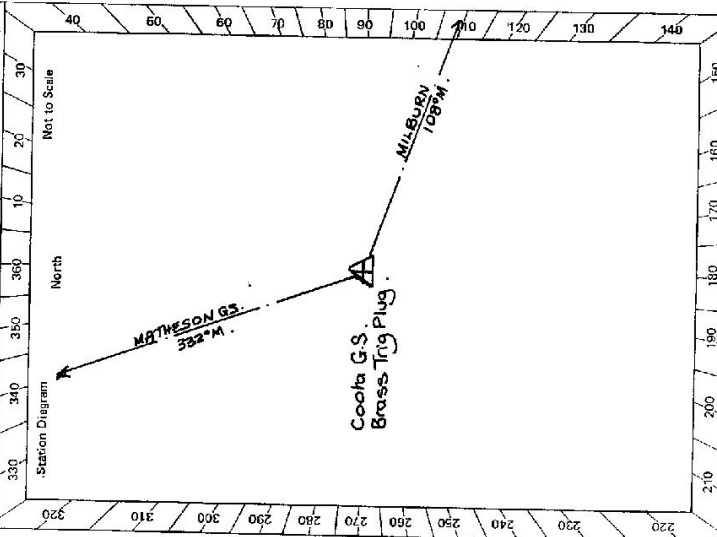

Checked

GEODETTIC SURVEY OF N.S.W.

CENTRAL MAPPING AUTHORITY

GEODETTIC STATION RECONNAISSANCE and MAINTENANCE REPORT


- Description: 2608 m
- Note: *Cross out word or words which do not apply*
- Cleared by lanes bearing 360° from Trig, Mast
 - Mast & Vanes have been painted white & black respectively.
 - The ~~station~~/pillar was ~~constructed~~/constructed on 2608 m September 79, dimensions now being: Description of marks Steel Pillar Plate, Steel plug, Brass plug, Bolt, G.I. Pipe be explicit, e.g., S/Steel Pillar Plate, Steel plug, Brass plug, Bolt, G.I. Pipe
 - Height of mark 1.360 m. above concrete Mark is 1.510 m. above G.L.
 - Height of Top Vanes to Top Pillar plate 1.810 m. Diameter of Vanes (vertical) 0.160 m.
 - Height of Cairn 0.000 m. Diameter of Cairn 0.000 m. Name Plate None placed.
 - Length of Mast 0.000 m. (approximate if not unplied)
 - A None set in conc/rock has been found/found, bearing 210° M from None/Pillar
 - A G.I. Pipe set in conc/rock has been placed/ found, bearing 332° M from None/Pillar
 - A None set in conc/rock has been placed/ found, bearing 0° M from Mast/Plug/Pillar
 - A None set in conc/rock has been placed/ found, bearing 0° M from Mast/Plug/Pillar

Action required: Paint obs. lighthouse

STANDPOINT: Conc obs lighthouse

Mark	Direction	Horiz. Distance	Height Difference	Mark	Direction	Horiz. Distancg	Height Difference
MILBURN GS	0 00 00		above standpt	MILBURN GS	0 00 00		above standpt
MILBURN GS	136 00 00		above standpt	G.I. PIPE	72 34 00	3.932	0.129
ROCK TRIG. PLUG	305 58 20	6.256	1.394	CONC OBS LIGHT	178 57 20	5.261	1.392
G.I. PIPE	353 24 00	4.291	1.522	MILBURN GS	136 00 00		above standpt
			below				below
			above standpt				above standpt
			below				below
			above standpt				above standpt
			below				below

Prepared by: P. G. S. 26 November 1979 Checked: Noted on U.T.M. Cart

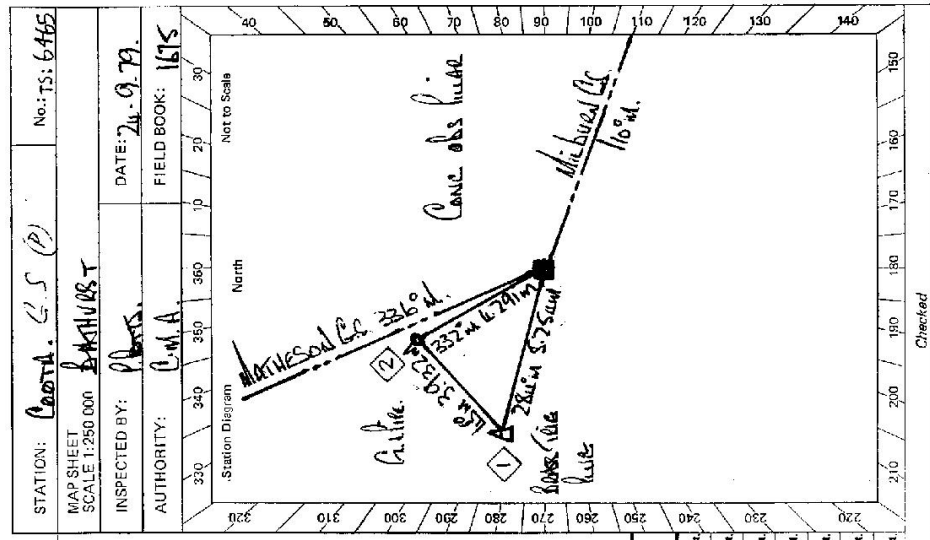

Checked

8-2733-2-D. West, Government Printer


STATION COOTA G.S.P. TS-6465

Owner's Name: E.M. BOTER
 Address: R.M. 9 G.S.
ROVERS MOUNT DARBY HILLS ROAD
COONTA
 Current Occupant:
 Address:
 Phone:

ACCESS

Access Report of 24.9.19.73 was found suitable/unavailable.

- FEATURE.**
- 0.00 P.O. LAMBA HEAD SOUTH ALONG BRADBANE STREET.
 - 0.50 TURN LEFT INTO BEAUBATHAM ST.
 - 1.10 CROSS RAILWAY LINE
 - 1.80 WOODEN BRIDGE
 - 7.70 TURN RIGHT DOUBLE IDON GATES. FOLLOW TRAIL K.
 - 7.90 TURN RIGHT THROUGH DOUBLE IDON GATE OWNERS HOUSE ON LEFT.
 - 8.40 WIRE GATE
 - 8.50 VEER LEFT
 - 8.70 COOTA GEODETIC STATION

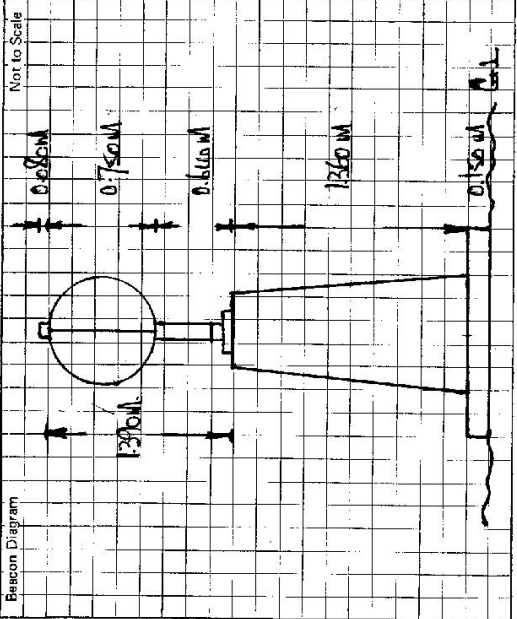

This section to be completed by officer constructing pillar.

Original station mark found/.....
 Description of mark: BARNS TIE RING
 Original beacon found/.....
 Description of beacon: Circular base x base
 Height Top of Vanes to Top Mark: 3.146 m. ^{above} below G.L.
 Height of mark 0.055 m. ^{above} 0.000 m. ^{below} G.L.
 Diameter of Vanes 0.700 m. Height of Cairn None Approx.
 Original Beacon has/..... been destroyed by me.

Date Record of Station

GEODETTIC SURVEY OF NS&K

CENTRAL MAPPING AUTHORITY

GEODETTIC STATION RECONNAISSANCE and MAINTENANCE REPORT

STATION: **COETA C.S (P)** No.: **6465**
 MAP SHEET: **BATHURST**
 SCALE: 1:250 000
 INSPECTED BY: **L HITCHINS** DATE: **15-1-90**
 AUTHORITY: **L.I.C.** FIELD BOOK: **1958**

Description: **360°** *Note: Cross out word or words which do not apply*

1. Cleared by lanes bearing..... **360°**..... from Trig. Mast

2. Mast & Vanes have been painted white & black respectively. ✓

3. The ~~steeple~~ pillar was ~~unplaced~~ ^{vs/level} ~~constructed~~ on..... **15 - 1**..... **19.70**..... dimensions now being:

Description of mark **15 - 1**..... should be explicit, e.g., S/Steel Pillar Plate, Steel plug, Brass plug, Bolt, G.I. Pipe

Height of mark (.....) **3.60**..... m. above ~~base~~ ^{base} ~~concrete~~ Mark is..... **1.50**..... m. ^{below} G.L.

Height of Top Vanes to Top ~~Mark~~ ^{Mark} /Pillar plate..... **1.70**..... m. Diameter of Vanes (vertical)..... **0.750**..... m.

Height of Cairn..... m. Diameter of Cairn..... m. Name Plate found: ~~not found~~ ^{not found}

Length of Mast..... m. (approximate if not unplied)

4. A. **BRASS TRIG. PILE**..... set in conc/rock has been ~~placed~~ ^{placed} /found, bearing..... **287**..... °M from ~~Mast/Plug/Pillar~~ ^{Mast/Plug/Pillar} **5 253**

5. A. **C.I. PILE**..... set in conc/rock has been ~~placed~~ ^{placed} /found, bearing..... **332**..... °M from Mast/Plug/Pillar **4-291**

6. A..... set in conc/rock has been ~~placed~~ ^{placed} /found, bearing..... °M from Mast/Plug/Pillar

7. A..... set in conc/rock has been ~~placed~~ ^{placed} /found, bearing..... °M from Mast/Plug/Pillar

8. Action required:.....

STANDPOINT:.....

STATION DIAGRAM

Prepared by: **L.H.H.** Checked:.....

Note on U.T.M. Card

12/833 1

GEODETTIC SURVEY OF N.S.M. *A*
 CENTRAL MAPPING AUTHORITY
 GEODETTIC STATION RECONNAISSANCE and MAINTENANCE REPORT

STATION: *COOTA G.S (P)* TS. No.: *6465*
 MAP SHEETS SCALE 1:250 000 SCALE 1:100 000
 INSPECTED BY: *P. K. BRANNON* DATE: *17/10/20*
 AUTHORITY: *L.I.C.* FIELD BOOK:

- Description:**
 1. Cleared by lanes bearing..... from Trig. Mast
Note: Cross out word or words which do not apply
 2. Mast & Vanes have been painted white & black respectively.
 3. The station/pillar was unpiled/not unpiled/constructed on.....19....., dimensions now being:
 Description of mark..... should be explicit, e.g., S/Steel Pillar Plate, Steel plug, Brass plug, Bolt, G.I. Pipe
 Height of mark.....m. above below rock/concrete; Mark is.....m. above below G.L.
 Height of Top Vanes to Top Mark/Pillar plate.....m. Diameter of Vanes (vertical).....m.
 Height of Cairn.....m. Diameter of Cairn.....m. Name Plate found/not found/placed.
 Length of Mast.....m. (approximate if not unpiled)
4. A.....set in conc/rock has been placed/found, bearing.....°M from Mast/Plug/Pillar
 5. A.....set in conc/rock has been placed/found, bearing.....°M from Mast/Plug/Pillar
 6. A.....set in conc/rock has been placed/found, bearing.....°M from Mast/Plug/Pillar
 7. A.....set in conc/rock has been placed/found, bearing.....°M from Mast/Plug/Pillar
 8. Action required:.....

STANDPOINT:

Mark	Direction	Horiz. Distance	Height Difference	Mark	Direction	Horiz. Distance	Height Difference
			above standpt.				above standpt.
			below standpt.				below standpt.
			above standpt.				above standpt.
			below standpt.				below standpt.
Prepared by: *[Signature]* 24/8/20 Checked: *[Signature]* 24/8/20
 Noted on U.T.M. Chart

