

GEODETIC SURVEY OF N.S.W.

CENTRAL MAPPING AUTHORITY

GEODETIC STATION RECONNAISSANCE and MAINTENANCE REPORT


STATION: **BREDALBANE** No.: **6469**

MAP SHEET: **Goulburn**
SCALE 1:250 000

INSPECTED BY: **A. Sivertsen** DATE: **19-10-78**

AUTHORITY: **CMA** FIELD BOOK: **1709**

- Description: *Note: Cross out word or words which do not apply*
1. Cleared by fence-bearing... *See lettered trees on hill / Probably no clearing from Trig. Mast*
 2. Mast & Vanes have been painted white & black respectively. Partly dismantled cairn etc. No mast or vanes
 3. The station/pillar was supplied/not supplied/constructed on..... 19....., dimensions now being:
Description of mark..... should be explicit, e.g., S/Steel Pillar Plate, Steel plug, Brass plug, Bolt, G.I. Pipe
Height of mark.....m. ^{above} rock/concrete; Mark is.....m. ^{above} G.L.
Height of Top Vanes to Top Mark/Pillar platem. Diameter of Vanes (vertical).....m.
Height of Cairn.....m. Diameter of Cairn.....m. Name Plate found/not found/placed.
Length of Mast.....m. (approximate if not unplied)
 4. A..... set in conc/rock has been placed/found, bearing.....° M from Mast/Plug/Pillar
 5. A..... set in conc/rock has been placed/found, bearing.....° M from Mast/Plug/Pillar
 6. A..... set in conc/rock has been placed/found, bearing.....° M from Mast/Plug/Pillar
 7. A..... set in conc/rock has been placed/found, bearing.....° M from Mast/Plug/Pillar
 8. Action required:..... **GUNNING**
1:50,000

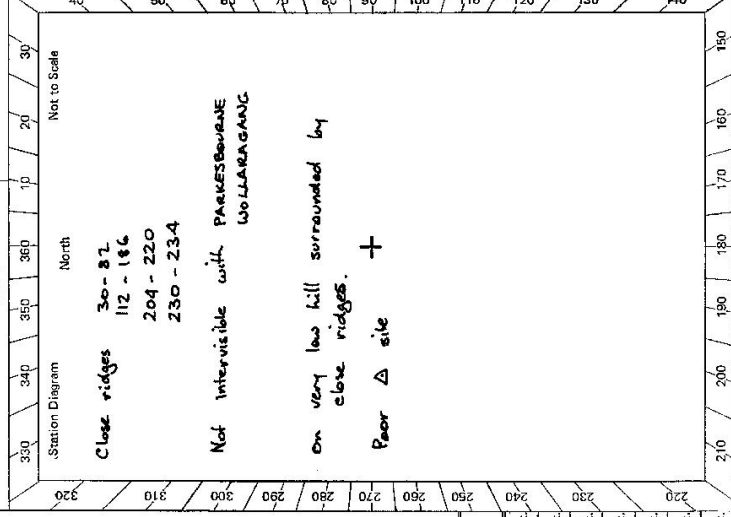

STANDPOINT:			
Mark	Direction	Horiz. Distance	Height Difference
			above standpt.
			below standpt.
			above standpt.
			below standpt.
Prepared by: *[Signature]* Checked: *[Signature]* Noted on U.T.M. Card

St 2733-2 D. West, Government Printer	STATION BREDALBANE 6469	Owner's Name: Tony Morrison Address: South, Redburn Pastoral Co BREDALBANE Phone: 44 22 31 <p style="text-align: center;"><u>ACCESS</u></p> Access Report of 19/10/1978 was found suitable/unsuitable. <p style="text-align: center;">From BREDALBANE HOTEL take Hwy west for 2.0 km then turn left over grid of head towards woolshed. Keep to R of woolshed, over grid then turn right up fence through gate to Δ at 2.6 km from pub.</p>	Current Occupant: Address: Phone:
Beacon Diagram	Not to Scale		
This section to be completed by officer constructing pillar.			
Original station mark found/not found.			
Description of mark:			
Original beacon found/not found.			
Description of beacon:			
Height, Top of Vanes to Top Markm.			
Height of markm. above G.L. / below rock/concm. above / below			
Diameter of Vanesm. Height of Cairnm.			
Original Beacon has/has not been destroyed by me.			
Date		Record of Station	

CENTRAL MAPPING AUTHORITY

GEODETIC SURVEY OF N.S.W.
 GEODETIC STATION RECONNAISSANCE and MAINTENANCE REPORT

Description: *Note: Cross out word or words which do not apply*

1. Cleared by lances bearing **360° Vision** (except **240-250°m**) from Trig. Mast
2. Mast & Vanes have been painted white & black respectively. **New Pillar**
3. The station/pillar was ~~unplaced/removed~~ constructed on **12/SEP/1979**....., dimensions now being: Description of mark **S.S. [P] Plate** should be explicit, e.g., S/Steel Pillar Plate, Steel plug, Brass plug, Bolt, G.I. Pipe
 Height of mark **1.37**.....m. ^{above} ~~below~~ concrete; Mark is **1.4**.....m. ^{above} ~~below~~ G.L.
 Height of Top Vanes to Top Mark/Pillar plate **1.44**.....m. Diameter of Vanes (vertical) **0.75**.....m.
 Height of Cairn **N/A**.....m. Diameter of Cairn **N/A**.....m. Name Plate ~~found~~ not found ~~placed~~
 Length of Mast **N/A**.....m. (approximate if not unplied)
4. **A.P.C. Trig Plug** set in conc/rock has been ~~placed~~/found, bearing **345°** M from Mast/Plug/Pillar
5. **A. ~~Station~~ C.S. Spike** set in conc/rock has been ~~placed~~/found, bearing **41°** M from Mast/Plug/Pillar
6. **A.** set in conc/rock has been ~~placed~~/found, bearing **.....°** M from Mast/Plug/Pillar
7. **A.** set in conc/rock has been ~~placed~~/found, bearing **.....°** M from Mast/Plug/Pillar
8. Action required: **Trig. Plug** **STANDPOINT: G.S. Breadalbane [P]**

Mark	Direction	Horiz. Distance	Height Difference	Mark	Direction	Horiz. Distance	Height Difference
Edward [P]	0° 00' 00"		above standpt.	Cullarin [P]	0° 00' 00"		above standpt.
Copper spike	200° 52' 51"	4.362	below standpt.	Trig plug	42° 16' 48"	3.103	below standpt.
Breadalbane Hill [P]	232° 31' 55"		above standpt.	Copper spike	98° 58' 11"	5.210	below standpt.
G.S. Breadalbane [P]	287° 42' 59"	3.102	above standpt.	Edward [P]	298° 35' 43"		above standpt.
			below standpt.				below standpt.
			above standpt.				above standpt.
			below standpt.				below standpt.
			above standpt.				above standpt.
			below standpt.				below standpt.

Prepared by: **S. Greening** P. Curtis
 Checked: **P. Curtis**
 Noted on U.T.M. Card

SI 2733-1

STATION: **G.S. BREADALBANE [P]** No.: **6469**
 MAP SHEET **GOULBURN**
 SCALE 1:250 000
 INSPECTED BY: **S. Greening** DATE: **SEP. 79**
 AUTHORITY: **D.M.R.** FIELD BOOK:

Station Diagram
 North
 Not to Scale


Checked

STATION **G.S. BREADALBANE [P] 6469**


Owner's Name: **Morrison**
 Address: **Hynde Hwy (2 km west of Breadalbane)**
 Phone:

Current Occupant: **Owner**
 Address:

Access Report of: **Sept 78** was found suitable/unsuitable.
 HOME ACCESS 0.0 Km
 2.1 km to Breadalbane Hotel
 Goulburn

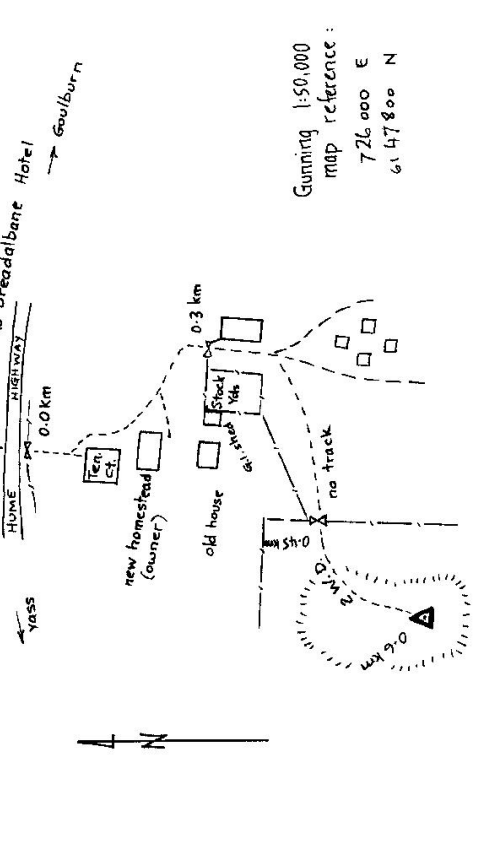

Gunning 1:50,000 map reference:
 726 000 E
 61 47 800 N

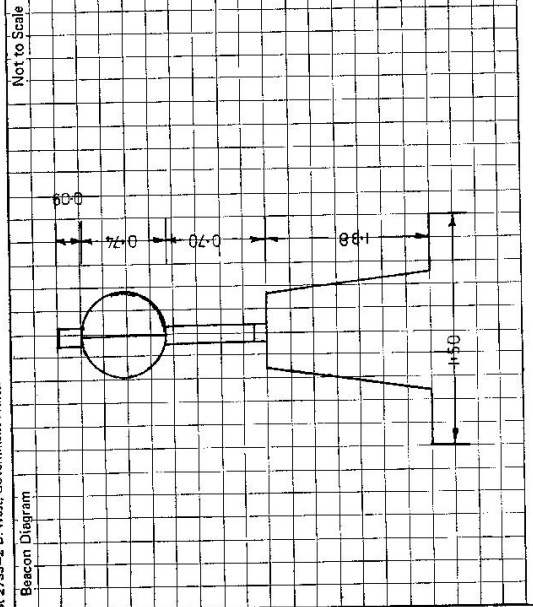

This section to be completed by officer constructing pillar.

Original station mark found/~~not~~found.
 Description of mark: **Brass Plug in Conc.**
 Original beacon ~~found~~/not found.
 Description of beacon: **Nil**
 Height Top of Vanes to Top Markm.
 Height of mark: **0.05** above ~~rock/conc~~ **0.3** above G.L. below
 Diameter of Vanesm. Height of Cairn, **unpiled**m.
 Original Beacon has/has not been destroyed by mb.

Date	Record of Station

St 2735-2 D. West. Government Printer