

CENTRAL MAPPING AUTHORITY

Department of Lands

Trigonometrical Survey of N.S.W.

RECONNAISSANCE and MAINTENANCE REPORT

This Trig. Station has been:-

Note: Cross out word or words which do not apply

1. Completely cleared to permit 360° vision to surrounding Trigs.

2. ~~Cleared by some bearing~~

3. ~~Trig. Mast & Vanes have been painted white & black respectively~~

4. The Trig. was ~~unpiled~~/not unpiled, dimensions now being:

Description of mark..... should be explicit, e.g. Steel plug, Brass plug, Bolt, G.I. Pipe

Height of mark.....m above rock/concrete.....m below G.L.

Height of Top Vanes to Top Mark.....m. Diameter of Vanes (vertical).....m.

Height of Cairn.....m. Diameter of Cairn.....2.20m.

Length of Mast ~~broken~~.....m. (approximate if not unpiled)

5. A.....set in conc/rock has been placed.....m. bearing.....°M from Trig. Mast

6. A.....set in conc/soil has been placed.....m. bearing.....°M from Trig. Mast

7. A.....set in conc/soil has been placed.....m. bearing.....°M from Trig. Mast

8. A.....set in conc/rock has been placed.....m. bearing.....°M from Trig. Mast

9. Connection.....to.....m. bearing.....°M

10. Connection.....to.....m. bearing.....°M

11. Connection.....to.....m. bearing.....°M

12. Connection.....to.....m. bearing.....°M

13. Diff. Ht.is.....m. above

14. Diff. Ht.is.....m. above

15. Diff. Ht.is.....m. above

16. Diff. Ht.is.....m. above

Prepared by: B. MITCHELL Checked: _____ dated on U.T.M. Card

STATION T.S. 1939 EDWARD (P) IS 6470


Co: ARGYLE Phi: MILBANG

Map Sheet: GUNNING 1:50,000 No: 8728

Inspected by: B.J. MITCHELL Date: G-12-78

Authority: D.M.R. Field Book:

Beacon Diagram Not to Scale

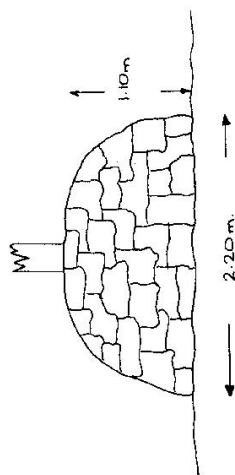

Date	Record of Station

STATION T.S. 1335 EDWARD (P) TS 6470

Owners Name


Address

Current Occupant

Address

Access 6-12-1978

Station Diagram

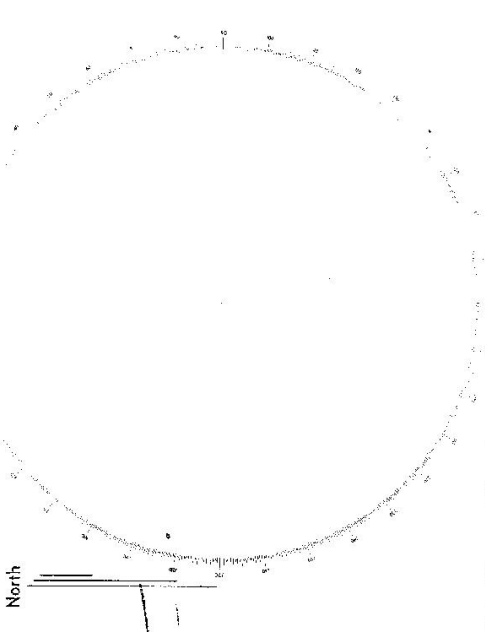


List of Observed Directions:-

Standpoint:

Station	Direction	Station	Direction

Standpoint:

Station	Direction	Station	Direction

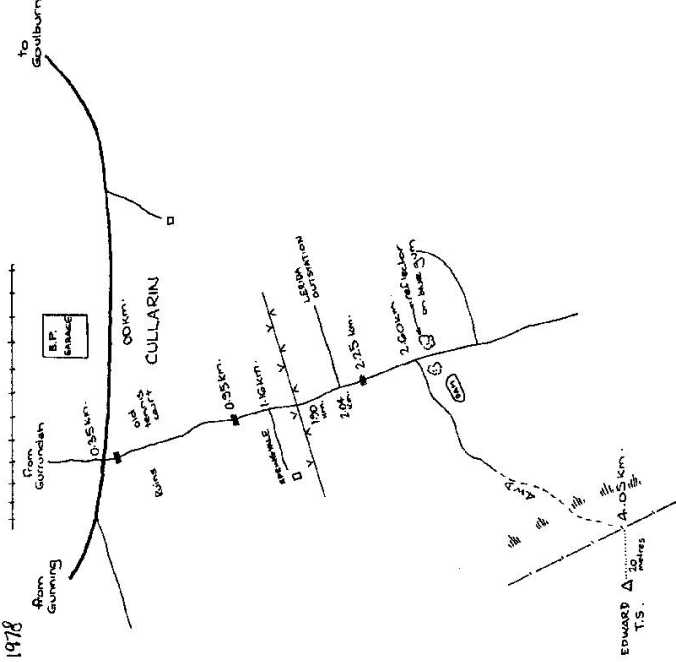

GEODETTIC SURVEY OF NS.W.

CENTRAL MAPPING AUTHORITY

GEODETTIC STATION RECONNAISSANCE and MAINTENANCE REPORT

- Description: *Note: Cross out word or words which do not apply*
- Cleared by Janes bearing 360° *Vision* from Trig. Mast
 - Mast & Vanes have been painted white & black respectively. New Pillar Erected By C.L.O.
 - The station/pillar was ~~erected~~ *re-erected*/constructed on $11.9.19.77$, dimensions now being:
Description of mark *S.S. (P) Plate* should be explicit, e.g., S/Steel Pillar Plate, Steel plug, Brass plug, Bolt, G.I. Pipe
Height of mark 1.38 ^{above} ~~below~~ *feet/concrete*; Mark is 1.4 ^{above} ~~below~~ *G.L.*
Height of Top Vanes to Top-Mark/Pillar plate 1.42 *m.* Diameter of Vanes (vertical) 0.74 *m.*
Height of Cairn *m.* ~~Dimension of Cairn~~ *m.* Name Plate ~~found/not found~~/placed.
Length of Mast 1.51 *m.* (approximate if not supplied)
 - A *OLD PLUG* set in conc/feek has been placed/found, bearing 235° *M* ~~from Mast/Plug~~/Pillar
 - A *G.I.P.* set in conc/feek has been placed/found, bearing 325° *M* ~~from Mast/Plug~~/Pillar
 - A *m* set in conc/rock has been placed/found, bearing $^\circ$ *M* from Mast/Plug/Pillar
 - A *m* set in conc/rock has been placed/found, bearing $^\circ$ *M* from Mast/Plug/Pillar
8. Action required: *.....*

STANDPOINT: [P]		STANDPOINT: Old Plug	
Mark	Direction	Height Difference	Horiz. Distance
CURTIS P	$0^\circ 00' 00''$	above standpt	$0^\circ 00' 00''$
OLD PLUG	$69^\circ 04' 24''$	below standpt	$183.51.46$
G.I.P.	$144^\circ 59' 38''$	below standpt	$249.03.17$
		above standpt	
		below standpt	
		above standpt	
		below standpt	
		above standpt	
		below standpt	

Prepared by: *B. Green* Checked: *P. Curtis* Noted on U.T.M. Card


SI 2733-1

STATION: **G.S. EDWARD [P]** No.: **TS 6470**

MAP SHEET SCALE 1:250 000

INSPECTED BY: **B GREEN** DATE: **4 | 10 | 79**

AUTHORITY: **D.M.R.** FIELD BOOK:

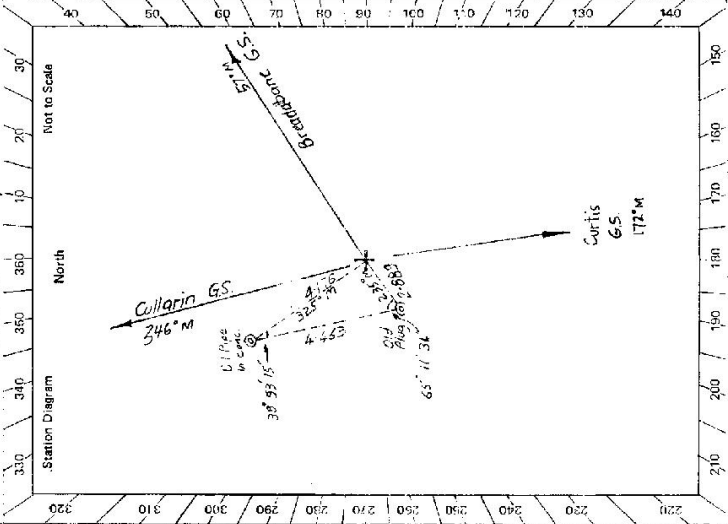


Checked

STATION **G.S. EDWARD [P] TS 6470**

Current Occupant:
 Address:
 Phone:

Owner's Name:
 Address:
 Phone:

ACCESS
 Access Report of 16/1/1979 was found suitable/acceptable.

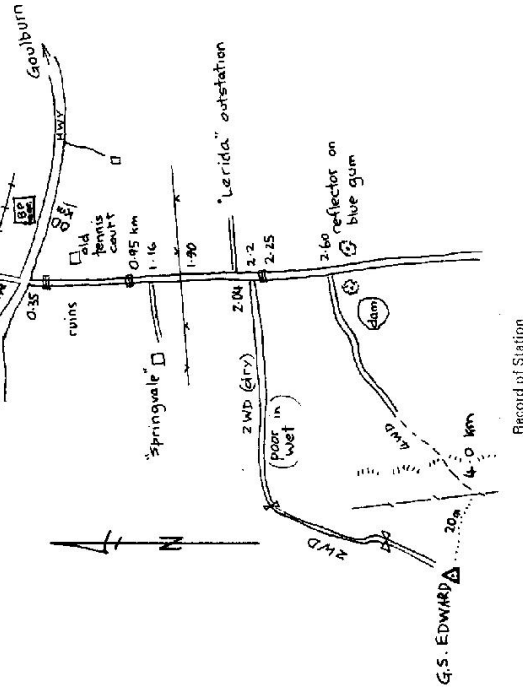


Gunning 1:50,000
 map ref.
 7 19500 E
 61 45500 N

Record of Station

Date

St. 2733-2 D. West, Government Printer

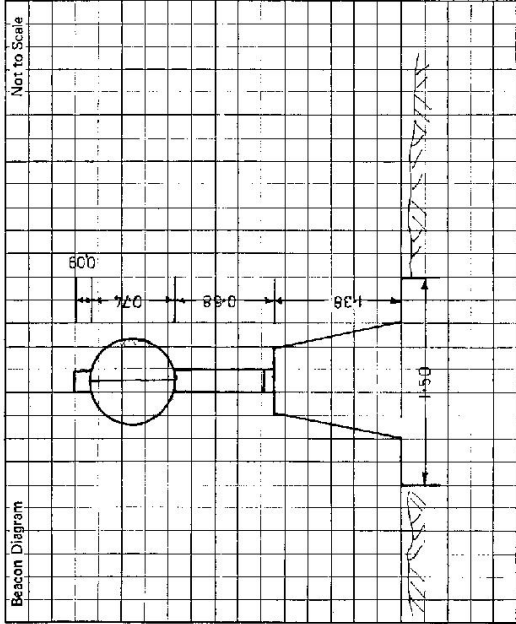

This section to be completed by officer constructing pillar.

Original station mark found/seen found:

Description of mark: **Brass Plug in Conc.**

Original beacon found/seen found:

Description of beacon: **Mast Vanes & Cairn**

Height Top of Vanes to Top Markm.

Height of markm. above G.L.
 below

Diameter of Vanesm.

Height of Cairnm.

NOT O.B.S.

Original Beacon has/had not been destroyed by me.


GEODETTIC SURVEY OF N.S.W.

CENTRAL MAPPING AUTHORITY

GEODETTIC STATION RECONNAISSANCE and MAINTENANCE REPORT

STATION: EDWARD G.S. (P) No: 6470
 MAP SHEET SCALE 1:250 000 GOULBURN
 INSPECTED BY: P. NAYLOR DATE: 6.2.80.
 AUTHORITY: C.M.A. FIELD BOOK: 1686

- Description: *Note: Cross out word or words which do not apply*
- Cleared by lanes bearing..... from Trig, Mast
 - Mast & Vanes have been painted white & black respectively.
 - The ~~station~~/pillar was unpiled/~~not supplied~~/~~constructed~~ on..... 6.2..... 19..... 80..... dimensions now being: *5/5 Steel Plate*
 - Description of mark..... should be explicit, e.g., S/Steel Pillar Plate, Steel plug, Brass plug, Bolt, G.I. Pipe
 - Height of mark..... m. ^{above} rock/concrete; Mark is..... m. ^{above} G.L.
 - Height of Top Vanes to Top Mark/Pillar plate..... m. Diameter of Vanes (vertical)..... m.
 - Height of Cairn..... m. Diameter of Cairn..... m. Name Plate found/~~not found~~/placed.
 - Length of Mast..... m. (approximate if not unpiled)
 - A..... G.I. Pipe..... set in conc/~~rock~~ has been placed/~~found~~, bearing..... 315°M from Mast/Plug/Pillar
 - A..... Brass Trig. Plug..... set in conc/~~rock~~ has been placed/~~found~~, bearing..... 255°M from Mast/Plug/Pillar
 - A..... set in conc/~~rock~~ has been placed/~~found~~, bearing..... °M from Mast/Plug/Pillar
 - A..... set in conc/~~rock~~ has been placed/~~found~~, bearing..... °M from Mast/Plug/Pillar
 - Action required:.....

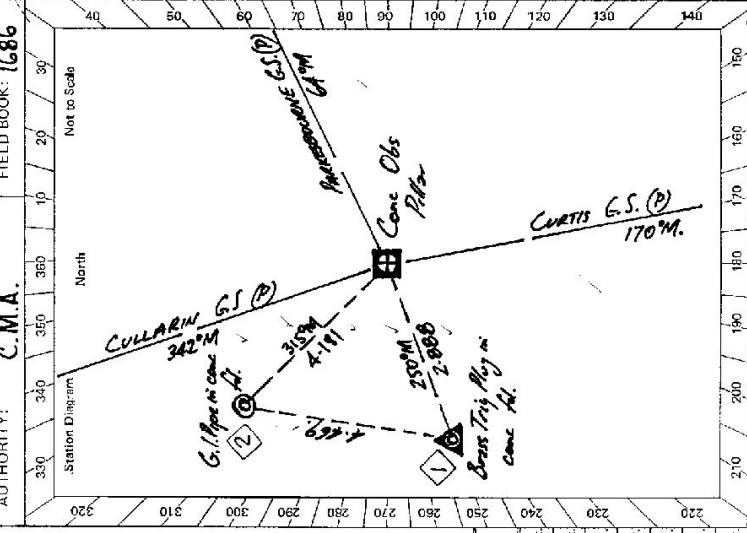

STANDPOINT: Conc Obs. Pillar		STANDPOINT: BRASS TRIG. PLUG IN CONC. PL.	
Mark	Direction	Mark	Direction
CULLARIN G.S. (P)	0 00 00	CULLARIN G.S. (P)	0 00 00
BRASS TRIG. PLUG IN CONC. PL.	75 31 45	G.I. Pipe in conc. Pl.	10 07 39
CURTIS G.S. (P)	186 16 06	Cone Obs Plate	75 18 28
TRIG PLUG FD	255 20 28	CURTIS G.S. (P)	186 14 28
G.I. Pipe in conc. Pl.	331 17 17		

Mark	Direction	Horiz. Distance	Height Difference
CULLARIN G.S. (P)	0 00 00		above standpt.
BRASS TRIG. PLUG IN CONC. PL.	75 31 45	4.469	above standpt.
CURTIS G.S. (P)	186 16 06	2.890	above standpt.
TRIG PLUG FD	255 20 28		above standpt.
G.I. Pipe in conc. Pl.	331 17 17		above standpt.

Prepared by: *P. Naylor* 22.2.80 Checked: *[Signature]*

GEODETTIC SURVEY OF A.S.W.

CENTRAL MAPPING AUTHORITY

GEODETTIC STATION RECONNAISSANCE and MAINTENANCE REPORT

- Description: *Note: Cross out word or words which do not apply*
- Cleared by lanes bearing..... from Trig. Mast
 - Mast & Vanes have been painted white & black respectively.
 - The station/pillar was unpiled/not unpiled/constructed on.....
Description of mark..... should be explicit, e.g., S/Steel Plate, Steel plug, Brass plug, Bolt, G.I. Pipe
Height of mark..... m. ^{above} rock/concrete; Mark is *ON* m. ^{above} G.L.
Height of Top Vanes to Top Mark/Pillar plate..... m. Diameter of Vanes (vertical)..... m.
Height of Cairn..... m. Diameter of Cairn..... m. Name Plate found/not found/placed.
Length of Mast..... m. ~~Approximate if not unpiled~~
 - A..... set in ~~high~~ rock has been placed/found, bearing.....°M from Mast/Plug/Pillar
 - A..... set in conc/rock has been placed/found, bearing.....°M from Mast/Plug/Pillar
 - A..... set in conc/rock has been placed/found, bearing.....°M from Mast/Plug/Pillar
 - A..... set in conc/rock has been placed/found, bearing.....°M from Mast/Plug/Pillar
 - Action required:.....

STANDPOINT:

Mark	Direction	Horiz. Distance	Height Difference	Mark	Direction	Horiz. Distance	Height Difference
			above standpt.				above standpt.
			below standpt.				below standpt.
			above standpt.				above standpt.
			below standpt.				below standpt.
			above standpt.				above standpt.
			below standpt.				below standpt.
			above standpt.				above standpt.
			below standpt.				below standpt.

Prepared by: *[Signature]* 18/2/27 Checker: *[Signature]* Noted on U.T.M. Chart



STATION: EDWARD No.: 6470

MAP SHEETS GOULBURNA SCALE 1:100 000

INSPECTED BY: M. Morrison DATE: 7-8-86

AUTHORITY: CGMA FIELD BOOK: C.416

Station Diagram

Not to Scale

Checked

GS 24

STATION EDWARD TS 6470	Owner's Name: Address: Phone: Current Occupant: Address: Phone: Access Report of 7.8/1988 was found suitable/unsuitable. Access: Direction Keys: 0.00 BRENDALBANE HOTEL ROYAL - HEAD WEST TOWARDS GUMMING 872 ALONG HOME HIGHWAY 933 TURN LEFT OFF HIGHWAY OVER GRID OPPOSITE RAILWAY CROSSINGS 10.40 TO "GURUNDIAH 18" (AT COLLARIN) 10.60 GRID 10.95 PASS TRACK ON LEFT TO "LERIDA OUTSTATION" 11.70 TURN RIGHT UP TRACK 11.98 THROUGH IRON GATE & TURN LEFT ALONG FENCE LINE TRIG
Beacon Diagram Not to Scale	This section to be completed by officer constructing pillar. Original station mark found/not found. Description of mark: Original beacon found/not found. Description of beacon:m. Height Top of Vanes to Top Markm. Height of markm. above G.L. below rock/concm. below Diameter of Vanesm. Height of Cairnm. Original Beacon has/has not been destroyed by me.
Date	Record of Station