

TS 6482


CENTRAL MAPPING AUTHORITY

STATION: SARA G.S. No.: 4026

MAP SHEET SCALE 1:250 000

INSPECTED BY: J. FANNING DATE: 14th May 17

AUTHORITY: C.M.A. FIELD BOOK: 1753

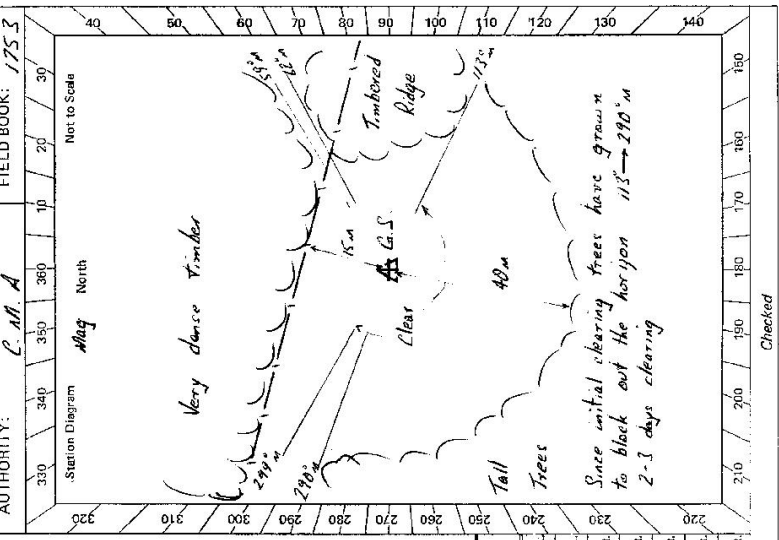

Description:	Trigs to Sca	Grid Apmtk	Horiz. Distance	Height Difference	Trigs to Sca	Grid Apmtk	Horiz. Distance	Height Difference
1. Cleared by lanes bearing 59° → 62° <i>Note: Cross out word or words which do not apply</i> Partial 113 → 299 m from Trig. Mast								
2. Mast & Vanes have been painted white & black respectively.								
3. The station/pillar was supplied/not supplied/constructed on 14th May 1979, dimensions now being: Description of mark should be explicit, e.g., S/Steel Pillar Plate, Steel plug, Brass plug, Bolt, G.I. Pipe Height of mark above rock/concrete; Mark is above/below G.L. Height of Top Vanes to Top Mark/Pillar plate m. Diameter of Vanes (vertical) m. Height of Cairn m. Diameter of Cairn m. Name Plate found/not found/placed. Length of Mast m. (approximate if not supplied)								
4. A. S.S.M. set in conc/rock has been placed/found, bearing 274° M from Mast/Plug/Pillar								
5. A. G.I. Pipe set in conc/rock has been placed/found, bearing 177° M from Mast/Plug/Pillar								
6. A. set in conc/rock has been placed/found, bearing ° M from Mast/Plug/Pillar								
7. A. set in conc/rock has been placed/found, bearing ° M from Mast/Plug/Pillar								
8. Action required: Erect concrete Pillar. 1 day clearing for necessary lines, plus 2-3 days to reopen horizon 113-299 m								
Trigs Sighted	Grid Apmtk	270	9	above standpt.	Trigs to Sca	Grid Apmtk	280'	1 tree to clear of Sca
Nightcap				below				
				above standpt.				
				below				
				above standpt.				
				below				
				above standpt.				
				below				
				above standpt.				
				below				

Prepared by: J. Fanning


Checked: J. Fanning 20/19/79

Noted on U.T.M. Card

S: 2733-1

St 2733-2 D. West, Government Printer

Beacon Diagram

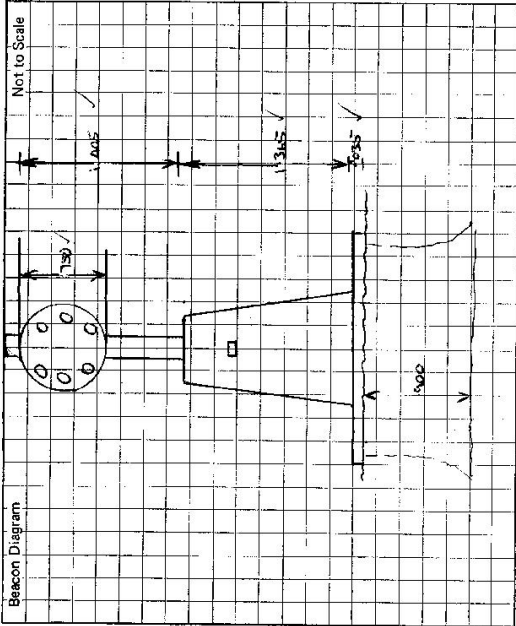

This section to be completed by officer constructing pillar. ✓

Original station mark found/~~not found~~. ✓

Description of mark: ~~Beacon~~ Beacon ~~with~~ with ~~1.2~~ 1.2 ~~vanes~~ vanes. ✓

Original beacon found/~~not found~~. ✓

Description of beacon: ~~Beacon~~ Beacon ~~with~~ with ~~1.2~~ 1.2 ~~vanes~~ vanes. ✓

Height Top of Vanes to Top Mark: ~~1.1~~ 1.1 ~~vanes~~ vanes. ✓

Height of mark: ~~0.35~~ 0.35 ~~m. below~~ m. above ~~below~~ above G.L. ✓

Diameter of Vanes: ~~1.1~~ 1.1 ~~m.~~ m. Height of Cairn: ~~0.3~~ 0.3 ~~m.~~ m. ✓

Original Beacon has/~~not~~ been destroyed by me. ✓

STATION

Saba P TS 6482

Owner's Name: LANDS DEPARTMENT

Address:

Phone:

Current Occupant: P. A. DAVIS (Gen. A. Mount Lee)

Address: HAVERSTOCK, HAVERTON

Phone: 01454 334 663

ACCESS

Access Report of 16/11/1979 was found suitable/unavailable.

For Access See I. F. 16/11/1979

Date

Record of Station

St 2793-2 D. West, Government Printer

<p>Beacon Diagram</p> <p style="text-align: right;">Not to Scale</p>	<p>STATION SARA G S TS 6482</p>	<p>Owner's Name: <i>Land Dept</i></p> <p>Address:</p> <p>Phone:</p> <p>Current Occupant: <i>R N Duddy (conditional lease)</i></p> <p>Address: <i>Haystack Property</i></p> <p>Phone: <i>PINKETT 224 663</i></p> <p>ACCESS</p> <p>Access Report of <i>15/10/79</i> was found unsuitable <i>unsuitable</i>.</p> <p><i>Kus</i></p> <p><i>2WD</i></p> <p><i>Travel south east from Glen Innes to PINKETT.</i></p> <p><i>0-00 PINKETT Auto Telk Exit Favel South.</i></p> <p><i>9-71 Cross Henry River</i></p> <p><i>14-25 Causeway</i></p> <p><i>17-18 Turn left to track. Easement between two fences</i></p> <p><i>19-20 Iron Gate</i></p> <p><i>19-37 when bridge head up to left towards iron gate</i></p> <p><i>19-69 Iron Gate follow along beside fence</i></p> <p><i>20-29 Pass between fence & dam.</i></p> <p><i>20-51 Iron gate turn right up track</i></p> <p><i>21-93 Gate</i></p> <p><i>21-97 Turn left in front of blazed tree L.H.S. follow up ridge</i></p> <p><i>22-65 Turn right to beside fence before gate</i></p> <p><i>22-83 SARA G.S.</i></p>	
		<p>Date</p> <p><i>8/5/79</i></p>	<p>Record of Station</p> <p><i>Written permission received 20/5/79 from Roy Anwar Duddy (see 55/4 RL)</i></p>

This section to be completed by officer constructing pillar.

Original station mark found/not found.

Description of mark:

Original beacon found/not found.

Description of beacon:

Height Top of Vanes to Top Mark:m.

Height of mark:m. above
below rock/concm. below G.L.

Diameter of Vanes:m. Height of Cairn:m.

Original Beacon has/not been destroyed by me.