

CENTRAL MAPPING AUTHORITY

GEODETIC SURVEY OF N.S.W.

GEODETIC STATION RECONNAISSANCE and MAINTENANCE REPORT

Description:

- Cleared by lanes bearing $62^\circ - 80^\circ$ / $184^\circ - 210^\circ$ M from Trig. Mast
- Mast & Vanes have been painted white & black respectively.
- The station/~~pillar~~ was ~~unpiled~~/not unpiled/~~concreted~~ on ~~19~~ 19 dimensions now being:

Description of mark..... should be explicit, e.g., S/Steel Pillar Plate, Steel plug, Brass plug, Bolt, G.I. Pipe
 Height of mark..... m above rock/concrete; Mark is..... m above G.L.
 Height of Top Vanes to ~~Top of Plate~~ ~~Ground~~ 3.410 m. Diameter of Vanes (vertical)..... 0.910 m.
 Height of Cairn..... m. Diameter of Cairn..... 400 m. Name Plate ~~found~~/not found/~~placed~~.

Length of Mast ~~Approx 3.410~~ m. (approximate if not unpiled)

- A ~~Copper~~ nail set in conc/rock has been ~~placed~~/found, bearing..... 194° M from Mast/~~Plug~~/~~Pillar~~
- A ~~G.I. pipe~~ set in conc/rock has been ~~placed~~/found, bearing..... 79° M from Mast/~~Plug~~/~~Pillar~~
- A..... set in conc/rock has been placed/found, bearing..... M from Mast/Plug/Pillar
- A..... set in conc/rock has been placed/found, bearing..... M from Mast/Plug/Pillar


8. Action required: ~~Name Plate to be placed~~ at this station.....

STANDPOINT:				STANDPOINT:			
Mark	Direction	Horiz. Distance	Height Difference	Mark	Direction	Horiz. Distance	Height Difference
			above standpt				above standpt
			below				below
			above standpt				above standpt
			below				below
Prepared by:

Checked: Noted on U.T.M. Card

St 2753-1

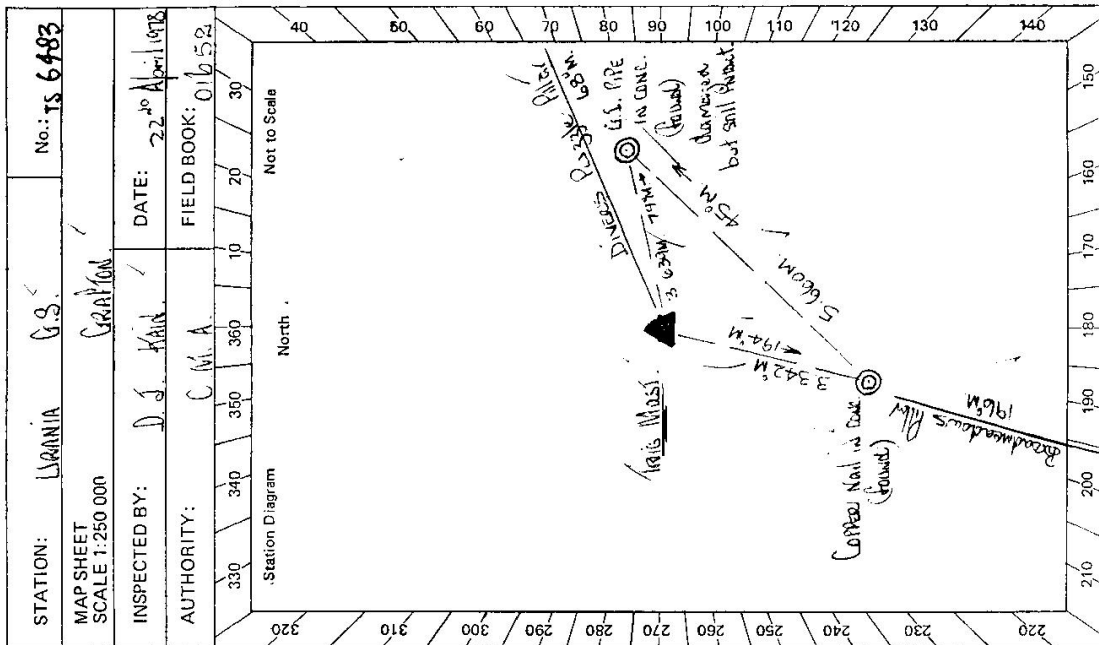

Checked

STATION: LANNIA G.S. No.: TS 6483

MAP SHEET SCALE 1:250 000

INSPECTED BY: D.J. KIRK DATE: 22nd April 1978

AUTHORITY: C.M.A. FIELD BOOK: 01652

STATION URBANIA G.S. TS 6483	Owner's Name: <u>ROXANA FOREST LAND</u> Address: <u>CAMPION OFFICE</u> Phone: Current Occupant: Address: Phone: ACCESS Access Report of 19/8/1970 was found suitable/unsuitable. Access of Mr. L. R. Hollis dated 19.8.1970 still effective however gate at 9.60 miles has now gone and station would now be driveable by a station Sedan type vehicle. A <u>CONCRETE observation pillar could be placed at this station,</u>
Beacon Diagram Not to Scale	<p> This section to be completed by officer constructing pillar. Original station mark found/not found. Description of mark: Original beacon found/not found. Description of beacon: Height Top of Vanes to Top Mark.....m. Height of mark.....m. above G.L. below Diameter of Vanesm. Height of Cairnm. Original Beacon has/has not been destroyed by me. </p>
	Date Record of Station

IS 6483
No.: 4524

GEODETIC SURVEY OF A.S.W.

CENTRAL MAPPING AUTHORITY

GEODETIC STATION RECONNAISSANCE and MAINTENANCE REPORT

Description: *Note: Cross out word or words which do not apply*


1. ~~Cleared by fence-bearing~~..... from ~~Flag-Mast~~.....
2. ~~Mast & Vanes have been painted white & black respectively~~
3. The station/pillar was ~~unplaced~~ **reconstructed** on **1st JUNE 1979**, dimensions now being: **Brass Plug** should be explicit, e.g., S/Steel Pillar Plate, Steel plug, Brass plug, Bolt, G.I. Pipe
 Description of mark: **Brass Plug**..... should be explicit, e.g., S/Steel Pillar Plate, Steel plug, Brass plug, Bolt, G.I. Pipe
 Height of mark.....m. above rock/concrete; Mark is.....m. above G.L.
 Height of Top Vanes to ~~from Mast/Pillar plate~~ **Ground level**.....m. Diameter of Vanes (vertical).....m.
 Height of Cairn.....m. Diameter of Cairn.....m. Name Plate ~~found~~/not found/~~placed~~.
 Length of Mast.....m. (approximate if not unpiled)
4. **Copper Nail**..... set in conc/rock has been placed/found, bearing.....°M from Mast/Plug/Pillar
5. A..... set in conc/rock has been placed/found, bearing.....°M from Mast/Plug/Pillar
6. A..... set in conc/rock has been placed/found, bearing.....°M from Mast/Plug/Pillar
7. A..... set in conc/rock has been placed/found, bearing.....°M from Mast/Plug/Pillar
8. Action required: **Cleaning Suckers**..... for **3 man party**, **250m² x 10 x 55m**, **20-25m tall**, **days**.....
75 x 65m - 1 day **Pillar to be built**.

STANDPOINT:

Mark	Direction	Horiz. Distance	Height Difference	Mark	Direction	Horiz. Distance	Height Difference
			above standpt.				above standpt.
			below				below
			above standpt.				above standpt.
			below				below
Prepared by: *K. Thompson* Checked: *19/75* *Noted on U.T.M. Card*

SI 2733-1

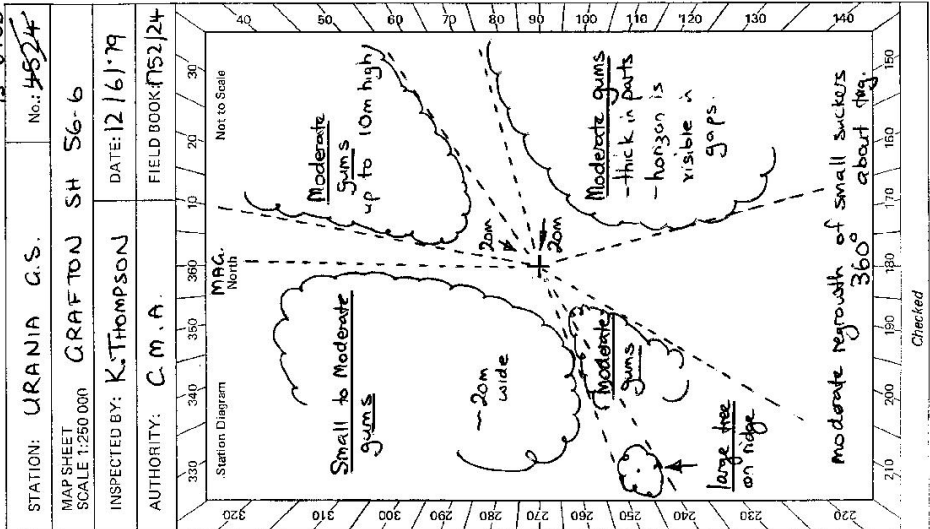

Checked

Ukraine (Pillar) IS 6483

STATION


Current Occupant:
 Address:
 Phone:

Owner's Name: Maier, M. & Co. Company
 Address: 169 Pitt Street
 Phone: (02) 232 6836

ACCESS

Access Report of: 19/8/19 was found suitable/~~unsuitable~~.

SI: 2733-2 D. West, Government Printer

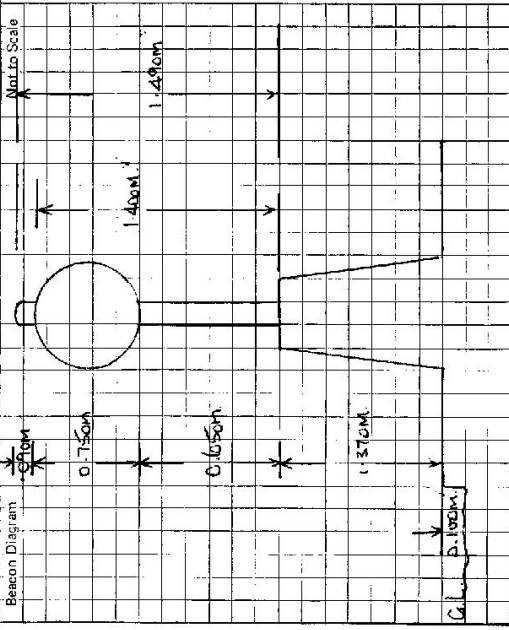

This section to be completed by officer constructing pillar.

Original station mark found/~~not found~~.

Description of mark: Brass Ring P.I.S.

Original beacon found/~~not found~~.

Description of beacon: Concrete Pillar 1.490m

Height Top of Vanes to Top Mark: 1.370m

Height of mark: 0.120m above G.L. / 0.000m below

Diameter of Vanes: 0.750m Height of Cairn: 0.000m

Original beacon has/~~not~~ been destroyed by me.

Date	Record of Station

CENTRAL MAPPING AUTHORITY

GEODETIC SURVEY OF M.S.W.

GEODETIC STATION RECONNAISSANCE and MAINTENANCE REPORT

Description:

Note: Cross out word or words which do not apply

1. Cleared by lanes bearing..... *Previously cleared 360° - 2yr old regrowth*..... from Trig. Mast
2. Mast & Vanes have been painted white & black respectively. ✓
3. The station/pillar was ~~upheld~~ *not upheld*/constructed on..... *Dec 2018 & 19 22*....., dimensions now being: Description of mark. *5/8" P.V. & 1/2" S/Steel* should be explicit, e.g., S/Steel Pillar Plate, Steel plug, Brass plug, Bolt, G.I. Pipe
 Height of mark.....m..... ^{above} rock/concrete; Mark is.....m..... ^{above} G.L.
 Height of Top Vanes to Top Mark/Pillar platem..... Diameter of Vanes (vertical).....m.....
 Height of Cairn.....m..... Diameter of Cairn.....m..... Name Plate found/not found/placed.
 Length of Mastm..... (approximate if not unplied)
4. A.....set in conc/rock has been placed/found, bearing.....°M from Mast/Plug/Pillar
5. A.....set in conc/rock has been placed/found, bearing.....°M from Mast/Plug/Pillar
6. A.....set in conc/rock has been placed/found, bearing.....°M from Mast/Plug/Pillar
7. A.....set in conc/rock has been placed/found, bearing.....°M from Mast/Plug/Pillar
8. Action required: *Clean regrowth 360°*.....

STANDPOINT:

STANDPOINT:

Mark	Direction	Horiz. Distance	Height Difference	Mark	Direction	Horiz. Distance	Height Difference
			above standpt.				above standpt.
			below				below
			above standpt.				above standpt.
			below				below
Prepared by: *Ally*

Checked:

Noted on U.T.M. Card


SF 2733-1

8-9-82

Checked

STATION: **URANIA**
 MAP SHEET: **GRAFTON**
 SCALE: **1:250 000**
 INSPECTED BY: **R. ELLIS**
 AUTHORITY: **C. M. A.**

No.: **4524**
 DATE: **23-7-82**
 FIELD BOOK: **2009**

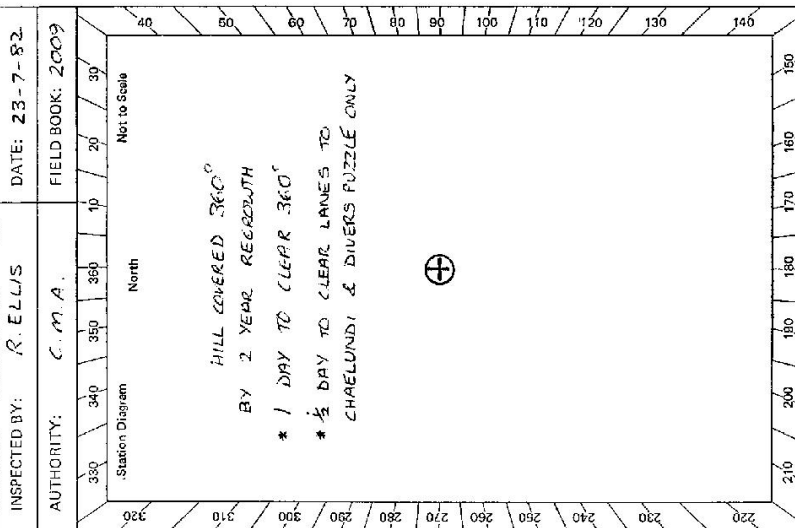

Checked

51.2735-2 D. WENT, GOVERNMENT PRINTER

Beacon Diagram	Not to Scale
<i>P, M & V in good condition</i>	
<i>NPAUS - Grafton Guy Holloway</i>	
<i>Walter Gannon started his interest in site or clearing on 26/7/82.</i>	
<i>Soul Care Services - Grafton.</i>	
<i>Mayor Gannon gave verbal permission for 360° clearing of vegetation 26/7/82.</i>	

This section to be completed by officer constructing pillar.

Original station mark found/not found.

Description of mark:

Original beacon found/not found.

Description of beacon:

Height Top of Vanes to Top Mark.....m.

Height of mark.....m. above rock/conc.....m. below G.L.

Diameter of Vanes.....m. Height of Cairn.....m.

Original Beacon has/had not been destroyed by me.

STATION

URAWA IS 6483

COUNCIL RECORDS

Owner's Name: C.G.P. BL SMITH

Address: PO BOX 177 J

Phone: COFFS HARB. BETTY 2451

Phone: (066) 52 1239

Current Occupant:

Address:

Phone:

ACCESS

Access Report of 19.8.1982 was found suitable/unsuitable.

Date

8-9-82

Record of Station

Mrs Smith gave verbal approval over the telephone that clearing of vegetation 360° around pillar can be commenced - fill

STATION URANIA G.S. TS 6483	<p> Business owner: <i>J.G. Smith Pty Ltd</i> Current Occupant: Address: Phone: </p> <p> New Owner's Name: <i>Walker, Frances & Co</i> Address: <i>1411, 109 Pitt St</i> Phone: <i>Sydney 2000 232 6526</i> </p> <p style="text-align: center;">ACCESS</p> <p> Access Report of <i>19.8/19.10</i> was found suitable/unsuitable. Feature: </p> <p> From <u>Crafton</u> On <u>Old Crafton Road</u>, through <u>Buccarumbi</u>, through <u>Dalmorton</u> to <u>Road tunnel</u> Continue toward <u>Elen James</u>. "Tunnel Creek" "Straight Creek" "Wintvale Creek" pass "Wintvale Road" on right "Sheep Station Creek" Grid Turn right, S.P. "Pine Tree Trail", follow track to top of range Top of range, S.P. "Pine Tree Trail" turn right. Turn left and follow track to trig. </p>
Beacon Diagram 	<p> This section to be completed by officer constructing pillar. Original station mark found/not found. </p> <p> Description of mark: </p> <p> Original beacon found/not found. </p> <p> Description of beacon: </p> <p> Height: Top of Vanes to Top Mark m. Height of mark m. above G.L. below G.L. Diameter of Vanes m. Height of Cairn m. Original Beacon has/has not been destroyed by me. </p>
Date	Records of Station
Date	Records of Station <i>With permission to carry out all necessary work granted by new owner (22/07/79, see PG 55/11/124) The owner requires repair describing the work carried out 6/79</i>