

TS. 6485  
No.: 3027

CENTRAL MAPPING AUTHORITY  
GEODETTIC SURVEY OF N.S.W.


GEODETTIC STATION RECONNAISSANCE and MAINTENANCE REPORT

STATION: FALLS G.S.

MAP SHEET SCALE 1:250 000  
INSPECTED BY: J. FANNING  
AUTHORITY: C.M.A.

DATE: 5th Sept 79  
FIELD BOOK: 1753

- Description:  
 1. Cleared by lanes bearing...  
 2. Mast & Vanes have been painted white & black respectively.  
 3. The station...  
 Description of mark...  
 Height of mark...  
 Height of Top Vanes to Top Mark/Pillar plate...  
 Height of Cairn...  
 Length of Mast...  
 4. A...  
 5. A...  
 6. A...  
 7. A...  
 8. Action required...

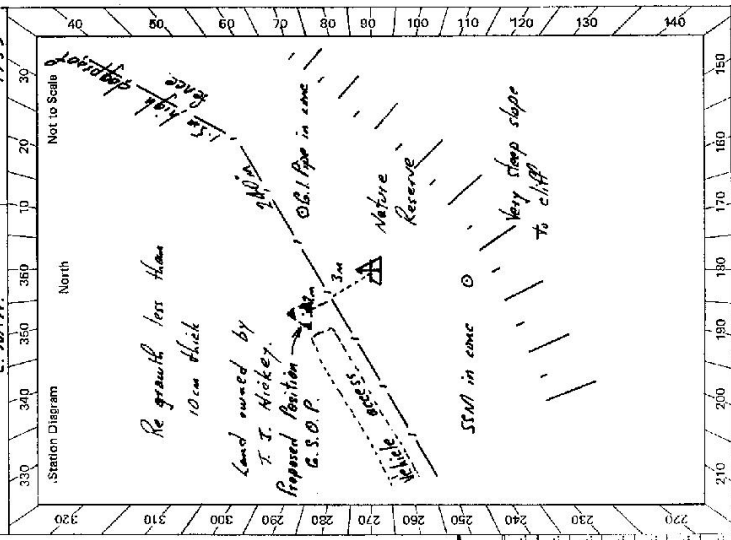

STANDPOINT:

Mark	Direction	Horiz. Distance	Height Difference	Mark	Direction	Horiz. Distance	Height Difference
			above standpt.				above standpt.
			below				below
			above standpt.				above standpt.
			below				below
Prepared by: J. Fanning  
 Checked: [Signature]  
 Noted on U.T.M. Card






STATION **FALLS PILLAR TS 6485**

Owner's Name: **T. J. HICKEY**  
 Address: **WEST WOOD (SEE ACCESS 7-77 AM)**  
 Phone: **WOLLONGONG 7 58 506**

Current Occupant:  
 Address:  
 Phone:

**ACCESS**

Access Report of 28/1/1971 was found suitable/unsuitable.  
**FROM GUYRA TRAVEL TOWARDS EBOR - GRAPTON**  
**0-0 SIGN WOLLONGONG GUYRA 32 EBOR 17 (MILES)**  
**0-2 CROSS KANGAROO CR**  
**6-0 TAKE TRACK TO LEFT THROUGH IRON GATE OPPOSIT MAIL BOX WITH**  
**NAME J. HICKEY**  
**6-92 IRON GATE PASS HOMES HEAD L.H.S (OWNERS HOUSE) HEAD NORTH**  
**7-77 IRON GATE FOLLOW DOWN AROUND FENCE**  
**7-88 TO WOOD GATE GO TO RIGHT UP FENCE AND OVER RIDGE**  
**8-19 WOOD GATE PASS FAINT TRACKS L.H.S**  
**8-72 IRON GATE FOLLOW FAINT TRACK TO LEFT DOWN GULLY (GULLY LINE IS L.H.S SOUTH)**  
**8-94 PASS DAM L.H.S**  
**8-96 IRON GATE FOLLOW FAINT TRACK TO LEFT DOWN GULLY (GULLY LINE IS L.H.S SOUTH)**  
**9-48 CROSS GULLY BLAZED TREES & TRACK**  
**9-62 SLITRAIL GATE**  
**10-47 AT BLAZED TREES FOLLOW TRACK TO RIGHT UP GULLY**  
**10-26 TURN LEFT OVER GULLY FOLLOW BLAZED TRACK TO TRAIL**  
**10-75 FALLS TRIC**

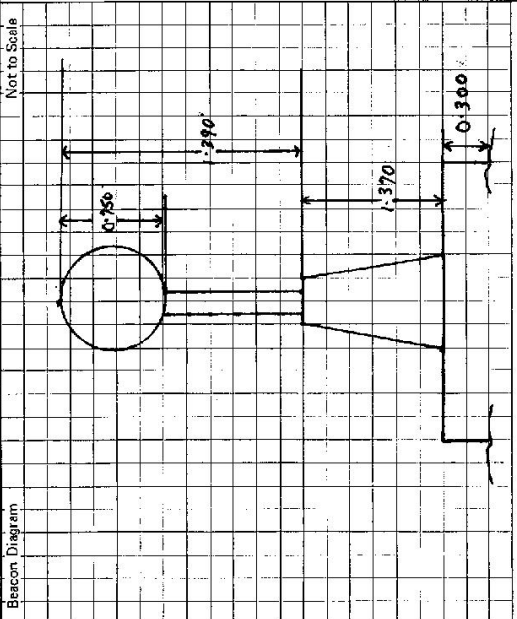

This section to be completed by officer constructing pillar.

Original station mark found/missing  
 Description of mark: **BRASS PLUG IN ROCK**  
 Original beacon found/missing  
 Description of beacon: **CAIRN MAST & VANES**  
 Height Top of Vanes to Top Mark: **4.000** m.  
 Height of mark: **0.35** m. above rock/above G.L. below G.L.  
 Diameter of Vanes: **0.915** m. Height of Cairn: **1.000** m.  
 Original Beacon has/has not been destroyed by me.

Date	Record of Station
	<b>PILLAR CONSTRUCTED ON T. J. HICKEY LAND</b>
	<b>ORIGINAL STATION IN RESERVE</b>