

CENTRAL MAPPING AUTHORITY

GEODETTIC SURVEY OF N.S.W.
GEODETTIC STATION RECONNAISSANCE and MAINTENANCE REPORT

Description:

1. Cleared by lanes bearing..... Note: Cross out word or words which do not apply
..... from Trig. Mast

2. Mast & Vanes have been painted white & black respectively.

3. The station/pillar was unpiled/~~not unpiled~~/~~concreted~~ on 3.2.72.....19....., dimensions now being:

Description of mark: Trig. Plug should be explicit, e.g., S/Steel Pillar Plate, Steel plug, Brass plug, Bolt, G.I. Pipe

Height of mark.....m. above rock/concrete; Mark is 0.35 m. ^{above}/_{below} G.L.

Height of Top Vanes to Top Mark/Pillar-plate 3.29 m. Diameter of Vanes (vertical) 0.215 m.

Height of Cairn.....m. Diameter of Cairn.....m. ~~Name Plate found/not found~~ placed.

Length of Mast.....m. (approximate if not unpiled)

4. G.I. Pipe set in conc/~~rock~~ has been placed/~~found~~, bearing 324 °M from ~~Mast/Plug/Pillar~~

5. A..... set in conc/rock has been placed/~~found~~, bearing..... °M from Mast/Plug/Pillar

6. A..... set in conc/rock has been placed/~~found~~, bearing..... °M from Mast/Plug/Pillar

7. A..... set in conc/rock has been placed/~~found~~, bearing..... °M from Mast/Plug/Pillar

8. Action required:.....

STANDPOINT:

STANDPOINT:

Mark	Direction	Horiz. Distance	Height Difference	Mark	Direction	Horiz. Distance	Height Difference
<u>Doughboy GS 0° 00' 00"</u>			above standpt. below				above standpt. below
<u>G.I. Pipe in conc 67° 25' 10" A 014 0.39%</u>			above standpt. below				above standpt. below
			above standpt. below				above standpt. below
			above standpt. below				above standpt. below
Prepared by:

Checked:

Noted on U.T.M. Card

SR 2733-1

STATION: EBOR No: 6487

MAP SHEET SCALE 1:250 000 DARRIGO

INSPECTED BY: A GRIGULLIS DATE: 3.2.72

AUTHORITY: Forestry Comm " FIELD BOOK: FC 18

Station Diagram

Not to Scale

Information from Forestry Commission
Angle Book 18, Table 37

NOTE: Direction to November GS was observed to the original Cairn, Mast & Vanes.

CENTRAL MAPPING AUTHORITY

GEODETTIC STATION RECONNAISSANCE and MAINTENANCE REPORT

Description: Note: Cross out word or words which do not apply

- 1. Cleared by lances bearing: from Trig. Mast
- 2. Mast & Vanes have been painted white & black respectively.
- 3. The station/pillar was applied/not unpiled/constructed on: 15.5 x 3.5 x 19.75, dimensions now being:
 Description of mark: ~~should be explicit~~, e.g., S/Steel Pillar Plate, Steel plug, Brass plug, Bolt, G.I. Pipe
 Height of mark: above rock/concrete; Mark is: above G.L.
- Height of Top Vanes to Top Mark/Pillar plate: m. Diameter of Vanes (vertical): 0.315 m.
- Height of Cairn: m. Diameter of Cairn: m. Name Plate found/not found/etched.
- Length of Mast: 2.815 m. (approximate if not unpiled)
- 4. A: set in conc/rock has been placed/found, bearing: ° M from Mast/Plug/Pillar
- 5. A: set in conc/rock has been placed/found, bearing: ° M from Mast/Plug/Pillar
- 6. A: set in conc/rock has been placed/found, bearing: ° M from Mast/Plug/Pillar
- 7. A: set in conc/rock has been placed/found, bearing: ° M from Mast/Plug/Pillar
- 8. Action required: Pillar to be constructed. Conc. base marks to be placed. Clearing to be done.

STANDPOINT:

Mark	Direction	Horiz. Distance	Height Difference	Mark	Direction	Horiz. Distance	Height Difference
			above standpt.				above standpt.
			below standpt.				below standpt.
			above standpt.				above standpt.
			below standpt.				below standpt.
Prepared by: [Signature] Checked: [Signature] Noted on U.T.M. Card

St 2733-1

STATION: E BOR

MAP SHEET: SCALE 1:280 000 DORRICO

INSPECTED BY: N KEANE

AUTHORITY: CMA

DATE: 15-6-74

FIELD BOOK: 1769

Station Diagram
Grid North
Not to Scale
Timber along ridge cut, outvision to west with
205 to 331 Falls at 155 3/4 visible above tree tops

Checked

GEODETIC SURVEY OF N.S.W.

CENTRAL MAPPING AUTHORITY

GEODETIC STATION RECONNAISSANCE and MAINTENANCE REPORT

STATION: **EBOR (PILLAR) G.S** No: **B-6487**
 MAP SHEET **DORRIGO**
 SCALE 1:250 000
 INSPECTED BY: **G. L. FORD** DATE: **29-10-79**
 AUTHORITY: **C.M.A** FIELD BOOK: **1682-**

Station Diagram

Not to Scale

Description:

Note: Cross out word or words which do not apply

- Cleared by lanes bearing... 32° ... $190^{\circ} 21'$... $227^{\circ} 53'$... $253^{\circ} 20'$... 298° from Trig. Mast $295^{\circ} - 306^{\circ}$
- Mast & Vanes have been painted white & black respectively. ✓
- The station/pillar was ~~unrepaired~~ constructed on... $12 - 10 - 1979$, dimensions now being: Description of mark ~~Steel Plate~~ should be explicit, e.g., S/Steel Pillar Plate, ~~Steel plate~~, Brass plug, Bolt, G.L. Pipe
 Height of mark... 3.50 m. above ~~rock/concrete~~ Mark is... 5.00 m. above G.L.
 Height of Top Vanes to Top ~~Mark/Pillar plate~~ ... 4.00 m. Diameter of Vanes (vertical)... 0.150 m.
 Height of Cairn... m. Diameter of Cairn... m. Name Plate ~~found/not found~~/placed.
 Length of Mast... 4.80 m. (approximate if not supplied)
- A. ~~CARTRIDGE CASE~~... set in ~~conc/rock~~ has been ~~placed~~/found, bearing... 45° M from ~~Mast/Plug~~/Pillar
- A. ~~COPPER NAIL~~... set in ~~conc/rock~~ has been placed/~~found~~, bearing... 22.9° M from ~~Mast/Plug~~/Pillar
- A. ... set in ~~conc/rock~~ has been placed/~~found~~, bearing... $^{\circ}$ M from Mast/Plug/Pillar
- A. ... set in ~~conc/rock~~ has been placed/~~found~~, bearing... $^{\circ}$ M from Mast/Plug/Pillar
- Action required:

STANDPOINT: CARTRIDGE CASE		STANDPOINT: CONCRETE PILLAR	
Mark	Direction	Mark	Direction
MAJORS POINT (P)	0 00 00	MAJORS POINT (P)	0 00 00
ROUND (P)	106 19 10	CARTRIDGE CASE	32 00 00
COPPER NAIL	163 34 10	ROUND (P)	106 17 20
CONC PILLAR	212 00 30	COPPER NAIL	112 39 50

Prepared by: **G.L. Ford 9th December 1979** Checked: **[Signature]** Noted on U.T.M. Card


Sr 2733-2 D. West Government Printer

STATION **E BOR (PILLAR) G.S. IS-6487**

Owner's Name: **DENNIS MULLER**
 Address: **GLEN ALVIE (AT 1.43 KM)**
E BOR
E BOR 33
 Current Occupant:
 Address:
 Phone:

ACCESS

Access Report of 15/1/1979 was found suitable/~~unsuitable~~
 0.00 km **E BOR** P.O. HEAD IN A **NORTHERLY DIRECTION TOWARDS DORRICO AND GRAFTON**
 0.91 **TURN LEFT ONTO GRAVEL TRACK PASSING THROUGH GATE AT 0.93**
 1.42 **VEER RIGHT FOLLOWING MAIN TRACK PAST TURN OFF TO "GLEN AVIE" (OWNERS RESIDENCE)**
 3.39 **CROSS GRID 3-67 CROSS BRIDGE**
 4.13 **TURN RIGHT THROUGH GATE AND HEAD IN AN EASTERLY DIRECTION TOWARDS AN IRON GATE**
 4.28 **PASS THROUGH IRON GATE AND IMMEDIATELY LEFT THROUGH WOODEN GATE AND THEN FOLLOW A FAINT TRACK UP SLOPE IN A N.W. DIRECTION AROUND BASE OF HILL**
 5.25 **CROSS STEEP GULLY CONTINUING ALONG FAINT TRACKS**
 6.19 **KEEPING THE DAM ON YOUR RIGHT AND SHEEP YAS ON THE LEFT TURN RIGHT FOLLOW RIDGE IN A SOUTHERLY DIRECTION**
 7.32 **E BOR G.S. (AND FROM 6.19 TO 7.32)**

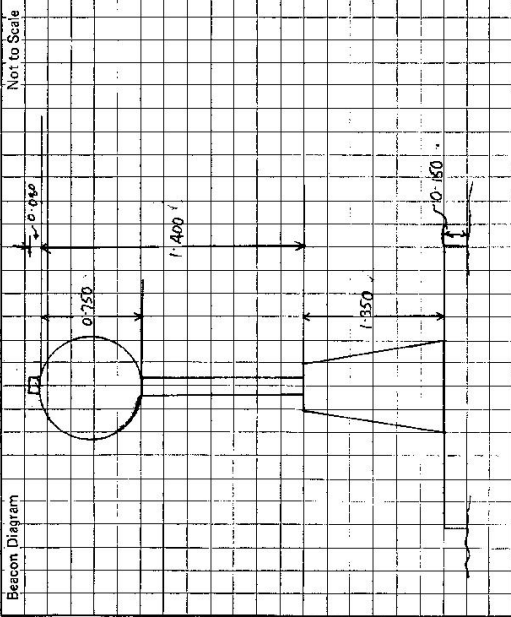

This section to be completed by officer constructing pillar.

Original station mark found/~~not found~~

Description of mark: **CARRIAGE CASE IN ROCK**

Original beacon found/~~not found~~

Description of beacon: **CARRIAGE CASE IN ROCK**

Height Top of Vanes to Top Mark: **3.090** m.

Height of mark: **0.085** m. above rock/~~below~~ **0.350** m. below G.L.

Diameter of Vanes: **0.015** m. Height of Cairn: **1.200** m.

Original Beacon has/~~has not~~ been destroyed by me.

Date	Record of Station