


STATION DOUGHBOY (PIGS) 6488

Owner's Name: G.A.W. PYLTON
 Address: 54 G.A. WRIGHT WONEWINDA (AT 30 kms)
 Phone: (061) 758575
 Current Occupant:
 Address:
 Phone:

ACCESS

Access Report of L.A. 19/2/19 was found suitable/unsuitable.

0.0 Km. E BOR P.O TRAVEL TOWARDS GUYRA
 0.49 CROSS BRIDGE OVER GUY FAWKES CREEK
 3.80 ARMIDALE TURN OFF ON LEFT CONTINUE STRAIGHT AHEAD COMING TO END OF BITUMEN
 20.85 BACK ONTO BITUMEN AGAIN
 27.35 TURN LEFT ONTO GRAVEL ROAD S.P. WOLLOMBRI 18 MILES.
 29.72 CROSS GRID STRAIGHT AHEAD PAST ROADON LEFT CROSSING GRIDS AT 28.23, 29.14, 29.71, 30.92, 32.48, AND 34.75
 34.87 CONTINUE STRAIGHT AHEAD PASSING TRACK TO OWNERS HOME L.H.S
 37.40 TURN LEFT IMMEDIATELY BEFOR GRID HEAD FOR WOODEN GATE
 39.45 THROUGH WOODEN GATE FOLLOWING FAINT TRACKS PAST SHEEPYDS R.H.S TO IRON GATE
 39.77 THROUGH IRON GATE VEERING LEFT PICK UP DOZED TRACK FOLLOW TRACK ROUND SOUTHERN SIDE TO 38.59 TURN UP HILL AFTER CLUMP OF TREES WORKING WAY UP STEEP HILL TO DOUGHBOY C.S. 39.16 (UP EAST SIDE) F.M.D.

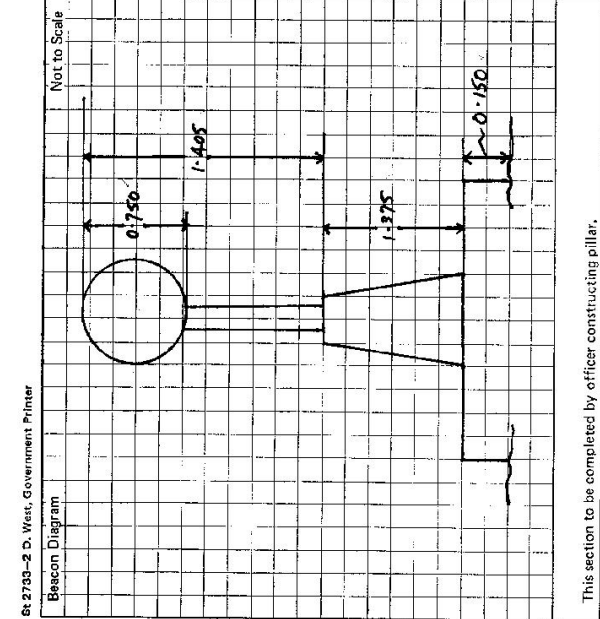

This section to be completed by officer constructing pillar.

Original station mark found/~~not found~~.....

Description of mark: BRASS PLUG IN ROCK

Original beacon found/~~not found~~.....

Description of beacon: CAIRN MAST & VANES

Height Top of Vanes to Top Mark 3.215 m.

Height of mark: 0.085 m. ^{above} rock/~~below~~ 0.235 m. ^{above} G.L. _{below}

Diameter of Vanes 0.095 m. Height of Cairn 1.400 m.

Original Beacon has/~~has not~~ been destroyed by me.

Date

Record of Station