

GEODETIC SURVEY OF M.S.W.

CENTRAL MAPPING AUTHORITY

GEODETIC STATION RECONNAISSANCE and MAINTENANCE REPORT

Description:

1. Cleared by lanes bearing..... Note: Cross out word or words which do not apply
2. Mast & Vanes have been painted white & black respectively.
3. The station/pillar was unpiled/not unpiled/constructed on..... 19....., dimensions now being:
  - Description of mark..... should be explicit, e.g., S/Steel Pillar Plate, Steel plug, Brass plug, Bolt, G.I. Pipe
  - Height of mark.....m. above below rock/concrete; Mark is.....m. above below G.L.
  - Height of Top Vanes to Top Mark/Pillar plate.....m. Diameter of Vanes (vertical).....m.
  - Height of Cairn.....m. Diameter of Cairn.....m. Name Plate found/not found/placed.
  - Length of Mast.....m. (approximate if not unpiled)
4. A..... set in conc/rock has been placed/found, bearing.....° M from Mast/Plug/Pillar
5. A..... set in conc/rock has been placed/found, bearing.....° M from Mast/Plug/Pillar
6. A..... set in conc/rock has been placed/found, bearing.....° M from Mast/Plug/Pillar
7. A..... set in conc/rock has been placed/found, bearing.....° M from Mast/Plug/Pillar
8. Action required: STATION ABOVE OF ALLEGEDLY PAKISH RECONSTRUCTION } Suggested  
 PHISHA OF SECOND CAN BE CONSIDER WITH ELMOS 3104 } altered to  
 STATION ABOVE OF SECOND CAN BE CONSIDER WITH ELMOS 3104 } GARANDH

STANDPOINT: G.I. PIPE PLACED


Mark	Direction	Horiz. Distance	Height Difference	Mark	Direction	Horiz. Distance	Height Difference
PINNACLES G.S.	Ø 00		above standpt.				above standpt.
ERBACAPRA G.S.	2 75		above standpt.				above standpt.
PHIL ANDREW HILL	53 56		below				below
MILK VALLEY HILL	78 39		above standpt.				above standpt.
GLORIOUS HILL	111 55		below				below
BURLEIGH G.S.	212 48		above standpt.				above standpt.
ACCAWIGH G.S.	227 00		below				below
ACRAE HILL	227 53		above standpt.				above standpt.
			below				below

Prepared by: *J. J. J.* Checked: *J. J. J.*

ST 2733-1 10-7-56

Noted on U.T.M. Card

Checked

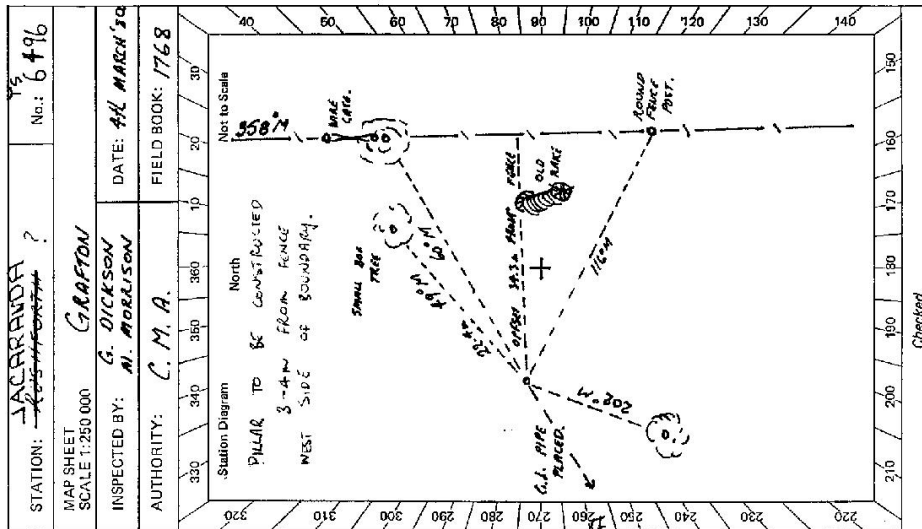

STATION: ~~JACARANDA~~ ?  
 MAP SHEET SCALE 1:250 000  
 INSPECTED BY: G. GIBSON  
 AUTHORITY: C. M. A.  
 DATE: 14 MARCH '56  
 FIELD BOOK: 1768  
 No: 6496



GEODEIC SURVEY OF N.S.W.

CENTRAL MAPPING AUTHORITY

GEODEIC STATION RECONNAISSANCE and MAINTENANCE REPORT

STATION: **JACARANDA (F)** TS No.: **6496**  
 MAP SHEET: **GRAFTON**  
 SCALE 1:250 000  
 INSPECTED BY: **H.C. BORDER** DATE: **25-4-80**  
 AUTHORITY: **C.M.A** FIELD BOOK: **01411**

Description:

- Cleared by lanes bearing **202° to 211°**, **225° to 227°**, **356° to 361°**, **07° to 09°** from Trig. Mast Pillar **11° to 14°**, **47° to 52°**, **60° to 62°**, **68° to 72°** **North**.
- Mast & Vanes have been painted white & black respectively. ✓
- The ~~station~~/pillar was ~~unplaced/not unplaced~~/constructed on **24<sup>th</sup> APRIL**.....**1980**..... dimensions now being:  
 Description of mark: **S/S Pillar**. **Plate** should be explicit, e.g., S/Steel Pillar Plate, Steel plug, Brass plug, Bolt, G.I. Pipe  
 Height of mark.....**1.370**.....m. <sup>above</sup> ~~below~~ Mark is **1.470**.....m. <sup>above</sup> ~~below~~ G.L.  
 Height of Top Vanes to Top ~~Mark~~/Pillar plate **1.400**.....m. Diameter of Vanes (vertical).....**0.765**.....m.  
 Height of ~~Gairn~~.....m. Diameter of ~~Gairn~~.....m. Name Plate ~~found~~/not found/placed.  
 Length of Mast.....**1.480**.....m. (approximate if not unplaced)
- COPPER NAIL**.....set in conc/~~rock~~-has been placed/~~found~~, bearing.....**34**.....°M from Mast/Plug/Pillar
- G.I. PIPE**.....set in conc/~~rock~~ has been placed/~~found~~, bearing.....**0**.....°M from Mast/Plug/Pillar
- A STEEL DECK SPIKE**.....set in ~~ground~~/~~rock~~ has been placed/~~found~~, bearing.....**324**.....°M from Mast/Plug/Pillar
- A.....set in conc/~~rock~~ has been placed/~~found~~, bearing.....°M from Mast/Plug/Pillar
- Action required: **Place a ~~new~~ Plate**.....

STANDPOINT: <b>CONC. OBS. PILLAR</b>				STANDPOINT: <b>COPPER NAIL</b>			
Mark	Direction	Horiz. Distance	Height Difference	Mark	Direction	Horiz. Distance	Height Difference
<b>EDGE COMBE</b> OP	<b>359 59 60</b>		above standpt.	<b>EDGE COMBE</b> OP	<b>359 59 60</b>		above standpt.
<b>COPPER NAIL</b>	<b>34 46 20</b>	<b>2.690</b>	below	<b>GLENUGIE</b> OP	<b>109 59 40</b>		below standpt.
<b>GLENUGIE</b> OP	<b>109 59 00</b>		below	<b>BLAYLAND</b> T.S	<b>210 43 40</b>		below standpt.
<b>BLAYLAND</b> T.S	<b>210 43 20</b>		below	<b>ROCK VIEW</b> OP	<b>224 53 40</b>		below standpt.
<b>ROCK VIEW</b> OP	<b>224 53 40</b>		below	<b>STEEL DECK SPIKE</b>	<b>289 29 50</b>	<b>4.509</b>	above standpt.
<b>STEEL DECK SPIKE</b>	<b>373 49 40</b>	<b>4.601</b>	below	<b>G.I. PIPE</b>	<b>348 02 40</b>	<b>7.416</b>	below
<b>G.I. PIPE</b>	<b>359 59 40</b>	<b>9.465</b>	below				


Prepared by: **H.C. BORDER**

Checked:

Noted on U.T.M. Card

84 2733-2 D. West, Government Printer

STATION **JACARANDA** T.D. **6496**

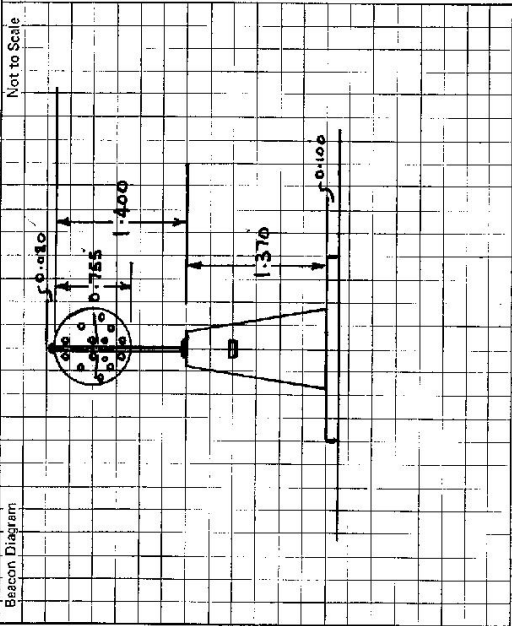

\* Owner's Name: **Mr. CHRIS HALL**  
 Address: **9 BARRAGO ST. WALLSEND**  
 Phone: **049 514250**

Occupant: **MR. R. J. & MRS. A. READMAN**  
 Address: **257 RYAN ST. S.H. CARFTON**  
 Phone: **421603**

Stays with: **Mr. PETER LAW, CARFTON**

ACCESS

Access Report of **1/4/19** was found suitable.

\* **NEW OWNERS: I.A. & S.M. Steele,**  
 -live in a house 60m from the G.S.  
 (advice received from the C.T.S.)

This section to be completed by officer constructing pillar.

Original station mark found/not found.  
 Description of mark: **( NEW STATION )**  
 Original beacon found/not found.  
 Description of beacon .....  
 Height Top of Vanes to Top Mark ..... m.  
 Height of mark ..... m. above/below rock/conc. above/below pylon  
 Diameter of Vanes ..... m. Height of Cairn ..... m.  
 Original Beacon has/has not been destroyed by me.

Date	Record of Station