

CENTRAL MAPPING AUTHORITY

GEODETTIC SURVEY OF N.S.W.
GEODETTIC STATION RECONNAISSANCE and MAINTENANCE REPORT

Description:

Note: Cross out word or words which do not apply

1. Cleared by James bearing $345^{\circ} 10'$ tall, evenly spaced, ~~swt. hill~~ from Trig. Mast
 2. Mast & Vanes have been painted white & black respectively, ✓
 3. The station/pillar was unpiled/not unpiled/constructed on 17.3 x 38 19.7 x 9 dimensions now being: Description of mark: should be explicit, e.g., S/Steel Pillar Plate, Steel plug, Brass plug, Bolt, G.I. Pipe
- Description of mark: should be explicit, e.g., S/Steel Pillar Plate, Steel plug, Brass plug, Bolt, G.I. Pipe
- Height of mark: m. above rock/concrete; m. below G.L.
- Height of Top Vanes to Top Mark/Pillar plate m. Diameter of Vanes (vertical) 0.9 x 3 m.
- Height of Cairn m. Diameter of Cairn m. Name Plate found/not found/placed.
- Length of Mast m. (approximate if not unpiled) ✓
4. A set in conc/rock has been placed/found, bearing $287^{\circ} 0'$ M from Mast/Plug/Pillar
 5. A set in conc/rock has been placed/found, bearing $159^{\circ} 12'$ M from Mast/Plug/Pillar
 6. A set in conc/rock has been placed/found, bearing M from Mast/Plug/Pillar
 7. A set in conc/rock has been placed/found, bearing M from Mast/Plug/Pillar
 8. Action required: Trig. to be replaced cleared (next day clearing)

STANDPOINT:

| Mark | Direction | Horiz. Distance | Height Difference | Mark | Direction | Horiz. Distance | Height Difference |
|------|-----------|-----------------|-------------------|------|-----------|-----------------|-------------------|
| | | | above standpt. | | | | above standpt. |
| | | | below | | | | below |
| | | | above standpt. | | | | above standpt. |
| | | | below | | | | below |
Prepared by: M. V. ...

Checked: ... Noted on U.T.M. Card

S: 3733-1

STATION: BORAN GS No.: 6499
 MAP SHEET SCALE 1:250 000 DORRIGU
 INSPECTED BY: N. WAHE DATE: 12.6.79
 AUTHORITY: C.M.A FIELD BOOK: 1769


Station Diagram

NO HILLS TO THE NORTH IDENTIFIED.
 AFTER CLEARING 30% VISIBILITY TO THE NORTH WILL BE GOOD. NO NEAR RIDGES

CONCORDY TO THE REPORT OF 11-7-77 VANES AND MAST APPEARED TO HAVE BEEN INTACT SINCE 1973 AT LEAST - ACCORDING TO STATION

Checked

2733-2 D. West, Government Printer

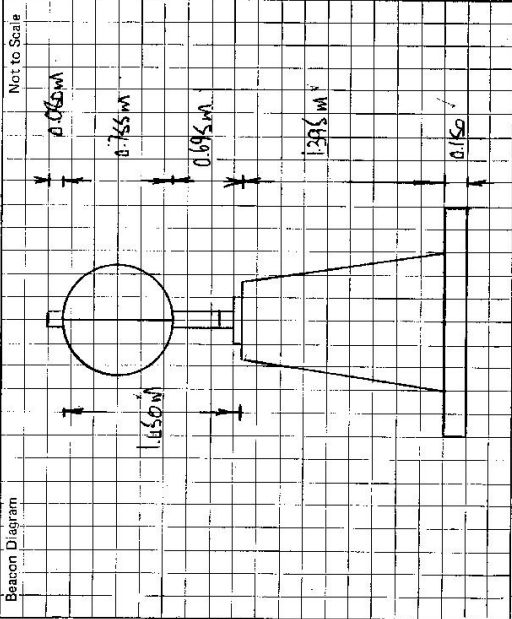

This section to be completed by officer constructing pillar.

Original station mark found/~~not found~~.

Description of mark: *Black concrete pillar*

Original beacon found/~~not found~~.

Description of beacon: *Black x 1.5m*

Height Top of Vane to Top Mark: *3.475* m.

Height of mark: *0.10* m. above ~~mark~~ *0.02* m. below G.L.

Diameter of Vane: *0.06* m. / Height of Cairn: *1.140* m.

Original Beacon has ~~been~~ been destroyed by me.

STATION *Bebeni Hill* 6499

Owner's Name: *NATIONAL PARKS ADMINISTRATION*

Address:

Phone:

Current Occupant:

Address:

Phone:

Access Report of *27.2.1988* was found suitable/unsuitable.


ACCESS BY N KARHE 12.8.79.

FIELD BOOK 176A

WAS FOUND SUITABLE.

| Date | Record of Station |
|------|-------------------|
| | |
| | |
| | |
| | |

2733-2 D. West, Government Printer

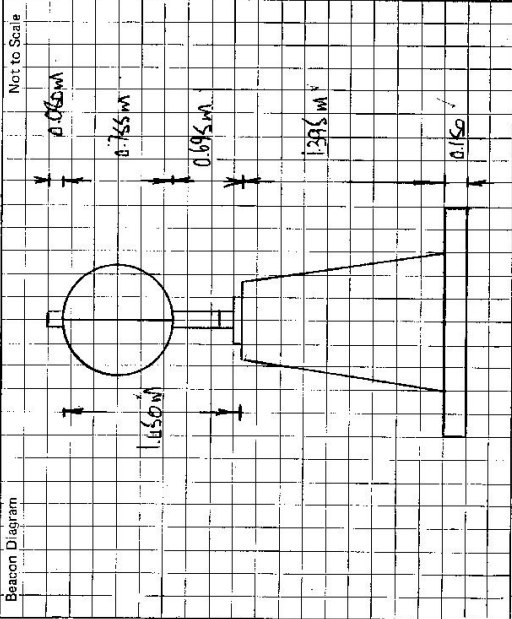

This section to be completed by officer constructing pillar.

Original station mark found/~~not found~~.

Description of mark: *Black concrete pillar*

Original beacon found/~~not found~~.

Description of beacon: *Black x 1.5m*

Height Top of Vane to Top Mark *3.475* m.

Height of mark *0.10* m above ~~mark~~ *0.02* m below G.L.

Diameter of Vane *0.06* m. Height of Cairn *1.140* m.

Original Beacon has ~~not~~ been destroyed by me.

STATION *Bebani Hill* 6499

Owner's Name: *NATIONAL PARKS ADMINISTRATION*
 Address:
 Phone:
 Current Occupant:
 Address:
 Phone:

Access Report of *27.2.1988* was found suitable/unsuitable. *ACCESS*

*ACCESS BY N KARHE 12.8.79.
 FIELD BOOK 176A
 WAS FOUND SUITABLE.*

| Date | Record of Station |
|------|-------------------|
| | |
| | |
| | |
| | |