


6503

STATION GARDNER GULLY TS 6503

Owner's Name: Emy, Maskey Current Occupant: Parisa A.
 Address: Manningham (at 4.615 km) Address: Manningham
 Phone: Guyana Phone: Guyana

ACCESS 8-6-1979

Access Report of A./M./1870 was found suitable/unavailable.
 0.0 km Guyra PD Head in a northerly direction along Bradley St 0.37 Turn right into Oletta St across railway line
 0.51 Cross New England highway and continue towards Ebar / 0.45 Veer left continuing on road towards Ebar ✓
 4.67 Turn left towards Nads Mistake Backwater and follow between road: 22.63 End of R. Turnen ✓
 23.01 Pass turn off to the left 25.46 and 33.35 Pass turnoffs to the right 350.8 Pass folly lane on the left ✓
 38.93 Grid 3042 Straight ahead past Abayile turn off on right 40.49 Grid 4056 Turn right into Paddy's Lane Road ✓
 46.15 Turn left at T-intersection 47.09 Pass through gate and over causeway at 47.16 Take right fork ✓
 49.77 Pass through wooden gate 53.68 Pass through iron gate ✓
 54.51 Turn off road onto faint track on right, down gully through clearing ✓
 54.74 Fence line - pass through left hand set of sliprings and then in an easterly direction across gully at 54.81 ✓
 Continue up slope in an easterly direction picking up the track on the southern side of ✓
 an E.W. gully - follow the track up the slope ✓
 56.01 Track veers right into a clearing - Trig knoll is straight ahead - it is easiest approached ✓
 by circling around the east of knoll and diving to trig from the south ✓
 56.31 GARDNER G.S.

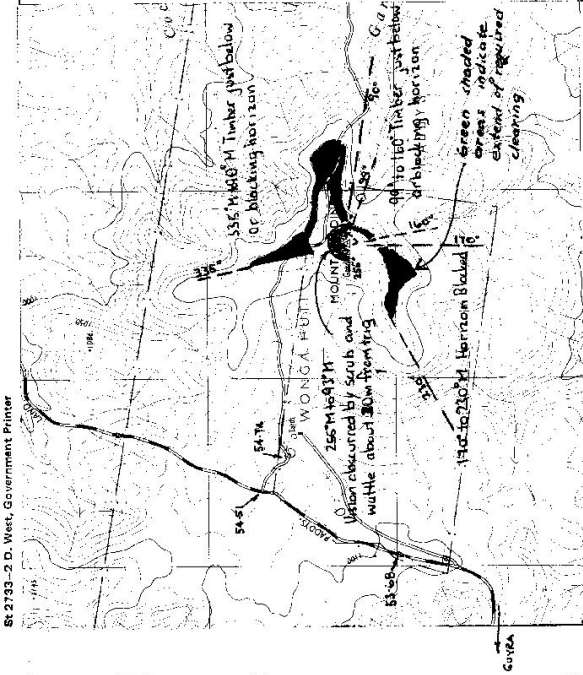

Original station mark found/not found.

Description of mark:

Original beacon found/not found.

Description of beacon:

Height: Top of Vane to Top Mark:m.

Height of mark:m. above G.L. /m. below

Diameter of Vane:m. Height of Cairn:m.

Original Beacon has/has not been destroyed by me.

Date	Record of Station
	Rod Clark from the Forestry office Armadale was contacted regarding clearing within Paddy's Lane Road. He would prefer that we only cleared lanes and any saleable timber is cut to contact him. There is no boundary fence between portion 1 and Strive Forest so the Koochibocki 1:25000 map will be required. Permission has been obtained to clear 360° within portion 1 and to build a concrete pillar not necessary to contact GARDNER G.S.

GS 24

<p>STATION GARDINER GS (PILLAR) 6503^{TS}</p>	<p>Owner's Name: ERNY MASKEY</p> <p>Address: MORNINGTON (AT 44.5 Km)</p> <p>Phone: GUYRA</p> <p>Current Occupant: P. A. S. E. L. L.</p> <p>Address: MORNINGTON</p> <p>Phone: GUYRA</p> <p>ACCESS</p> <p>Access Report of 8.16.1979 was found suitable/unsuitable.</p>
<p>Beacon Diagram</p> <p style="text-align: right;">Not to Scale</p>	<p>This section to be completed by officer constructing pillar.</p> <p>Original station mark found/not found.</p> <p>Description of mark: CARTER CASE IN CONE</p> <p>Original beacon found/not found.</p> <p>Description of beacon: CAIRN MAST & VANES</p> <p>Height Top of Vanes to Top Mark: 3.466 m. ^{above} G.L. ✓</p> <p>Height of mark: 0.65 m. ^{above} mark ^{below} base G.L. ✓</p> <p>Diameter of Vanes: 0.95 m. ✓ Height of Cairn: 1.00 m. ✓</p> <p>Original Beacon has/has been been destroyed by ma.</p>
	<p>Date</p> <p>Record of Station</p>