

CENTRAL MAPPING AUTHORITY
Department of Lands

Trigonometrical Survey of N.S.W.

RECONNAISSANCE and MAINTENANCE REPORT

STATION LEMON TREE TS 6505

This Trig. Station has been:-

Note: Cross out word or words which do not apply

1. Completely cleared to permit 360° vision to surrounding Trig.
2. Cleared by lanes bearing..... from Trig. Mast
3. Trig. Mast & Vanes have been painted white & black respectively.
4. The Trig. was unpiled/not unpiled, dimensions now being:

Description of mark..... should be explicit, e.g. Steel plug, Brass plug, Bolt, G.I. Pipe

Height of mark..... m ^{above} / _{below} rock/concrete m ^{above} / _{below} G.I.

Height of Top Vanes to Top Mark..... m. Diameter of Vanes (vertical)..... m.

Height of Cairn..... m. Diameter of Cairn..... m.

Length of Mast..... m. (approximate if not unpiled)

5. A..... set in conc/rock has been placed..... m. bearing.....°M from Trig. Mast

6. A..... set in conc/soil has been placed..... m. bearing.....°M from Trig. Mast

7. A..... set in conc/soil has been placed..... m. bearing.....°M from Trig. Mast

8. A..... set in conc/rock has been placed..... m. bearing.....°M from Trig. Mast

9. Connection..... to..... m. bearing.....°M

10. Connection..... to..... m. bearing.....°M

11. Connection..... to..... m. bearing.....°M

12. Connection..... to..... m. bearing.....°M

13. Diff. Ht. is..... m. ^{above} / _{below}.....

14. Diff. Ht. is..... m. ^{above} / _{below}.....

15. Diff. Ht. is..... m. ^{above} / _{below}.....


16. Diff. Ht. is..... m. ^{above} / _{below}.....

Prepared by: *[Signature]* Checked: *[Signature]* Noted on U.T.M. Card

Co: GREENHAM
Map Sheet: NEWTON ROAD 1:100,000
Inspected by: K.S. HARRISON
Authority: C.M.A.

Phi: WELINGTON
No: 933B
Date: 3-6-77
Field Book: -

Beacon Diagram
Not to Scale

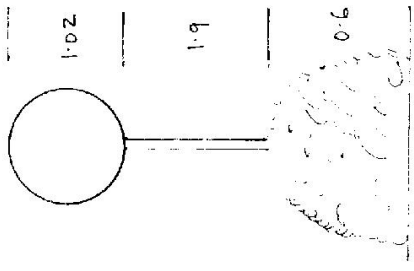

Date
Record of Station

Checked


TS 6505

STATION: LEMON TREE C.S.
 MAP SHEET 1:25000 MOUNT WELLINGTON 9338-1-3
 SCALE 1:250 000 GRAFTON SH 56-6

INSPECTED BY: K. THOMPSON
 DATE: 12-5-1979
 FIELD BOOK: 1752/8

Authority: CMA

Description:
 1. Cleared by lanes bearing.....
 Note: Cross out word or words which do not apply
 2. Mast & Vanes have been painted white & black respectively.
 3. The station/pillar was ~~unplaced~~ not unplaced/connected on 12th MAY 1979, dimensions now being:
 Description of mark.....should be explicit, e.g., S/Steel Pillar Plate, Steel plug, Brass plug, Bolt, G.I. Pipe
 Height of mark.....m. above/below rock/concrete; Mark is.....m. above/below G.L.
 Height of Top Vanes to Top Mark/Pillar-plate 3.5 m. Diameter of Vanes (vertical) 1.02 m.
 Height of Cairn.....m. Diameter of Cairn 1.7 m. Name Plate ~~found~~/not found/~~placed~~.
 Length of Mast 3.52 m. (approximate if not unplaced)
 4. A. G.I. Pipe.....set in conc/rock has been ~~placed~~/found, bearing 75° M from Mast/Plug/Pillar
 5. A. Copper Nail.....set in conc/rock has been ~~placed~~/found, bearing 150° M from Mast/Plug/Pillar
 6. A.....set in conc/rock has been placed/round, bearing.....° M from Mast/Plug/Pillar
 7. A.....set in conc/rock has been placed/round, bearing.....° M from Mast/Plug/Pillar
 8. Action required: Cleaning - less than a day. Can be pillared.

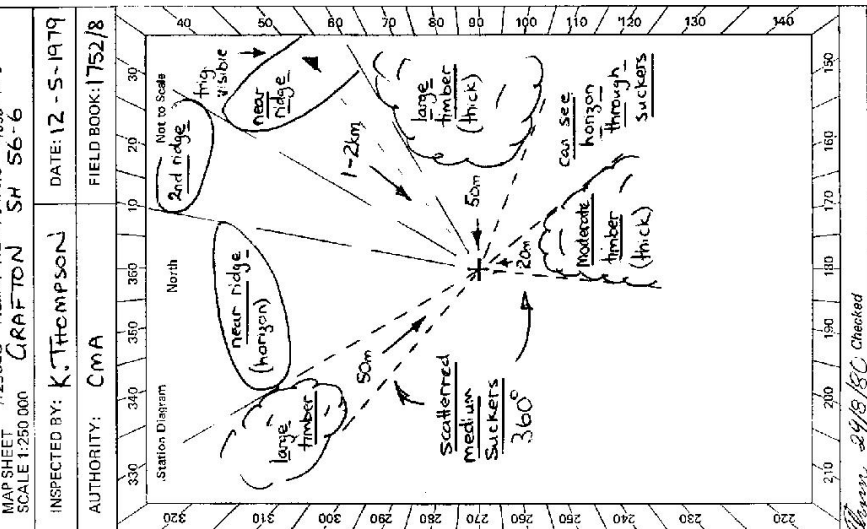


STANDPOINT:

Mark	Direction	Horiz. Distance	Height Difference	Mark	Direction	Horiz. Distance	Height Difference
			above standpt.				above standpt.
			below				below
			above standpt.				above standpt.
			below				below
Prepared by: K. Thompson
 Checked: G. Johnson 21/9/79
 Not on U.T.M. Card
 Checked: 24/8/80

8c 2733-2 D. West, Government Printer

STATION LEMON TREE C.S. TS 6506

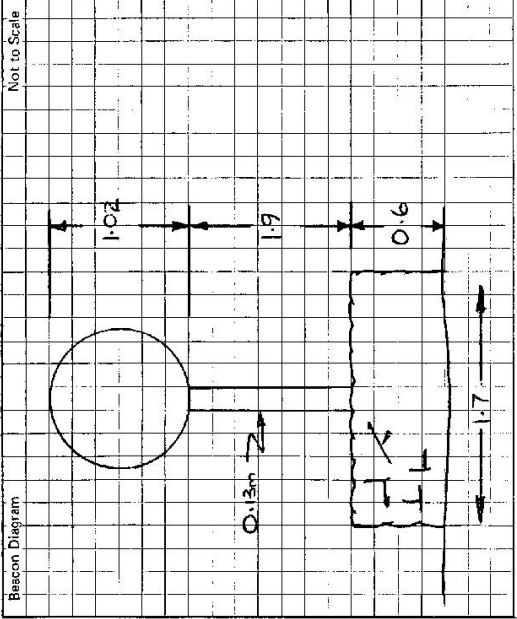

Owner's Name: COLE, HARRISON, DISTRICT
 Address: FORESTRY COMMISSION
 DELMARSDALE STATE FOREST
 Phone:
 Current Occupant:
 Address:
 Phone:
 ACCESS
 from location of 677
 Access Report of 19 was found suitable for construction.
 Alternative Access from Glen Innes:
 73-4 Take right-hand fork
 74-35 straight ahead, post turn off on right
 for Barool C.S.
 81-0 straight ahead, S.P. 'Old Barney Fire Trail'
 off to right.
 84-85 Turn left at blazed tree on top of hill,
 follow blazed track to trig.
 86-4-5 Lemon Tree C.S.
 Glen Innes P.O., head east towards Crofton
 straight ahead, post 'Old Crofton Road'
 Gibralter Range Forestry Headquarters on right
 Turn right, S.P. 'NARVALA FOREST ROAD'
 take left fork
 straight ahead
 take left fork
 turn left after crossing culvert
 straight ahead
 take left fork
 straight ahead; post 'Woods Road'
 straight ahead
 straight ahead
 follow main track around to left
 post turn off to Geraldson Trig.
 take left fork
 Iron gate
 Ford through Mann River

This section to be completed by officer constructing pillar.
 Original station mark found/not found.
 Description of mark:
 Original beacon found/not found.
 Description of beacon:
 Height Top of Vane to Top Markm.
 Height of markm. above G.L.
m. below rock/cone
 Diameter of Vanem. Height of Cairnm.
 Original Beacon has/has not been destroyed by me.

Date	Record of Station
3/9/79	Verbal permission granted by the Director of Forestry, Adelaide. (P.O. 57/47)

86-2733-2 D. West, Government Printer

STATION **LEMON TREE C.S (P) 6505**

Owner's Name: **COFFEY HARBOUR DISTRICT FORESTRY COMM**
 Address: **DALMOREN STATE FOREST**
 Phone:


Current Occupant:

Address:

Phone:

ACCESS

FROM GLEN INNES
 Access Report of 12/5/19 was found suitable/unsuitable, ALTERNATE ROSS FROM GRAPTON.
 GRAPTON P.D TRAVEL SOUTH OVER BRIDGE.
 TURN RIGHT ONTO GLEN INNES ROAD.
 TURN LEFT ONTO OLD CARRIAGES ROAD
 CROSS WOODEN BRIDGE.
 CROSS BRICKWORK BRIDGE.
 TURN RIGHT ONTO CONGLEONG FOREST ROAD
 CROSS GRAD
 TURN RIGHT THROUGH WOODEN GATE
 TAKE RIGHT FORK
 CROSS CROSSINGS 62.6, 63.5, 64.3, 64.9, 66.5.
 PASS DEBOY FIRE TRAIL ON RIGHT.
 THROUGH GATE AND THEN VEER RIGHT.
 CREEK CROSSINGS 70.2, 71.0, 73.5, 74.0, 77.4, 77.7.
 THROUGH GATE 78.4, 78.7, 79.3, 79.4, 80.7.
 CROSS CREEK
 TURN RIGHT THROUGH FENCE SWN "CONGLEONG FIRE TRAIL"
 CROSS CREEK + FOLLOW TRACK UP HILL
 TURN RIGHT AND FOLLOW FAINT TRACK AT BLAZED TREE
 LEMON TREE C.S (P)

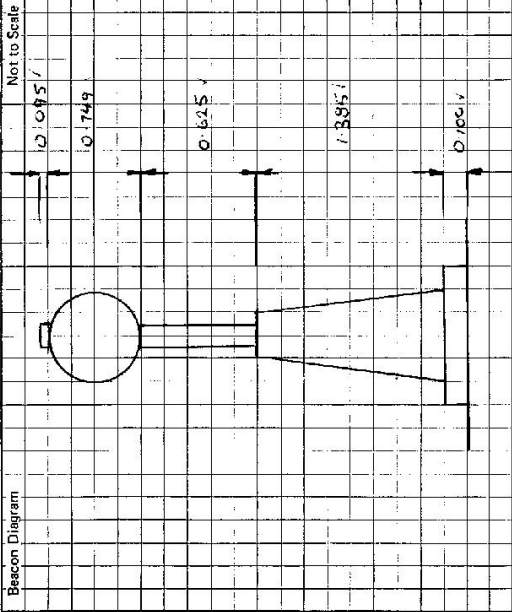

This section to be completed by officer constructing pillar.

Original station mark found/~~not found~~.

Description of mark: **SLS TRIG PIN IN CONG.**

Original beacon found/~~not found~~.

Description of beacon: **CAIRN PILE 10x5x3**

Height Top of Vanes to Top Mark **2.668** m.

Height of mark **0.27** above **conc** m. **AR** above G.L. **below**

Diameter of Vanes **1.660** m. • Height of Cairn **2.980** m.

Original Beacon has/~~has not~~ been destroyed by me.

Date	Record of Station