

CENTRAL MAPPING AUTHORITY

GEODETIC SURVEY OF INS.M

GEODETIC STATION RECONNAISSANCE and MAINTENANCE REPORT

STATION: **Ashbridge** No.: **651**

MAPSHEET SCALE 1:250 000 **NARRANDERA**

INSPECTED BY: **G. KEEP** DATE: **22-7-82**

AUTHORITY: **C.M.A.** FIELD BOOK:

Description:
 1. Cleared by lanes bearing.....
 Note: *Cross out word or words which do not apply*
 from Trig. Mast

2. ~~Mast & Vanes have been painted white & black respectively.~~

3. The station/pillar was ~~unpiled/not unpiled/constructed~~ on **22nd July 1982**, dimensions now being:

Description of mark.....should be explicit, e.g. S/Steel Pillar Plate, Steel plug, Brass plug, Bolt, G.I. Pipe

Height of mark.....m. ^{above}/_{below} rock/concrete; Mark is.....m. ^{above}/_{below} G.L.

Height of Top Vanes to Top Mark/Pillar platem. Diameter of Vanes (vertical).....m.

Height of Cairn.....m. Diameter of Cairn **2.1** Name Plate found/hot found/placed, **No name plate - name stamped on vanes**

Length of Mastm. (approximate if not unpiled)

4. A.....set in conc/rock has been placed/found, bearing.....°M from Mast/Plug/Pillar

5. A.....set in conc/rock has been placed/found, bearing.....°M from Mast/Plug/Pillar

6. A.....set in conc/rock has been placed/found, bearing.....°M from Mast/Plug/Pillar

7. A.....set in conc/rock has been placed/found, bearing.....°M from Mast/Plug/Pillar

8. Action required... **New mast & some clearing necessary. No marks found. Tachometer needed if pillar requires.**

STANDPOINT:


STANDPOINT:

Mark	Direction	Horiz. Distance	Height Difference	Mark	Direction	Horiz. Distance	Height Difference
			above standpt.				above standpt.
			below				below
			above standpt.				above standpt.
			below				below
Prepared by: **Geoffrey Keep 10.82** Checked:

Noted on U.T.M. Card

SI 2733-1

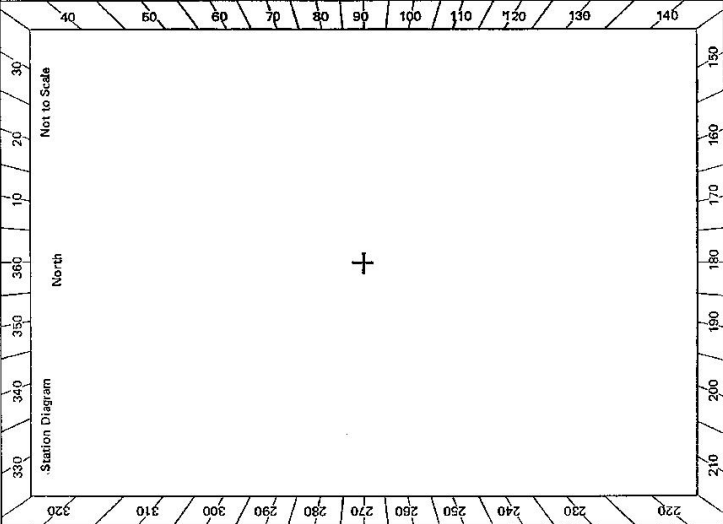

SI 2733-2 D. West, Government Printer


STATION **ASHBRIDGE - 651**

Owner's Name:
 Address:
 Phone:

Current Occupant:
 Address:
 Phone:

ACCESS

Access Report of 27.7.1982 was found suitable/unsuitable,
 For access see Begalong Hills 1:50 000

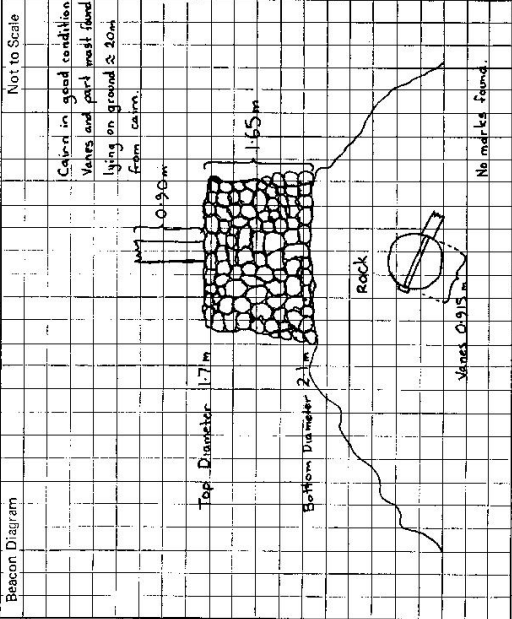

This section to be completed by officer constructing pillar.

Original station mark found/not found.

Description of mark:

Original beacon found/not found.

Description of beacon:

Height Top of Vanes to Top Mark.....m.
 above below
 Height of mark.....m. above G.L. below
 rock/conc
 Diameter of Vanesm. Height of Cairnm.
 Original Beacon has/has not been destroyed by me.

Date

Record of Station