

GEODETIC SURVEY OF M.S.W.

CENTRAL MAPPING AUTHORITY

GEODETIC STATION RECONNAISSANCE and MAINTENANCE REPORT

Description:

1. Cleared by lanes bearing.....
 Note: Cross out word or words which do not apply
 from Trig. Mast

2. Mast & Vanes have been painted white & black respectively. ✓

3. The station/pillar was applied/not unpiled/constructed on.....
 dimensions now being:

Description of mark.....
 should be explicit, e.g., S/Steel Pillar Plate, Steel plug, Brass plug, Bolt, G.I. Pipe

Height of mark.....
 above below rocks/concrete; Mark is.....m. above below G.L.

Height of Top Vanes to Top Mark/Pillar plate.....m. Diameter of Vanes (vertical) 0.912.....m.

Height of Cairn.....m. Diameter of Cairn.....m. Name Plate found/not found/placed.

Length of Mast.....m. (approximate if not unpiled)

4. A.....
 set in conc/feet has been placed/found, bearing.....°M from Mast/Pillar

5. A.....
 set in conc/feet has been placed/found, bearing.....°M from Mast/Pillar

6. A.....
 set in conc/rock has been placed/found, bearing.....°M from Mast/Plug/Pillar

7. A.....
 set in conc/rock has been placed/found, bearing.....°M from Mast/Plug/Pillar

8. Action required:.....
 Pillar to be placed.....

STANDPOINT:

| Mark | Direction | Horiz. Distance | Height Difference | Mark | Direction | Horiz. Distance | Height Difference |
|------|-----------|-----------------|-------------------|------|-----------|-----------------|-------------------|
| | | | above standpt. | | | | above standpt. |
| | | | below | | | | below |
| | | | above standpt. | | | | above standpt. |
| | | | below | | | | below |

Prepared by: n. v. s. d. e.

Checked:

7/9/73

Noted on U.T.M. Card

S: 2753-1

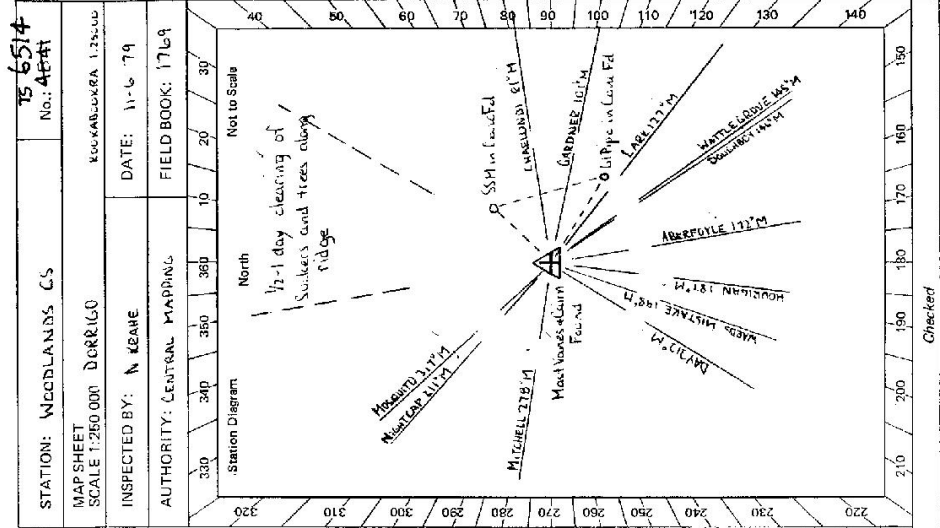

Checked

| | |
|--|--|
| STATION WOODLANDS PULAU | <p>MANAGER BOYKES Current Occupant: KARANGANGORAH Address: AMARALE Phone: 757300</p> <p>Owner's Name: CLIVE WINTER - IRVING PARTNERSHIPS Address: KARANGANGORAH Phone: 757300</p> <p>ACCESS Access Report of 11/6/79 was found suitable/unsuitable.</p> |
| Beacon Diagram Not to Scale | <p>The diagram shows a cross-section of a beacon on a grid. It consists of a circular top section with a diameter of 0.150 units. Below this is a vertical section with a total height of 1.400 units. A horizontal line is drawn at a height of 1.375 units from the base, and the section above this line is shaded. The diameter of the beacon at this level is also indicated as 0.150 units.</p> |
| This section to be completed by officer constructing pillar. | |
| Original station mark found/ not found . | |
| Description of mark: CARRIAGE CASE IN ROCK | |
| Original beacon found/ not found . | |
| Description of beacon: CARRIAGE CASE IN ROCK | |
| Height Top of Vanes to Top Mark: 3.650 m. | |
| Height of mark: 0.375 m. <small>above rock/above</small> AT <small>below</small> G.L. | |
| Diameter of Vanes: 0.915 m. <small>Height of Cairn</small> 1.200 m. | |
| Original Beacon has/ has not been destroyed by me. | |
| Date | Record of Station |

