


STATION BLAIR HILL TS. 6515

Owners Name..... Current Occupant.....

Address..... Address.....

Not to Scale

Station Diagram
Magnetic
North

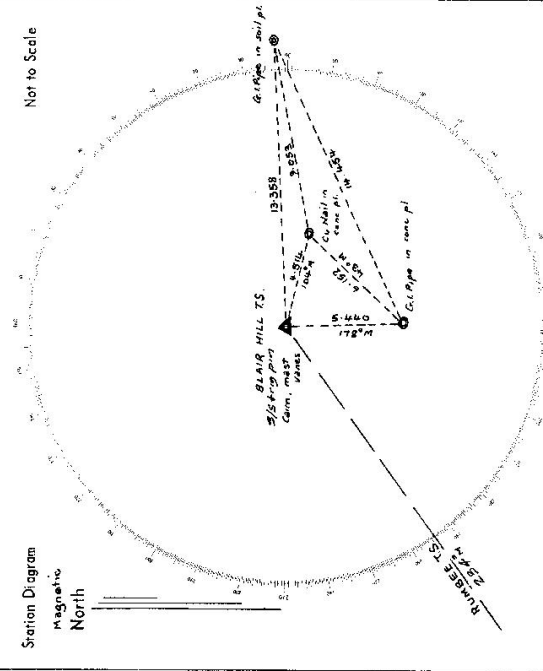

List of Observed Directions:-

Standpoint: s/s trig pin		Standpoint: Copper Nail in conc. pl.	
Station	Direction	Station	Direction
RUMBEE TS.	359° 59' 60"	RUMBEE TS.	359° 59' 60"
Cu Nail in conc pl.	225 39	s/s trig pin in conc. fd.	145 23
G.I. Pipe in conc. pl.	301 14 00	G.I. Pipe in conc. fd.	346 32 30

Standpoint: G.I. Pipe in conc. pl.		Standpoint: G.I. Pipe in soil placed	
Station	Direction	Station	Direction
RUMBEE TS.	359° 59' 60"	GLEN LEIGH TS	359° 59' 60"
s/s trig pin in conc	121 09 00	G.I. Pipe in conc. fd.	338 14 20
Cu Nail in conc pl.	166 32 00	Cu Nail in conc. fd.	359 32 00
		Centre of mast	0 54 00

Access 20-11-75

Km

Feature

- 0-0 Travelling south along "CHURCH ST." TOWARDS "RED RANGE"
- 7-2 Turn left along OLIVER ST. TOWARDS "PINKETT"
- 16-6 End of bitumen
- 17-3 Turn right towards "square Range"
- 23-6 Turn right towards "YARRONLEE"
- 24-6 Turn right off road through iron gate

opposite tin hay shed

26-0 Iron gate

25-7 Iron gate

25-8 Trig on R.H.S of track

Standpoint: G.I. Pipe in conc. pl.

Station	Direction
GLEN LEIGH TS.	359° 59' 60"
Blair Hill TS. Centre of Mast	91° 16'
G.I. Pipe in conc. fd.	121-09-00
G.I. Pipe in soil placed	166-32-00


7-2-21

CENTRAL MAPPING AUTHORITY
 Department of Lands
 Trigonometrical Survey of N.S.W. *3-2-21*
 RECONNAISSANCE and MAINTENANCE REPORT

STATION BLAIR HILL T S 6515

Co: Gough Ph: Blair Hill No: 9238
 Map Sheet: GLEN INNES - S
 Inspected by: *D. Finning* Date: *20-4-75*
 Authority: C.M.A. 28146 2/76 Field Book: *450-478*

Beacon Diagram Not to Scale

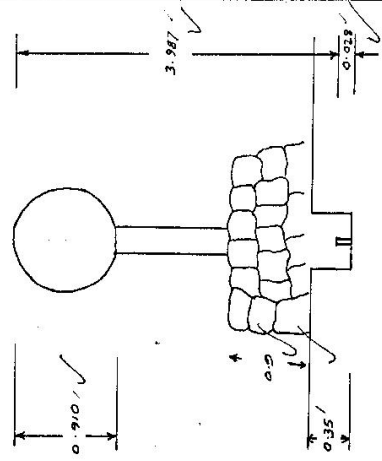

Note: Cross out word or words which do not apply

- This Trig. Station has been:-
1. Completely cleared to permit 360° vision to surrounding Trigs.
 2. Cleared by lanes bearing..... from Trig. Mast
 3. Trig. Mast & Vanes have been painted white & black respectively.
 4. The Trig. was unpiled/not unpiled, dimensions now being:
 - Description of mark..... should be explicit, e.g. Steel plug, Brass plug, Bolt, G.I. Pipe
 - Height of mark..... m ^{above} rock/concrete m ^{below} G.L.
 - Height of Top Vanes to Top Mark..... m. Diameter of Vanes (vertical)..... m.
 - Height of Cairn..... m. Diameter of Cairn..... m.
 - Length of Mast..... m. (approximate if not unpiled)
 5. A..... set in conc/rock has been placed..... m. bearing..... °M from Trig. Mast
 6. A..... set in conc/soil has been placed..... m. bearing..... °M from Trig. Mast
 7. A..... set in conc/soil has been placed..... m. bearing..... °M from Trig. Mast
 8. A..... set in conc/rock has been placed..... m. bearing..... °M from Trig. Mast
 Action required: *conc. pillar*
 9. Connection..... to..... m. bearing..... °M
 10. Connection..... to..... m. bearing..... °M
 11. Connection..... to..... m. bearing..... °M
 12. Connection..... to..... m. bearing..... °M
 13. Diff. Ht. is..... m. ^{above} _{below}
 14. Diff. Ht. is..... m. ^{above} _{below}
 15. Diff. Ht. is..... m. ^{above} _{below}
 16. Diff. Ht. is..... m. ^{above} _{below}

Date	Record of Station
20-4-75	<i>C. Nail & G.I. Pipe placed in conc. and connected by D. Finning</i>
4-3-76	<i>G.I. Pipe placed in soil & connected by D. Finning</i>
28-6-77	<i>Reconnaissance No change</i>

Prepared by: *K. R. ...* Checked: *W. ...* 7/1/78 Noted on U.T.M. Card


Checked

STATION BLAIR HILL TS. 6515

Owners Name:
 Current Occupant:
 Address:
 Address:

Access 28-6-78
 Km Feature
 0.0 Travelling south along "CHURCH ST." GLENINNES.
 7.2 Turn left along OLIVER ST, towards "RED RANGE"
 16.6 Turn right towards "PINKETT"
 17.3 End of bitumen
 23.6 Turn right towards "square range"
 24.6 Turn RIGHT towards "YARROWLEE"
 opposite tin hay shed
 28.0 Iron gate
 25.7 Iron gate
 25.8 Trg on R.H.S of track
 to change

Station Diagram
 Magnetic North

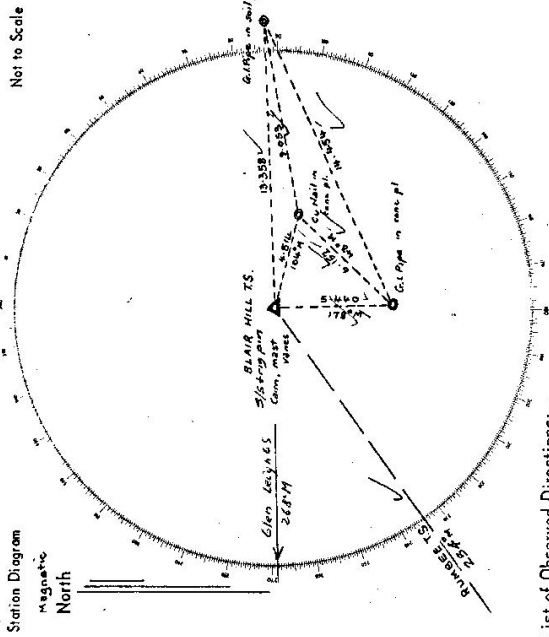

List of Observed Directions:-

Station	Direction	Station	Direction
RUMBEE TS	359° 59' 40"	RUMBEE TS	359° 59' 40"
Sw Nail in conc. pl.	225 39'	s/s trg pin in conc. fd.	45 25'
G.I. Pipe in conc. pl.	301 16 00'	G.I. Pipe in conc. fd.	346 32 30'
Standpoint: G.I. Pipe in conc. pl.		Standpoint: G.I. Pipe in soil placed	
RUMBEE TS	359° 59' 40"	GLEN LEIGH TS	359° 59' 40"
s/s trg pin in conc. pl.	121 09 00'	G.I. Pipe in conc. fd.	338 14 20'
Sw Nail in conc. pl.	166 32 00'	Sw Nail in conc. fd.	359 32 05'
		Centre of mark	0 56 00'

Standpoint G.I.P in conc. placed

Station	Direction
GLEN LEIGH TS.	359° 59' 40"
Blair Hill TS. Centre of Mark	0° 1' 10"
G.I. Pipe in conc. fd.	359 32 05'
G.I.P. in soil placed	158° 44'

Sic

Lis

GEODETTIC SURVEY OF N.S.W.

CENTRAL MAPPING AUTHORITY

GEODETTIC STATION RECONNAISSANCE and MAINTENANCE REPORT

Description: *Note: Cross out word or words which do not apply*

- Cleared by lances bearing..... from Trig, Mast
- Mast & Vanes have been painted white & black respectively.
- The station/~~pillar~~ ~~was~~ ~~not~~ ~~unplied~~ ~~constructed~~ on *8th May 1979*, dimensions now being: Description of mark..... should be explicit, e.g., S/Steel Pillar Plate, Steel plug, Brass plug, Bolt, G.I. Pipe
Height of mark.....m. above below rock/concrete; Mark is.....m. above below G.L.
Height of Top Vanes to Top Mark/Pillar platem. Diameter of Vanes (vertical).....m.
Height of Cairn.....m. Diameter of Cairn.....m. Name Plate found ~~not found~~ ~~placed~~.
Length of Mast.....m. (approximate if not unplied)
- A..... *Nail*..... set in conc ~~not been placed~~ found, bearing *164*° M from Mast/~~Plug/Pillar~~ *all set*
- A..... *Pipe*..... set in conc ~~not been placed~~ found, bearing *178*° M from Mast/~~Plug/Pillar~~ *stable*
- A..... *Pipe*..... set in conc ~~not been placed~~ found, bearing *89*° M from Mast/~~Plug/Pillar~~
- A..... set in conc/rock has been placed found, bearing.....° M from Mast/~~Plug/Pillar~~
- Action required: *Fast cone Pillar clear black berries from Cairn Mast & Vanes need paint*

Trips Sighted

Trips Sighted	end of Mark	Direction	Horiz. Distance km	Height Difference	Mark	Direction	Horiz. Distance	Height Difference
Skeleton	12	22	22	above standpt.	Fernobk	38	19	above standpt.
Dud Nob	30	23	23	above standpt.	Kingsgate	74	22	above standpt.
Wolkeop	149	15	15	above standpt.	Pretty Volky	94	13	above standpt.
Mitchell	179	17	17	above standpt.	Wolch	117	19	above standpt.
Marawan	179	6	6	above standpt.	Massgito	145	11	above standpt.
Rumbere	234	6	6	above standpt.	Narrow	121	14	above standpt.
Gaten Leigh	290	13	13	above standpt.				below
Boyd	352	13	13	above standpt.				below

Prepared by: *J. FARWING* Checked: *W. J. Farwing 10/9/79* Noted on U.T.M. Card


ST 2733-1

STATION: *BLAIR HILL G.S.* No.: *6515*
 MAP SHEET SCALE 1:250 000
 INSPECTED BY: *J. FARWING* DATE: *28 May 79*
 AUTHORITY: *C.M.A.* FIELD BOOK: *1753*

Station Diagram
 North
 Net to Scale

Checked

St 2735-2 D. West, Government Printer

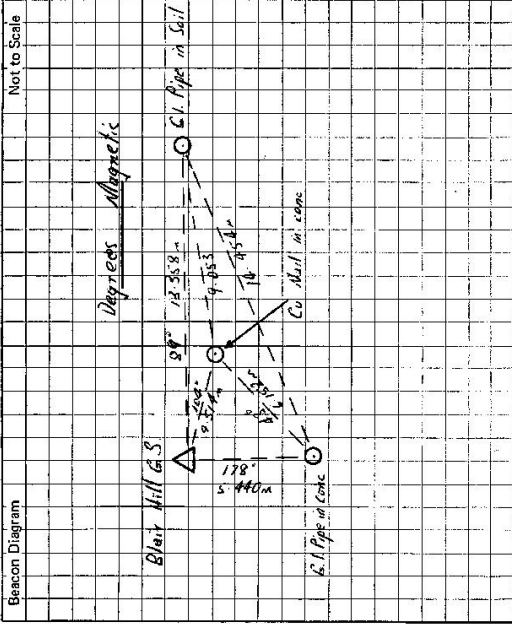

STATION	BLAIR HILL	G.S.	6515
Owner's Name: Lance Newberry	Current Occupant: Owns concrete to		
Address: Square Range (for access)	Address: any clearing and setting pillar		
Phone: 334853	Phone:		
ACCESS			
Access Report of 20/11/1925 was found suitable for use <u>2 wheel drive</u>			
0.00	Corner Oliver St + New England Hwy towards Red Range		
7.0	Turn right to Pinkett		
20.8	Turn right towards "Square Range"		
22.1	Turn left towards "Yarrowlee"		
23.08	Turn right off dirt road through iron gate opposite Tin hay shed		
23.52	Iron Gate		
24.07	Iron gate		
24.27	Blair Hill G.S.		

This section to be completed by officer constructing pillar.

Original station mark found/not found.

Description of mark:

Original beacon found/not found.

Description of beacon:

Height Top of Vanes to Top Mark:m.

Height of mark:m. above G.L.
below rock/conc.


Diameter of Vanes:m. Height of Cairn:m.

Original Beacon has/has not been destroyed by me.

Date	Record of Station

CENTRAL MAPPING AUTHORITY
 GEODETIC SURVEY OF N.S.W.
 GEODETIC STATION RECONNAISSANCE and MAINTENANCE REPORT 1570
 Batch

STATION: **BLAIR HILL (P)** No.: **6515**
 MAP SHEET SCALE 1:250 000
 INSPECTED BY: **H.C. BORDER** DATE: **3-3-80**
 AUTHORITY: **C.M.A** FIELD BOOK: **1678**

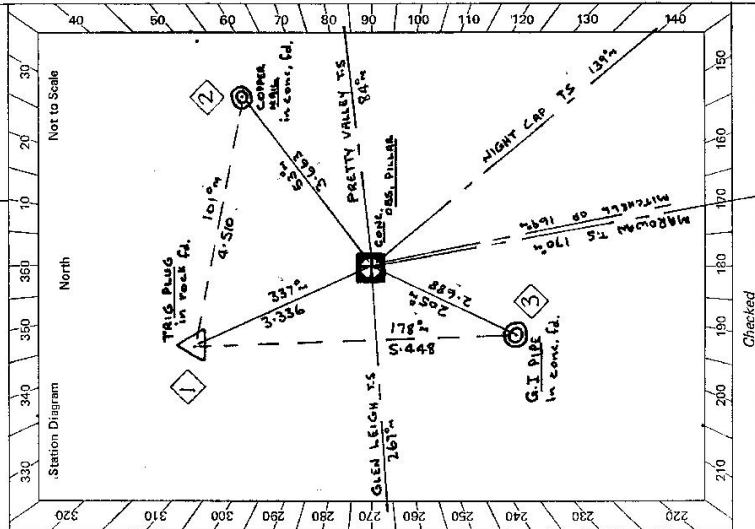

- Description: *(None)*
 Note: Cross out word or words which do not apply
- Cleared by James bearing 235-226, 233-317, 348-347, 354-56, 45-67, 75-85, 98-102, 111-112, from Trig. ~~Mark~~ Pillar 108-109, 135-137, 139-140, 142-144, 155-161, 163-178, 203-209, 210-219.
 - Mast & Vanes have been painted white & black respectively. ✓
 - The ~~steel~~/pillar ~~was supplied/not supplied~~/constructed on 1-3-1980, dimensions now being: Description of marks ~~S~~ Pillar Plate should be explicit, e.g., S/Steel Pillar Plate, Steel plug, Brass plug, Bolt, G.I. Pipe
 Height of mark 1.380 m above rock/concrete; Mark is 1.480 m above G.L.
 Height of Top Vanes to Top Mast/Pillar plate 1.440 m. Diameter of Vanes (vertical) 0.755 m.
 Height of ~~Gamm~~ m. Diameter of ~~Gamm~~ m. Name Plate found/not found/placed.
 Length of Mast 1.520 m. (approximate if not supplied)
 - A Trig. ~~PLUG~~ set in ~~conc~~/rock has been placed/found, bearing 337.0° M from Mast/Plug/Pillar
 - A COPPER NAIL set in ~~conc~~/rock has been placed/found, bearing 53.0° M from Mast/Plug/Pillar
 - A G.I. PIPE set in ~~conc~~/rock has been placed/found, bearing 205.0° M from Mast/Plug/Pillar
 - A set in ~~conc~~/rock has been placed/found, bearing° M from Mast/Plug/Pillar
 - Action required:


STANDPOINT: CONC. PILLAR				STANDPOINT: TRIG PLUG			
Mark	Direction	Horiz. Distance	Height Difference	Mark	Direction	Horiz. Distance	Height Difference
MAROUAN TS	0 00 00		above standpt.	MAROUAN TS	0 00 00		above standpt.
G.I. PIPE	36 10 40	2.688	above standpt.	G.I. PIPE	07 51 40	5.448	above standpt.
GLEN LEIGH TS	96 20 20		below	GLEN LEIGH TS	96 19 20		below standpt.
TRIG PLUG	165 21 50	3.334	above standpt.	PRETTY VALLEY TS	274 58 50		above standpt.
COPPER NAIL	245 27 50	3.663	below	COPPER NAIL	292 12 50	4.510	above standpt.
PRETTY VALLEY TS	274 57 20		below	NIGHT CAP TS	330 11 20		below
NIGHT CAP TS	330 10 20		above standpt.	CONC. WILKINSON	345 22 10	3.239	above standpt.
MITCHELL OP	359 38 20		below	MITCHELL OP	359 38 40		above standpt.

Prepared by: **H.C. BORDER**
 Checked: **H.C. BORDER**
 Noted on U.T.M. Card

Sr 2733 - 2 D. West, Government Printer

STATION **BLAIR HILL (P)** **6515**

Owner's Name: **LANCE NEWBERRY**
 Address: **SQUARE RANGE**
 Phone: **081 334 653**
 Current Occupant:
 Address:
 Phone:
 ACCESS
 Access Report of: **8/5/19** was found suitable/unsuitable.

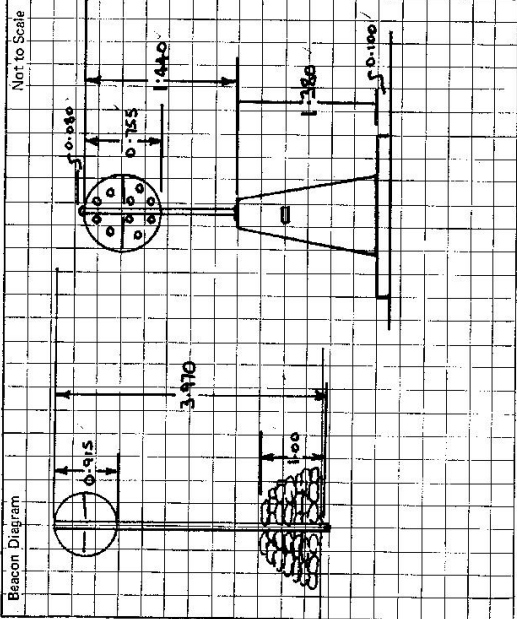

This section to be completed by officer constructing pillar.

Original station mark found/~~recovered~~.
 Description of mark: **Base, The Dug, in rock**
 Original beacon found/~~recovered~~.
 Description of beacon: **Cairn, Mast & Vanes**
 Height Top of Vanes to Top Mark: **3.970** m.
 Height of mark: **0.915** m. above rock/~~was 0.300~~ m. above G.L. / below
 Diameter of Vanes: **0.915** m. Height of Cairn: **1.00** m.
 Original Beacon has/~~has not~~ been destroyed by me.

Date	Record of Station