


TS 6551
No: 2885

STATION: LONG MILE
MAP SHEET SCALE 1:250 000
INSPECTED BY: M.L. Morrison
DATE: 10/10/79
AUTHORITY: C.M.A.
FIELD BOOK: 1798

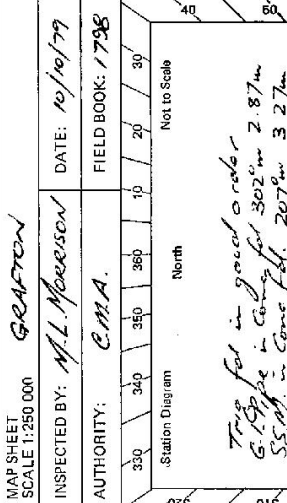

Not to Scale
+
Permission to clear and Pillar given by manager

CENTRAL MAPPING AUTHORITY
GEODETTIC SURVEY OF N.S.W.
GEODETTIC STATION RECONNAISSANCE and MAINTENANCE REPORT

Description:
Note: Cross out word or words which do not apply
1. Cleared by lanes bearing..... from Trig, Mast
2. Mast & Vanes have been painted white & black respectively.
3. The station/~~pillar~~ was ~~used~~/not unpiled/~~used~~ on 10/10/79 19.79m, dimensions now being:
Description of mark..... should be explicit, e.g., S/Steel Pillar Plate, Steel plug, Brass plug, Bolt, G.I. Pipe
Height of mark.....m. above below rock/concrete; Mark is.....m. above below G.L.
Height of Top Vanes to Top Mark/Pillar platem. Diameter of Vanes (vertical) 0.91 m.
Height of Cairn.....m. Diameter of Cairn 2.60 m. Name Plate ~~found~~/not found/~~placed~~:
Length of Mast 3.17 m. (approximate if not unpiled)
4. A..... set in conc/rock has been placed/found, bearing.....° M from Mast/Plug/Pillar
5. A..... set in conc/rock has been placed/found, bearing.....° M from Mast/Plug/Pillar
6. A..... set in conc/rock has been placed/found, bearing.....° M from Mast/Plug/Pillar
7. A..... set in conc/rock has been placed/found, bearing.....° M from Mast/Plug/Pillar
8. Action required.....

STANDPOINT:			
Mark	Direction	Horiz. Distance	Height Difference
			above standpt.
			below standpt.
			above standpt.
			below standpt.

Prepared by: [Signature] 31/10/79
Checked: [Signature]
Noted on U.T.M. Card

STATION **LONG MILE. TS 6551**

Owner's Name: **PAUL G. GOSBY**
 Address: **PO BOX 19 CAMBERWELL VIC**
 Phone:

Current Occupant: **DAVE WOOD (MANAGER)**
 Address: **HANBURG STUD**
 Phone: **663518**

ACCESS
 Access Report of 10/10/19 was found suitable/unsuitable.
 Km Direction
 0.00 BARYULGI RD. HEAD TOWARDS TABULAM
 0.27 TURN RIGHT SIGN "TABULAM SS km"
 16.22 HANBURG STUD ON RIGHT (MANAGER)
 17.36 PASS OVER WOODEN BRIDGE "LONG MILE RANGE CREEK"
 17.86 TURN RIGHT THROUGH DOUBLE ARCH GATE. FOLLOW TRACK.
 19.03 PASS HOUSE ON RIGHT.
 19.10 THROUGH YARDS FOLLOW TRACK DOWN TO AND OVER CREEK.
 19.22 CROSS CREEK AND FOLLOW AROUND TO LEFT AND UP RIDGE.
 19.89 FOLLOW FENCE LINE KEEPING IT ON YOUR RIGHT (DO NOT GO THROUGH GATE)
 20.58 TRAIL

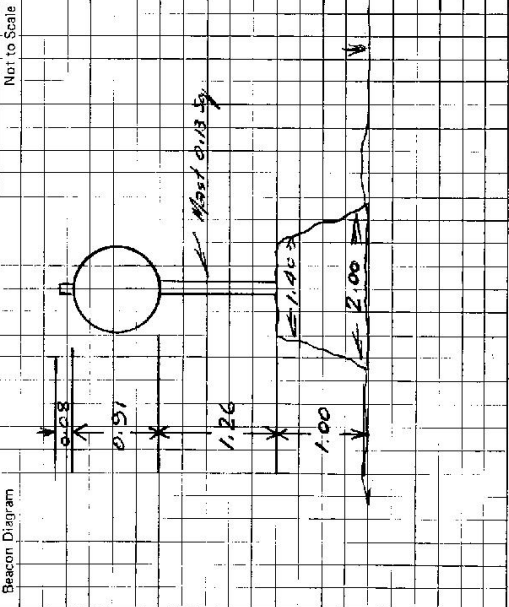

This section to be completed by officer constructing pillar.
 Original station mark found/not found.
 Description of mark:
 Original beacon found/not found.
 Description of beacon:
 Height Top of Vanes to Top Mark:m.
 Height of mark:m, above G.L. below
 Diameter of Vanesm, Height of Cairnm.
 Original Beacon has/has not been destroyed by me.

Date	Record of Station

GEODETIC SURVEY OF N.S.W.

CENTRAL MAPPING AUTHORITY

GEODETIC STATION RECONNAISSANCE and MAINTENANCE REPORT

STATION: *LONG MILE GS (P)* / No.: *6551*
 MAP SHEET: *GRAFTON*
 SCALE: 1:250 000
 INSPECTED BY: *D. SHARROTT* / DATE: *19/6/80*
 AUTHORITY: *C.M.A.* / FIELD BOOK: *1685*

Station Diagram
 Not to Scale

- Description:
- Cleaned by lanes bearing *34°M*. Note: Cross out word or words which do not apply from Trig, Mast
 - Mast & Vanes have been painted white & black respectively. ✓
 - The station/pillar was ~~unplaced~~ constructed on *22.20.19 AD*; dimensions now being: Description of marks *STEEL PILLAR* should be explicit, e.g., S/Steel Pillar Plate, Steel plug, Brass plug, Bolt, G.I. Pipe
 Height of mark *3.60* m. above rock/concrete; Mark is *5.10* m. above below G.L.
 Height of Top Vanes to Top Mark/Pillar plate *3.50* m. Diameter of Vanes (vertical) *0.255* in.
 Height of Cairn *0* m. Diameter of Cairn *0* m. Name Plate found/not found/placed.
 Length of Mast *0* m. (approximate if not supplied)
 - BRASS PLUG* set in conc/feek has been placed/found, bearing *212.10* M from Mast/Plug/Pillar
 - SSM* set in conc/feek has been placed/found, bearing *174* M from Mast/Plug/Pillar
 - G.I. PIPE* set in conc/feek has been placed/found, bearing *10* M from Mast/Plug/Pillar
 - A* set in conc/rock has been placed/found, bearing *0* M from Mast/Plug/Pillar
 - Action required *None*

STANDPOINT: PILLAR PLATE			STANDPOINT: BRASS PLUG				
Mark	Direction	Horiz. Distance	Height Difference	Mark	Direction	Horiz. Distance	Height Difference
<i>ALICE GS (P)</i>	<i>0° 00' 00"</i>	<i>0</i>	above standpt.	<i>ALICE GS (P)</i>	<i>0° 00' 00"</i>	<i>0</i>	above standpt.
<i>G.I. PIPE</i>	<i>60 14 25</i>	<i>2.77</i>	below standpt.	<i>KUNGABARIN GS (P)</i>	<i>222 17 15</i>	<i>0</i>	below standpt.
<i>BRASS PLUG</i>	<i>122 00 20</i>	<i>3.137</i>	above standpt.	<i>SSM</i>	<i>252 31 50</i>	<i>3.269</i>	above standpt.
<i>SSM</i>	<i>189 49 05</i>	<i>2.684</i>	above standpt.	<i>PILLAR PLATE</i>	<i>302 02 35</i>	<i>3.139</i>	above standpt.
<i>KUNGABARIN GS (P)</i>	<i>222 14 40</i>	<i>0</i>	below standpt.	<i>G.I. PIPE</i>	<i>346 18 10</i>	<i>2.875</i>	below standpt.

Prepared by: *D. SHARROTT* / Checked: *D. SHARROTT* / Noted on U.T.M. Card


STATION LONG MILE GS (P) IS 6551

Owner's Name: RALPH CROSBY
 Address: RD Box 119
CAMBERWELL VIC
 Phone:

Current Occupant: DAVE WOOD (MANAGER)
 Address: HARBURG ST RD
BARVULLIL
 Phone: 06 6 35 18

ACCESS
 Access Report of 14/10/1979 was found suitable for construction.

Km.
 / 0.00 BARVULLIL RD HEAD TOWARDS TABULAM
 / 0.27 TURN RIGHT SIGN "TABULAM 55km"
 / 14.22 HARBURG ST RD ON RIGHT (MANAGER)
 / 17.36 PASS OVER WOODEN BRIDGE "LONG MILE RANGE CREEK"
 / 17.86 TURN RIGHT OVER BRIDGE FOLLOW TRACK
 / 19.03 PASS HOUSE ON RIGHT
 / 19.10 THROUGH YARDS. FOLLOW TRACK DOWN TO AND OVER CREEK
 / 19.22 CROSS CREEK AND FOLLOW AROUND TO LEFT AND UP RIDGE
 / 19.80 FOLLOW FENCELINE KEEPING IT ON YOUR RHS. (DO NOT GO THROUGH)
 / 20.58 LONG MILE GS (P)

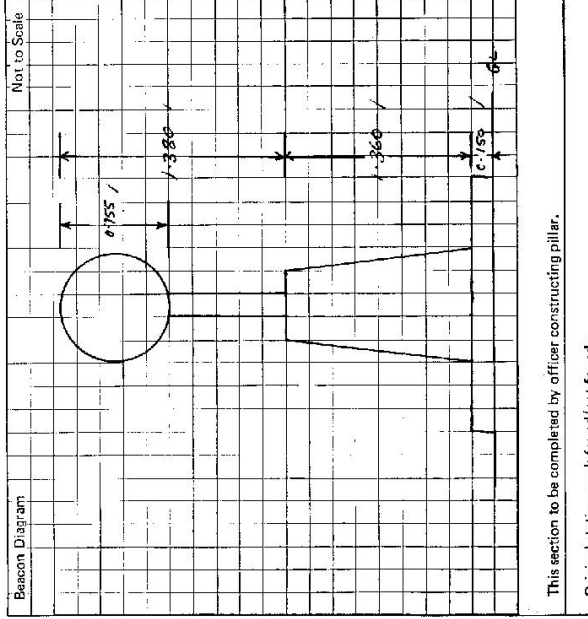

This section to be completed by officer constructing pillar.

Original station mark found/~~not found~~

Description of mark: Australian Survey Corps Brass Pegs

Original beacon found/~~not found~~

Description of beacon: Cross Ply Disc

Height Top of Vanes to Top Mark: 3.350 m.

Height of mark: Level with above m. 0.210 m. above G.L. below G.L.

Diameter of Vanes: 0.910 m. Height of Calm: 1.660 m.

Original Beacon has/~~has not~~ been destroyed by me.

Date	Record of Station