

CENTRAL MAPPING AUTHORITY

GEODETIC SURVEY OF N.S.W.

TS-6554

GEODETIC STATION RECONNAISSANCE and MAINTENANCE REPORT

Description:
 1. Cleared by lanes bearing.....
 Note: Cross out word or words which do not apply
 from Trig. Mast

2. Mast & Vanes have been painted white & black respectively.

3. The station/pillar was unpiled/not unpiled/constructed on.....
 Description of mark..... should be explicit, e.g. S/Steel Pillar Plate, Steel plug, Brass plug, Bolt, G.I. Pipe
 Height of mark.....^{above} rock/concrete/.....^{below} G.L.
 Mark is.....m. Diameter of Vanes (vertical).....m.

Height of Top Vanes to Top Mark/Pillar plate.....m. Diameter of Vanes (vertical).....m.

Height of Cairn.....m. Diameter of Cairn.....m. Name Plate found/not found/placed.
 Length of Mast.....m. (approximate if not unpiled)

4. A.....set in conc/rock has been placed/found, bearing.....°M from Mast/Plug/Pillar

5. A.....set in conc/rock has been placed/found, bearing.....°M from Mast/Plug/Pillar

6. A.....set in conc/rock has been placed/found, bearing.....°M from Mast/Plug/Pillar


7. A.....set in conc/rock has been placed/found, bearing.....°M from Mast/Plug/Pillar

8. Action required:.....

STANDPOINT:

Mark	Direction	Horiz. Distance	Height Difference	Mark	Direction	Horiz. Distance	Height Difference
			above standpt.				above standpt.
			below				below
			above standpt.				above standpt.
			below				below
Prepared by:  17/80 -

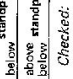Checked: 

Noted on U.T.M. Card

Checked

STATION: HAYDEN No.: 2450
 MAP SHEET SCALE 1:250 000 GRAFTON
 INSPECTED BY: M.L. Morrison DATE: 22/1/80
 AUTHORITY: CMAA FIELD BOOK: 1799

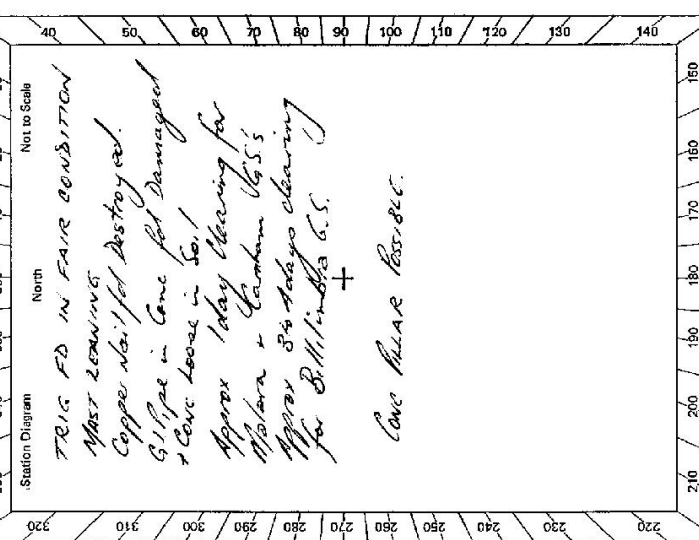

GEODETIC SURVEY OF NSJK

CENTRAL MAPPING AUTHORITY

GEODETIC STATION RECONNAISSANCE and MAINTENANCE REPORT

Description:

- Cleared by lanes bearing $135.5 \pm 1.0^\circ$ from Trig. Mast.
 Note: Cross out word or words which do not apply
- Mast & Vanes have been painted white & black respectively. ✓
- The station/pillar was ~~replaced~~ constructed on 19.8 ± 0.1 m. dimensions now being:
 Description of mark $1.4 \times 1.4 \times 1.4$ m. should be explicit, e.g., S/Steel Pillar Plate, Steel plug, Brass plug, Bolt, G.I. Pipe
 Height of mark 1.4 ± 0.1 m. above ~~mark~~ ^{above} ~~mark~~ ^{above} G.L.
 Height of Top Vanes to Top ~~mark~~ ^{above} ~~mark~~ ^{above} Pillar plate 1.4 ± 0.1 m. Diameter of Vanes (vertical) 75 ± 0.5 mm.
 Height of Cairn 1.4 ± 0.1 m. Diameter of Cairn m. Name Plate ~~found~~ ^{found} / ~~not found~~ / placed.
 Length of Mast m. (approximate if not unplied)
- A ~~steel~~ ^{steel} ~~pillar~~ ^{pillar} set in conc/rock has been ~~placed~~ ^{found} / found, bearing $58 \pm 0.5^\circ$ M from ~~Mast/Bolt~~ ^{Mast/Bolt} / Pillar
- A ~~concrete~~ ^{concrete} ~~mark~~ ^{mark} set in conc/rock has been placed ~~found~~ ^{found} / ~~not found~~ / placed, bearing $14 \pm 0.5^\circ$ M from ~~Mast/Bolt~~ ^{Mast/Bolt} / Pillar
- A set in conc/rock has been placed ~~found~~ ^{found} / ~~not found~~ / placed, bearing $0 \pm 0.5^\circ$ M from Mast/Plug/Pillar
- A set in conc/rock has been placed ~~found~~ ^{found} / ~~not found~~ / placed, bearing $0 \pm 0.5^\circ$ M from Mast/Plug/Pillar

Action required:

STANDPOINT: ~~Pillar~~ ^{Pillar} ~~Plate~~ ^{Plate} ~~Steel~~ ^{Steel} ~~Teleg~~ ^{Teleg} ~~Post~~ ^{Post} ✓


Mark	Direction	Horiz. Distance	Height Difference	Mark	Direction	Horiz. Distance	Height Difference
MALARA GS	0 00 00		above standpt. / below standpt.	MALARA	0 00 00		above standpt. / below standpt.
COOPER NAIL	85 56 10	3.454	above standpt. / below standpt.	COOPER NAIL	25 47 20	2.431	above standpt. / below standpt.
S.S. TRIG PILL	124 06 50	3.085	above standpt. / below standpt.	CARRIHAM NAIL P	164 15 30		above standpt. / below standpt.
CARRIHAM NAIL P	164 15 30		above standpt. / below standpt.	MIRASTAH P	239 45 10		above standpt. / below standpt.
MIRASTAH P	239 45 10		above standpt. / below standpt.	PLATE PLATE	302 08 10	3.085	above standpt. / below standpt.

Prepared by: *[Signature]*

Checked: *[Signature]*

Noted on U.T.M. Card

SI 2708-1

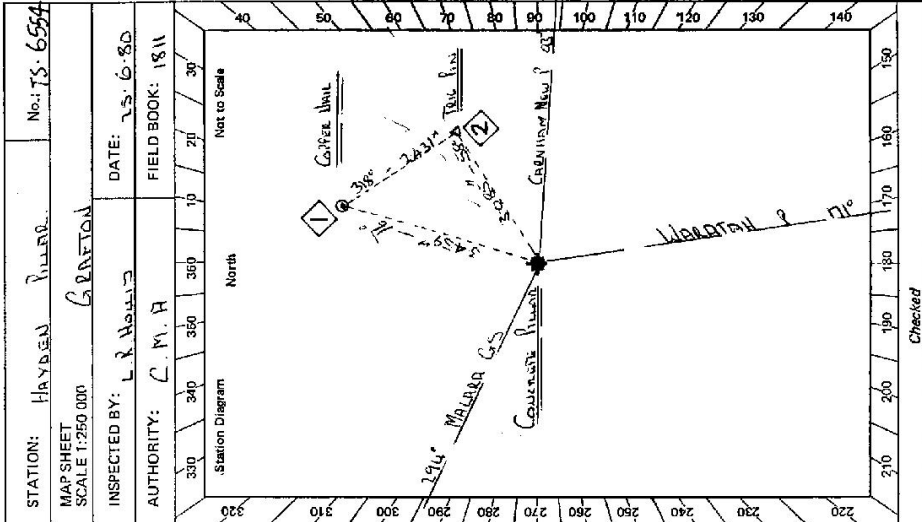

Checked

STATION **HYDEA PILLAR JS 6554**


Owner's Name: **FORNSIA COMMERCIAL**
 Address:
 Phone:
 Current Occupant:
 Address:
 Phone:

ACCESS

Access Report of **25.6.1988** was found suitable/unsuitable.

Feature
 000 BATHUGAL PO NEAR TOWNERS TRADING /
 025 TURN LEFT SIM "LIONSVILLE IA" /
 1100 FOLLOW ROAD ROUNDO TO LEFT SIM "COLLUM COLLEGE" /
 1545 TILL GATE (MOUNTED) SIM "COLLUM COLLEGE" FOLLOW TO STRAIGHT AHEAD
 1715 TRAIL RIGHT FORK /
 1855 PANE LEFT FORK /
 2475 " " /
 2515 TRAIL RIGHT FORK /
 2700 JUST AFTER CONCRETE BRIDGE → BEFORE CUTTING TURN SHARP RIGHT
 OFF ROAD AND FOLLOW TONGUE OF STEEP SLOPE ON YOUR LEFT /
 2910 " " LEFT /
 3040 TILL GATE (NOT LOCKED) /
 3630 FOLLOW TRACK ROUNDO TO RIGHT
 3790 TURN LEFT OFF TRACK AT CLEARING /
 4125 GRADIENT SPATIOL /
 4130

REVERSE NOTE - 29.10.19 to 31.10.19 THE TOWER IN VLOT WILSON IN VLOT
 DESTROYED BY A LIGHT BOMB, WHICH IS TO BE REBUILT

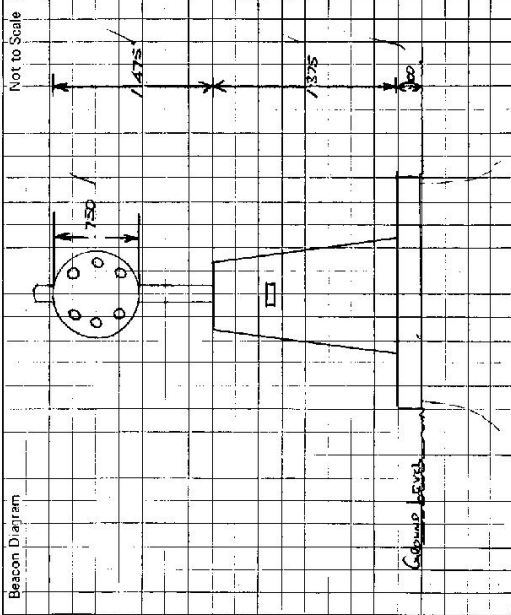

This section to be completed by officer constructing pillar.

Original station mark found/~~not found~~.

Description of mark: **CONCRETE PILLAR WITH 6 VANS** **1475** **300**

Original beacon found/~~not found~~.

Description of beacon: **CONCRETE PILLAR WITH 6 VANS**

Height Top of Vanes to Top Mark: **300** m.

Height of mark: **300** m. **above** **mark/conc** **below** **G.L.**

Diameter of Vanes: **1475** m. Height of Cairn: **100** m.

Original Beacon has/~~been~~ been destroyed by me.

Date	Record of Station