

TS 6558  
No: 4162

STATION: WILKIE  
MAP SHEET  
SCALE 1:250 000  
INSPECTED BY: A. Paterson  
AUTHORITY: C.M.A.

COOTAMUNDRA  
DATE: 13-9-79  
FIELD BOOK: AB 1783

GEODETIC STATION RECONNAISSANCE and MAINTENANCE REPORT

Description: Note: Cross out word or words which do not apply

1. Cleared by lanes bearing..... 360° ..... from Trig. Mast

2. Mast & Vanes have been painted white & black respectively. No base on

3. The station/pillar was unpiled/~~not unpiled~~/~~constructed on~~..... 19..... dimensions now being:

Description of mark: ~~Steel Pillar~~..... should be explicit, e.g., S/Steel Pillar Plate, Steel plug, Brass plug, Bolt, G.I. Pipe

Height of mark..... m. above rock/concrete; Mark is..... m. above G.L.

Height of Top Vanes to Top Mark/Pillar plate..... m. Diameter of Vanes (vertical)..... m.

Height of Cairn..... m. Diameter of Cairn..... m. Name Plate found/not found/placed.

Length of Mast..... m. (approximate if not unpiled)

4. A. S.S.M. 74.11..... set in conc./rock has been placed/found, bearing.....° M from Mast/Plug/Pillar

5. A..... set in conc./rock has been placed/found, bearing.....° M from Mast/Plug/Pillar

6. A..... set in conc./rock has been placed/found, bearing.....° M from Mast/Plug/Pillar


7. A..... set in conc./rock has been placed/found, bearing.....° M from Mast/Plug/Pillar

8. Action required:.....

STANDPOINT:

Mark	Direction	Horiz. Distance	Height Difference	Mark	Direction	Horiz. Distance	Height Difference
			above standpt. below				above standpt. below
			above standpt. below				above standpt. below
Prepared by: A. Paterson 27-9-79 Checked: Noted on U.T.M. Card

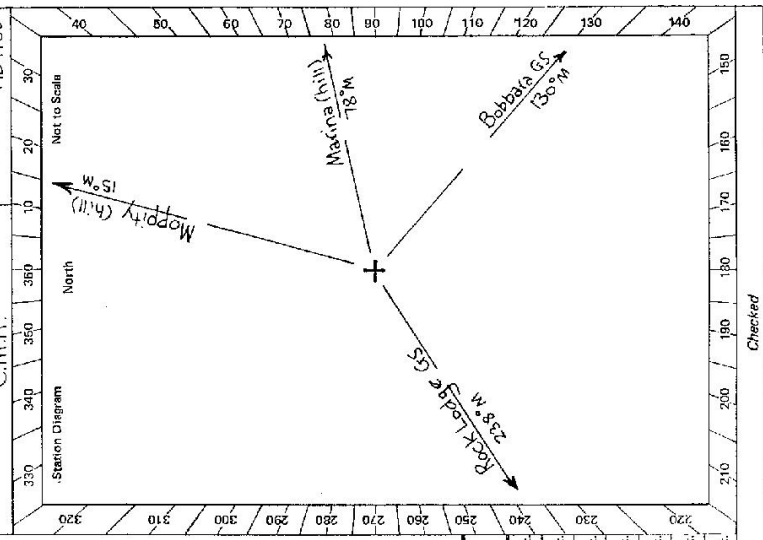

St 2733-2 D. West, Government Printer

STATION <b>WILKIE</b> <span style="float: right;"><b>TS 6558</b></span>	Owner's Name: <u>PH Hennock</u> Address: <u>"Pontania" (off Woodlands Rd) Kingsvale</u> Phone: <u>(065) 843239</u>	Current Occupant: ..... Address: ..... Phone: .....	<p style="text-align: center;"><u>ACCESS</u></p> <p>Access Report of <u>13/9/18</u> was found suitable/unsuitable.</p> <p><u>0.0</u> km From Young PO head south along Lynch St over bridge  <u>0.4</u> km Turn left towards Chinamans Dam  <u>1.6</u> km Turn left into Kingsvale Rd  <u>6.8</u> km Over railway bridge  <u>7.1</u> km At corner - station is on right just inside fence - in cover box surrounded by large rocks</p>		
Beacon Diagram <table border="1" style="width: 100%; height: 150px; border-collapse: collapse;"> <tr> <td style="width: 50%; text-align: center; vertical-align: middle;">NO BEACON</td> <td style="width: 50%; text-align: right; vertical-align: middle;">Not to Scale</td> </tr> </table>	NO BEACON	Not to Scale	This section to be completed by officer constructing pillar. Original station mark found/not found. Description of mark: ..... Original beacon found/not found. Description of beacon: ..... Height Top of Vanes to Top Mark ..... m. Height of mark ..... m. above G.L. below Diameter of Vanes ..... m. Height of Cairn ..... m. Original Beacon has/has not been destroyed by me.		
NO BEACON	Not to Scale				
	Date	Record of Station			
	13-9-19	I have spoken to Mr Hennock who has no objection to construction of pillar			



STATION <b>WILKIE GS (P) TS 6558</b>	<p>Owner's Name: <b>P. H. HENNOLDK</b>                  Address: <b>PANTANIA (off Woodlands Rd)</b>  <b>KINGSVALE</b>                  Phone: <b>(0263) 843239</b></p> <p>Current Occupant:                  Address:                  Phone:</p> <p>Access Report of <b>13/9/19</b> was found suitable/<del>unsuitable</del>. <b>ACCESS</b></p>
Beacon Diagram Not to Scale	
This section to be completed by officer constructing pillar.	
Original station mark found/ <del>not found</del> .	
Description of mark: <b>BRASS PUG IN COVER BOX</b>	
Original beacon found/ <del>not found</del> .	
Description of beacon:	
Height Top of Vanes to Top Mark: .....m.	
Height of mark: <b>0.32</b> above <del>neck/conc</del> <b>0.155</b> above <del>below</del> G.L.	
Diameter of Vanes: .....m.      Height of Calm .....m.	
Original Beacon <del>has</del> has not been destroyed by me.	
Date	Record of Station

CENTRAL MAPPING AUTHORITY

GEODETIC SURVEY OF N.S.W.

GEODETIC STATION RECONNAISSANCE and MAINTENANCE REPORT

STATION: **WILKIE (P)** No: **6558**

MAP SHEET SCALE 1:250 000  
INSPECTED BY: **A. SIVERTSEN** DATE: **15-1-90**

AUTHORITY: **CMA** FIELD BOOK: **C603**

Description: *Note: Cross out word or words which do not apply*

1. Cleared by lanes bearing.....
2. Mast & Vanes have been painted white & black respectively.
3. The station/pillar was unpiled/~~re-erected~~/~~constructed~~ on **15.3m** ~~19.3m~~, dimensions now being: **SS Steel Pillar Plate** should be explicit, e.g., S/Steel Pillar Plate, Steel plug, Brass plug, Bolt, G.I. Pipe  
 Height of mark.....m. <sup>above</sup> rock/~~concrete~~/~~stone~~ Mark is.....m. <sup>above</sup> G.L.  
 Height of Top Vanes to Top Mark/Pillar/Plate.....m. Diameter of Vanes (vertical).....m.  
 Height of Cairn.....m. Diameter of Cairn.....m. Name Plate found/not found/placed.  
 Length of Mast.....m. (approximate if not unpiled)
4. A **BRASS PLUG**.....set in conc/~~rock~~ has been ~~placed~~/found, bearing.....**93**° M from ~~Mast/Pillar~~/Pillar
5. A **G.I. PIPE**.....set in conc/~~rock~~ has been ~~placed~~/found, bearing.....**186**° M from ~~Mast/Pillar~~/Pillar
6. A **SSM 7411**.....set in conc/~~rock~~ has been ~~placed~~/found, bearing.....**120**° M from ~~Mast/Pillar~~/Pillar
7. A.....set in conc/~~rock~~ has been placed/found, bearing.....° M from Mast/Plug/Pillar
8. Action required:.....

STANDPOINT: **CONC. (P)** **TZ 2 area** STANDPOINT: **BRASS TONG PLUG**

Mark	Direction	Horiz. Distance	Height Difference	Mark	Direction	Horiz. Distance	Height Difference
MARINA (P)	0 00 00		above standpt.	MARINA (P)	0 00 00		above standpt.
BRASS PLUG	13 19 58	4.734	below standpt.	SSM 7411	60 17 44	6.561	below standpt.
SSM 7411	40 49 50	10.386	below standpt.	G.I. PIPE	153 50 12	6.600	below standpt.
G.I. PIPE	108 15 20	4.213	below standpt.	WILKIE (P)	193 20 14	4.733	below standpt.
MOPPIY (P)	299 44 22		below standpt.	MOPPIY (P)	299 41 16		below standpt.
			above standpt.				above standpt.
			below standpt.				below standpt.

Prepared by: **A. SIVERTSEN** Checked: **L. REA & DICK** Noted on U.T.M. Card



Station Diagram North Not to Scale

NEW CONNECTION ONLY

Checked

31 2733-1

