


STATION: CULLINGA
 MAP SHEET SCALE 1:250 000
 INSPECTED BY: A. Paterson
 AUTHORITY: C.M.A.
 FIELD BOOK: AB1784

TS 6559
 No: 1727
 DATE: 13-9-19

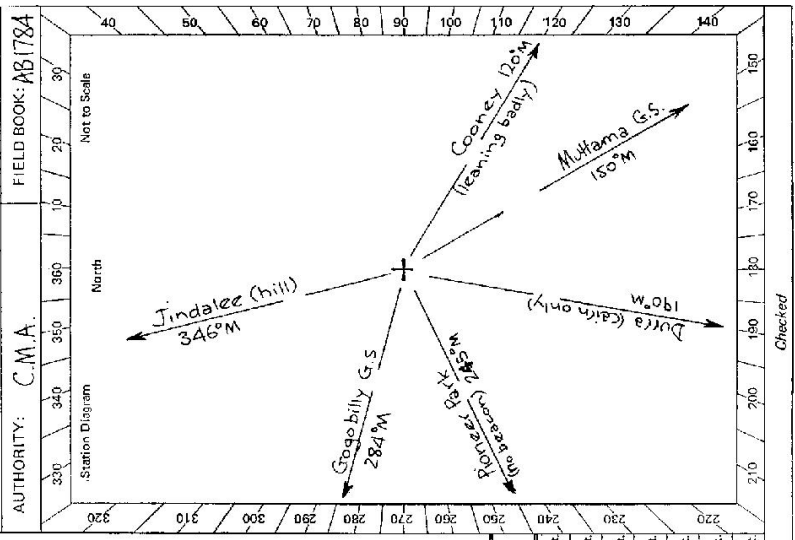

CENTRAL MAPPING AUTHORITY
 GEODETIC SURVEY OF N.S.W.
 GEODETIC STATION RECONNAISSANCE and MAINTENANCE REPORT

Description: 360°
 Note: Cross out word or words which do not apply
 1. Cleared by lanes bearing..... from Trig, Mast

2. Mast & Vanes have been painted white & black respectively.
 3. The station/pillar was ~~unpiled~~/constructed on..... 19....., dimensions now being:
 Description of mark.....should be explicit, e.g., S/Steel Pillar Plate, Steel plug, Brass plug, Bolt, G.I. Pipe

Height of mark.....m. ^{above} rock/concrete; Mark is.....m. ^{above} G.L.
 Height of Top Vanes to Top Mark/Pillar plate.....m. Diameter of Vanes (vertical).....m.

Height of Cairn.....m. Diameter of Cairn.....m. Name Plate found/not found/placed.
 Length of Mast.....m. (approximate if not unpiled)

4. A.....set in conc/rock has been placed/found, bearing.....°M from Mast/Plug/Pillar
5. A.....set in conc/rock has been placed/found, bearing.....°M from Mast/Plug/Pillar
6. A.....set in conc/rock has been placed/found, bearing.....°M from Mast/Plug/Pillar
7. A.....set in conc/rock has been placed/found, bearing.....°M from Mast/Plug/Pillar
8. Action required:.....

STANDPOINT:							
Mark	Direction	Horiz. Distance	Height Difference	Mark	Direction	Horiz. Distance	Height Difference
			above standpt.				above standpt.
			below standpt.				below standpt.
			above standpt.				above standpt.
			below standpt.				below standpt.
Prepared by: A. Paterson 27/9/19
 Checked: K. [Signature] 4/3/19
 Noted on U.T.M. Card
 Checked

STATION **CULLINGA** TS **6559**

Owner's Name: **K.J. Harris**
 Address: **"Shaftsbury"**
Shaftsbury Lane, Cootamundra
 Phone: **471341**

Current Occupant:
 Address:
 Phone:


ACCESS

Access Report of **13/9/1979** was found suitable/unsuitable.

Access km

- 0.0 Cootamundra PO - head west along Wallendean St.
- 0.1 Turn right into Parker St - take Olympic Way towards Young
- 2.6 Past Saleyards
- 3.55 Turn right into Shaftsbury Lane
- 4.4 Take right fork
- 4.8 Past house - follow track straight ahead past windmills & silos
- 5.8 Turn left at gate (don't go thru) and follow fence down hill
- 7.1 Turn right through gate & make way up hill
- 8.2 Station near lone tree

84-2739-2 D. West, Government Printer

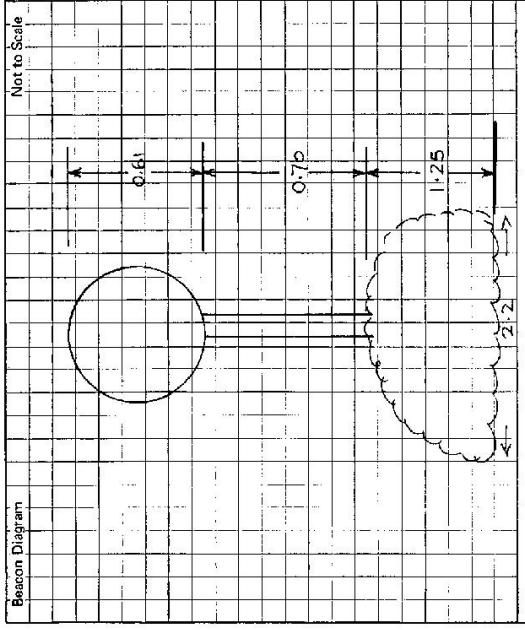

This section to be completed by officer constructing pillar.

Original station mark found/not found.

Description of mark:

Original beacon found/not found.

Description of beacon:

Height Top of Vanes to Top Mark:m.

Height of mark:m. above rock/concm. below G.L.

Diameter of Vanes:m. Height of Cairn:m.

Original Beacon has/has not been destroyed by me.

Date	Record of Station
13-9-79	I have spoken to Mr Harris who has no objections to erection of pillar

CENTRAL MAPPING AUTHORITY

GEODETTIC STATION RECONNAISSANCE and MAINTENANCE REPORT

STATION: DULLINGA GS (P) No.: TS 6559

MAP SHEET SCALE 1:250 000 COOTAMUNDRA

INSPECTED BY: L. HITCHINS DATE: 21/1/20

AUTHORITY: C.M.A. FIELD BOOK: D/505

Description:
 1. Cleared by lanes bearing 360° Note: Cross out word or words which do not apply
 2. Mast & Vanes have been painted white & black respectively.

3. The ~~station~~ pillar was ~~unpainted~~ constructed on 18.0m ~~19.0m~~ dimensions now being:
 Description of marks S/S PILLAR PLATE should be explicit, e.g., S/Steel Pillar Plate, Steel plug, Brass plug, Bolt, G.I. Pipe

Height of mark 3.80m above ~~below~~ rock/concrete Mark is 5.60m above ~~below~~ G.L.

Height of Top Vanes to Top Mark/Pillar plate 1.363m Diameter of Vanes (vertical) 0.752m.

Height of Cairnm Diameter of Cairnm Name Plate found/not found/placed.

Length of Mastm (approximate if not unpiled)

4. BRASS TRIG. PLUG set in conc/rock has been ~~placed~~ found, bearing 183° M from ~~Mast/Plug/Pillar~~

5. G.I. PIPE set in conc/rock has been ~~placed~~ found, bearing 223° M from ~~Mast/Plug/Pillar~~

6. A..... set in conc/rock has been placed/found, bearing° M from Mast/Plug/Pillar


7. A..... set in conc/rock has been placed/found, bearing° M from Mast/Plug/Pillar

8. Action required:

STANDPOINT: S/S PILLAR PLATE STANDPOINT: BRASS TRIG PLUG

Mark	Direction	Horiz. Distance	Height Difference	Mark	Direction	Horiz. Distance	Height Difference
JINDALEE GS (P)	0 00 00		above standpt	JINDALEE GS (P)	0 00 00		above standpt
BRASS TRIG. PLUG	200 53 45	4.576	above standpt	S/S PILLAR PLATE	10 53 20	4.573	above standpt
G.I. PIPE	238 40 40	5.904	above standpt	PIONEER PARK (P)	260 18 50		below standpt
PIONEER PARK (S/P)	260 17 40		above standpt	G.I. PIPE	289 25 30	3.617	above standpt
			below				below
			above standpt				above standpt
			below				below
			above standpt				above standpt
			below				below

Prepared by: L. Hitchins Checked: L. Hitchins Noted on U.T.M. Card

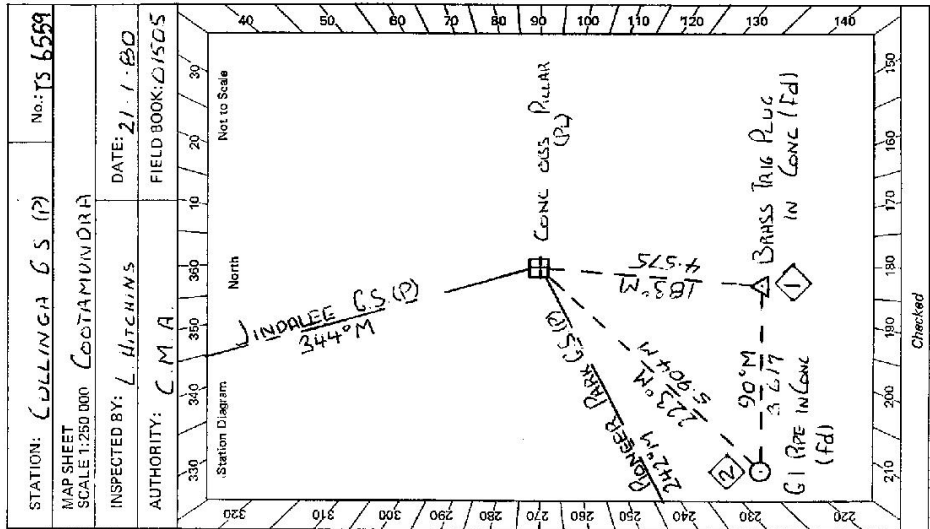


STATION **CULLINGHA C.S (P) TS 6559**

Owner's Name: **K J HARRIS**
 Address: **SHAFTS BURY**
SHAFTS BURY LANE, COTTAMUNDRA
 Phone: **421341**

Current Occupant:
 Address:
 Phone:

ACCESS
 Access Report of **13/9/1979** was found suitable/suitable.

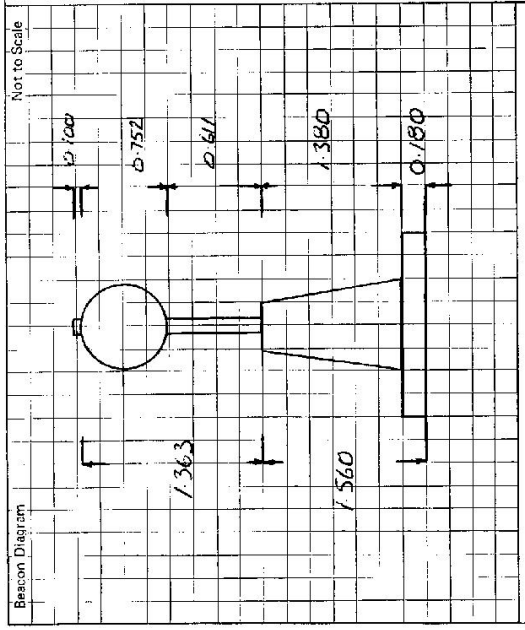

This section to be completed by officer constructing pillar.

Original station mark found ~~not found~~.

Description of mark: **BRASS TRIC PIN IN CONCRETE**

Original beacon found ~~not found~~.

Description of beacon: **CAIRN POLE + DISKS**

Height Top of Vanes to Top Mark: **2.243** m.

Height of mark **0.04** m. above ~~local conc. AT~~ ^{above} G.L.

Diameter of Vanes: **0.612** m.

Height of Cairn: **1.350** m.

Original Beacon has ~~been~~ been destroyed by me.

Date	Record of Station

SI 2735-2 D. West, Government Printer

LAND INFORMATION CENTRE

GEODETTIC SURVEY OF N.S.W.

GEODETTIC STATION RECONNAISSANCE and MAINTENANCE REPORT

STATION: **CULLINGA (P)** No.: **6559**

MAP SHEET SCALE 1:250 000 **COOTAMUNDRA 1:50000**

INSPECTED BY: **R. ELLIS** DATE: **JUNE 1996**

AUTHORITY: **L.I.C.** FIELD BOOK:

Description: *Note: Cross out word or words which do not apply*

1. Cleared by vanes bearing..... from Trig. Mast

2. Mast & Vanes have been painted white & black respectively.

3. The station/pillar was unpiled/not unpiled/constructed on..... 19....., dimensions now being:

Description of mark..... should be explicit, e.g., S/Steel Pillar Plate, Steel plug, Brass plug, Bolt, G.I. Pipe

Height of mark.....m. ^{above} rock/concrete; Mark is.....m. ^{above} G.L. _{below}

Height of Top Vanes to Top Mark/Pillar platem. Diameter of Vanes (vertical).....m.

Height of Cairn.....m. Diameter of Cairn.....m. Name Plate found/not found/placed.

Length of Mastm. (approximate if not unpiled)

4. A..... set in conc/rock has been placed/found, bearing.....° M from Mast/Plug/Pillar

5. A..... set in conc/rock has been placed/found, bearing.....° M from Mast/Plug/Pillar

6. A..... set in conc/rock has been placed/found, bearing.....° M from Mast/Plug/Pillar

7. A..... set in conc/rock has been placed/found, bearing.....° M from Mast/Plug/Pillar

8. Action required:.....

STANDPOINT:

Mark	Direction	Horiz. Distance	Height Difference	Mark	Direction	Horiz. Distance	Height Difference
			above standpt.				above standpt.
			below				below standpt.
			above standpt.				above standpt.
			below				below standpt.
Prepared by:

Julie 30/5/97

Checked:

Noted on U.T.M. Card

Checked

