

74-98

Trigonometrical Survey of N.S.W.

Department of Lands

RECONNAISSANCE and MAINTENANCE REPORT

STATION **ROCKLODGE T.S. 6560**

This Trig. Station has been:-

Note: Cross out word or words which do not apply

1. ~~Completely cleared to permit 360° vision to surrounding Trigs.~~

2. Cleared by lanes bearing Toward Sindalga T.S. from Trig. Mast

3. Trig. Mast & Vanes have been painted white & black respectively.

4. The Trig. was ~~unapplied~~/~~not applied~~, dimensions now being: *(not unapplied)*

Description of mark..... should be explicit, e.g. Steel plug, Brass plug, Bolt, G.I. Pipe

Height of mark..... m ^{above} rock/concrete m ^{below} G.L.

Height of Top Vanes to Top Mark..... m. Diameter of Vanes (vertical)..... m.

Height of Cairn..... m. Diameter of Cairn..... m.

Length of Mast..... 3.6 m. (approximate if not unplied)

P.M.C. B.M. 311 5. A. Brass Plug. set in conc./pack has been placed. 6.2.55 m. bearing 3.27 °M from Trig. Mast

P.M.C. B.M. 310 6. A. Brass Plug. set in conc./soil has been placed. 4.5.04 m. bearing 3.46 °M from Trig. Mast

7. A..... set in conc./soil has been placed..... m. bearing..... °M from Trig. Mast

8. A..... set in conc/rock has been placed..... m. bearing..... °M from Trig. Mast

9. Connection. Brass Plug to Brass Plug: 2.5.45 m. bearing 289 °M

10. Connection..... to..... m. bearing..... °M

11. Connection..... to..... m. bearing..... °M

12. Connection..... to..... m. bearing..... °M

13. Diff. Ht. G.I.P. Near Trig is 3.74 m. ^{above} P.M.C. B.M. 311.....

14. Diff. Ht. " " is 3.89 m. ^{above} P.M.C. B.M. 310.....

15. Diff. Ht. P.M.C. B.M. 310 is 0.14 m. ^{above} P.M.C. B.M. 311.....

16. Diff. Ht. " " is..... m. ^{above}.....

Prepared by: J.W. Bayley, D2, P.M.C. Dept. Checked:

April, 1975

Noted on U.T.M. Card

Checked

Date	Record of Station

Beacon Diagram


Not to Scale

STATION ROCKLODGE T.S. 6560

Owners Name.....
 Current Occupant.....

Address.....
 Address.....

Access.....

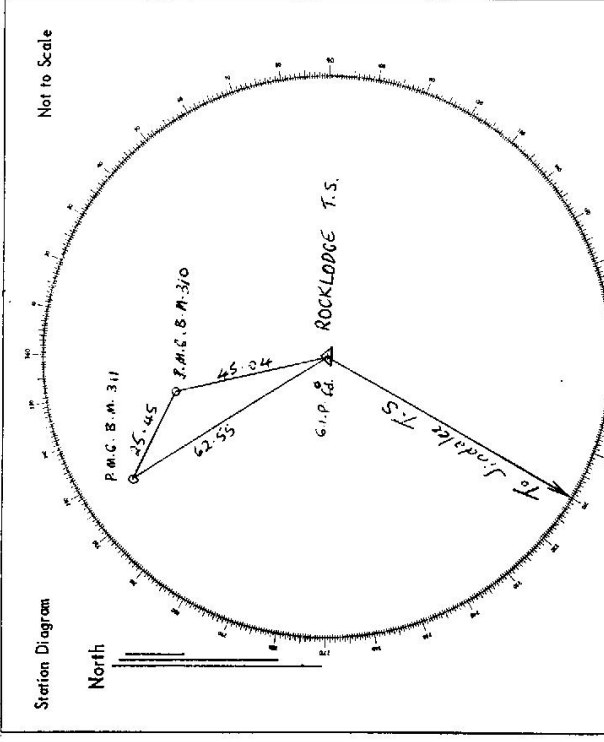


List of Observed Directions:-

Standpoint:		Standpoint:	
Station	Direction	Station	Direction

Standpoint:		Standpoint:	
Station	Direction	Station	Direction

TS 6560
No. 3925

STATION: ROCK LODGE
MAP SHEET
SCALE 1:250 000 COOTAMUNDRA
INSPECTED BY: A. Pattison
DATE: 12-9-19
AUTHORITY: C.M.A.
FIELD BOOK: AB1783

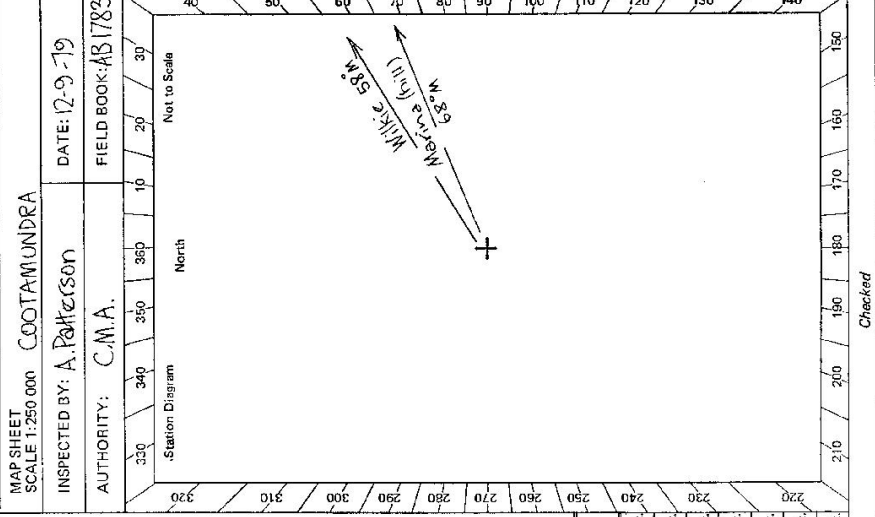

CENTRAL MAPPING AUTHORITY
GEODETTIC SURVEY OF N.S.W.
GEODETTIC STATION RECONNAISSANCE and MAINTENANCE REPORT

Description: *Note: Cross out word or words which do not apply*

1. Cleared by lanes bearing..... SCATTERED..... from Trig. Mast
2. Mast & Vanes have been painted white & black respectively.
3. The station/pillar was ~~unpiled/constructed~~..... 19..... dimensions now being:
Description of mark..... should be explicit, e.g., S/Steel Pillar Plate, Steel plug, Brass plug, Bolt, G.I. Pipe
Height of mark..... m. above rock/concrete; Mark is..... m. above G.L.
Height of Top Vanes to Top Mark/Pillar plate..... m. Diameter of Vanes (vertical)..... m.
Height of Cairn..... m. Diameter of Cairn..... m. Name Plate found/not found/placed.
Length of Mast..... 3.5..... m. (approximate if not unpiled)
4. A..... set in conc/rock has been placed/found, bearing..... ° M from Mast/Plug/Pillar
5. A..... set in conc/rock has been placed/found, bearing..... ° M from Mast/Plug/Pillar
6. A..... set in conc/rock has been placed/found, bearing..... ° M from Mast/Plug/Pillar
7. A..... set in conc/rock has been placed/found, bearing..... ° M from Mast/Plug/Pillar
8. Action required: Construct pillar — some clearing needed see owner first

STANDPOINT:

Mark	Direction	Horiz. Distance	Height Difference	Mark	Direction	Horiz. Distance	Height Difference
			above standpt.				above standpt.
			below standpt.				below standpt.
			above standpt.				above standpt.
			below standpt.				below standpt.
Prepared by: A. Pattison 27/9/19 Checked: *[Signature]* Noted on U.T.M. Card


GS

STATION ROCK LODGE TS 6560

Owner's Name: R.E. Gordon
 Address: P.O. Box 269 Young
 "Mung" Fontenoy Lane, via Mumbat
 Phone: 84 3282
 Current Occupant:
 Address:
 Phone:
 ACCESS 12-9-1979

Access Report of 1979 was found suitable for construction.

- 00 From Young drive south along Olympic Way towards Geotamundra
- 9.3 At Bahinichs Fruit Stall turn right onto gravel road
- 9.9 Turn left & stay on this road
- 13.1 At Intersection proceed through gate towards house
 Signpost 'Demondille Shire - Burrangong Shire'
- 13.6 At house see owner & make way to station
- 14.2 Station

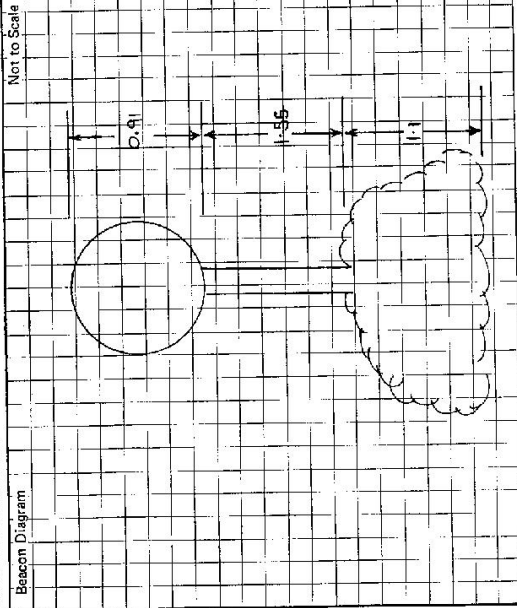

Beacon Diagram

This section to be completed by officer constructing pillar.

Original station mark found/not found.
 Description of mark:
 Original beacon found/not found.
 Description of beacon:
 Height Top of Vanes to Top Mark.....m.
 Height of mark.....m. above G.L. below
 Diameter of Vanes.....m. Height of Cairn.....m.
 Original Beacon has/has not been destroyed by me.

Date	Record of Station
12.9.79	I have spoken to Mr Gordon who has no objection to construction of a pillar Pillar constructed 22.1.1980

GEODETIC SURVEY OF NS/WS

CENTRAL MAPPING AUTHORITY

GEODETIC STATION RECONNAISSANCE and MAINTENANCE REPORT

Description:

1. Cleared by lanes bearing $43^{\circ} 19' 30''$ M, $126^{\circ} 16' 00''$ M, $318^{\circ} 43' 22''$ M from Trig. Mast

2. Mast & Vanes have been painted white & black respectively.

3. The station pillar was ~~unplaced~~ constructed on 12° / 19° D, dimensions now being:

Description of mark: ~~S/S PILLAR PLATE~~ should be explicit, e.g., S/Steel Pillar Plate, Steel plug, Brass plug, Bolt, G.I. Pipe

Height of mark: 1.380 m, above ~~new~~ ^{above} ~~rock~~ ^{G.L.} concrete; Mark is 1.530 m, above ~~new~~ ^{above} ~~rock~~ ^{G.L.}

Height of Top Vanes to Top Mark/Pillar plate: 1.390 m. Diameter of Vanes (vertical): 0.750 m.

Height of Cairn: m. Diameter of Cairn: m. Name Plate ~~found~~/not found/placed.

Length of Mast: m. (approximate if not unplied)

4. A. Brass Trig Plug: set in conc/rock has been placed/found, bearing 322° M from Mast/Plug/Pillar

5. A. G.I. Pipe: set in conc/rock has been placed/found, bearing 323° M from Mast/Plug/Pillar

6. A. set in conc/rock has been placed/found, bearing M from Mast/Plug/Pillar

7. A. set in conc/rock has been placed/found, bearing M from Mast/Plug/Pillar

8. Action required:

STANDPOINT: S/S PILLAR PLATE			STANDPOINT: BRASS TRIG P.L.G.				
Mark	Direction	Horiz. Distance	Height Difference	Mark	Direction	Horiz. Distance	Height Difference
MARINA G.S.	0 00 00		above standpt.	MARINA G.S.	0 00 00		above standpt.
BERTHONG G.S.	183 30 15		above standpt.	S/S PILLAR PLATE	75 30 45	4.063	above standpt.
G I PIPE	243 23 20	1.646	above standpt.	BERTHONG G.S.	183 36 05		above standpt.
BRASS TRIG P.L.G.	255 34 25	4.069	above standpt.	G.I. PIPE	231 53 10	7.347	below standpt.
			below standpt.				below standpt.
			above standpt.				above standpt.
			below				below

Prepared by: *[Signature]*

Checked:

Noted on U.T.M. Card

STATION: **ROCK LODGE G.S (P)** IS No.: **6560**
 MAPSHEET SCALE 1:250 000 **COOTAMUNDARA**
 INSPECTED BY: **L. Hinchins** DATE: **22/1/80**
 AUTHORITY: **C.M.A.** FIELD BOOK: **D/SOS**

Station Diagram
 North
 Not to Scale


08

STATION **ROCK LODGE G.S. (P) IS 6560**

Owner's Name: **A. E. GARAHAN**
 Address: **20 Ross 219 YOUNG**
NUNGLI FORENSIC LANE VIA MUMBAT
 Phone: **843282**

Current Occupant:
 Address:
 Phone:

ACCESS
 Access Report of **12/9/19** was found suitable/unsuitable.

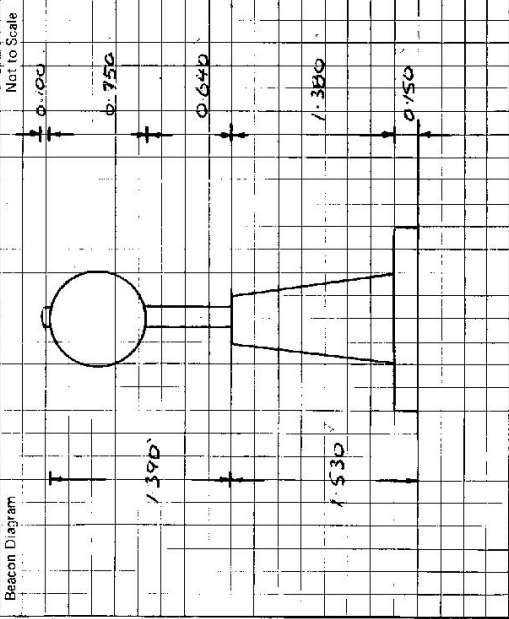

This section to be completed by officer constructing pillar.

Original station mark found/~~not found~~.
 Description of mark: **BRASS TIE PLUG IN CONE**

Original beacon found/~~not found~~.
 Description of beacon: **CAIRN POLE + DISCS**

Height Top of Vane to Top Mark: **3.163** m.
 Height of mark: **0.37** m. above G.L. / **0.37** m. below G.L.
 Diameter of Vane: **0.925** m. Height of Cairn: **1.260** m.

Original Beacon has/~~not~~ been destroyed by me.

Date	Record of Station

CENTRAL MAPPING AUTHORITY
GEODETTIC SURVEY OF N.S.W.

GEODETTIC STATION RECONNAISSANCE and MAINTENANCE REPORT

STATION: **Rock Lodge** No.: **6560**


MAP SHEETS **Coota Murrumbidgee** SCALE 1:100 000
 SCALE 1:250 000
 INSPECTED BY: **M Morrison** DATE: **5/2/87**
 AUTHORITY: **CMA** FIELD BOOK: **R-3/4**

Description:
 1. Cleared by lanes bearing.....
 2. Mast & Vanes have been painted white & black respectively.
 3. The station/pillar was unpiled/not unpiled/constructed on..... 19....., dimensions now being:
 Description of mark..... should be explicit, eg., S/Steel Pillar Plate, Steel plug, Brass plug, Bolt, G.I. Pipe
 Height of mark.....m. ^{above} rock/concrete. Mark is.....m. ^{above} G.L.
 Height of Top Vanes to Top Mark/Pillar plate.....m. Diameter of Vanes (vertical).....m.
 Height of Cairn.....m. Diameter of Cairn.....m. Name Plate found/not found/placed.
 Length of Mast.....m. (approximate if not unpiled) **ACCESS ONLY**


4. A..... set in conc/rock has been placed/found, bearing.....°M from Mast/Plug/Pillar
 5. A..... set in conc/rock has been placed/found, bearing.....°M from Mast/Plug/Pillar
 6. A..... set in conc/rock has been placed/found, bearing.....°M from Mast/Plug/Pillar
 7. A..... set in conc/rock has been placed/found, bearing.....°M from Mast/Plug/Pillar
 8. Action required:.....

STANDPOINT:				STANDPOINT:			
Mark	Direction	Horiz. Distance	Height Difference	Mark	Direction	Horiz. Distance	Height Difference
			above standpt.				above standpt.
			below standpt.				below standpt.
			above standpt.				above standpt.
			below standpt.				below standpt.
Prepared by: *[Signature]* 9/2/87 Checked: *[Signature]* Noted on U.T.M. Card

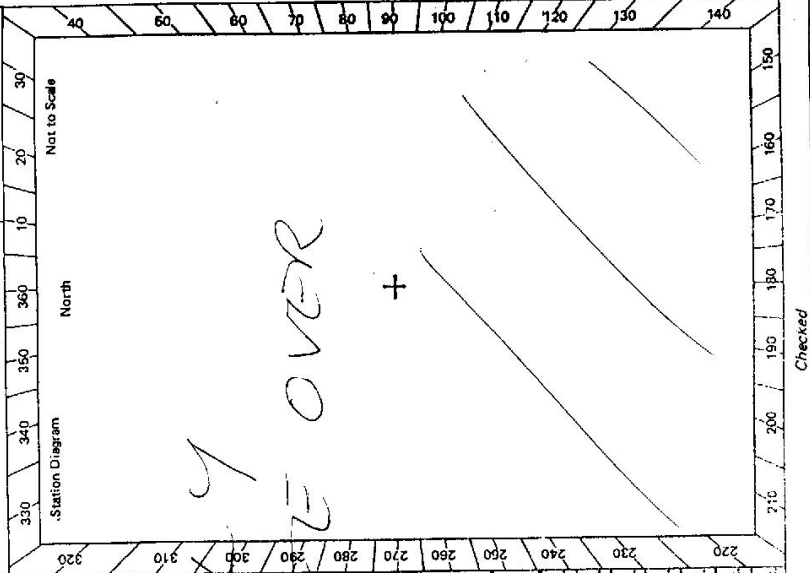

GS 24

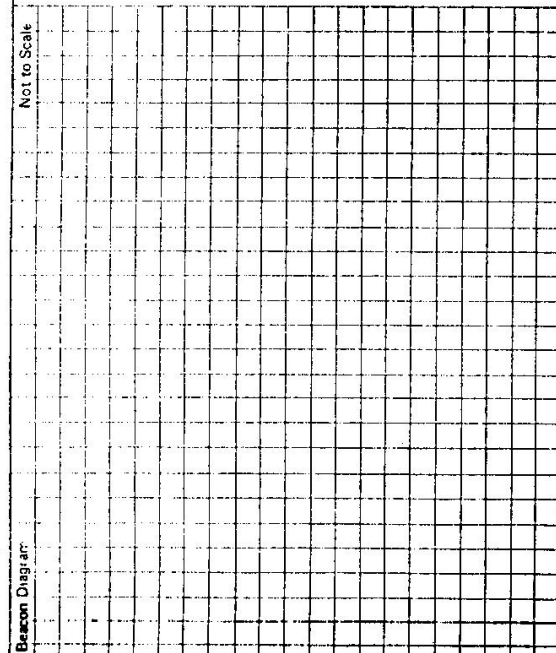STATION Rock Lodge TS 6560	Owner's Name: Address: Phone: Current Occupant: Address: Phone: ACCESS: Access Report of <u>5.12.1987</u> was found suitable/unsuitable. Km <u>DIRECTION</u> 0.0 FROM YOUNG. DRIVE SOUTH ALONG OLYMPICWAY TOWARDS COOTAMUNDRA 9.3 AT BATINICHS FRUIT STALL TURN RIGHT ONTO GRAVEL ROAD 9.9 TURN LEFT AND STAY ON THIS ROAD 13.1 AT 'T' JUNCTION TURN LEFT AND FOLLOW ROAD 13.45 PASS TRACK TO OWNERS HOUSE ON RIGHT. 14.42 TURN RIGHT THROUGH LOCKED GATE (ONE LINK WIRES UP) NEEDS CMA LOCK 14.64 PILLAR ON RIGHT JUST BEFORE TELECOM TOWER.
Beacon Diagram: Not to Scale 	This section to be completed by officer constructing pillar. Original station mark found/not found. Description of mark: Original beacon found/not found. Description of beacon: Height Top of Vanes to Top Mark.....m. Height of mark.....m. above G.L. below Diameter of Vanesm. Height of Cairnm. Original Beacon has/has not been destroyed by me.
Date	Record of Station

