


TS 6561
No. 2194

STATION: MOPPITY
MAP SHEET
SCALE 1:250 000
INSPECTED BY: A Paterson
AUTHORITY: C.M.A.

COOTAMUNDRA
DATE: 12-9-19
FIELD BOOK: AB1783

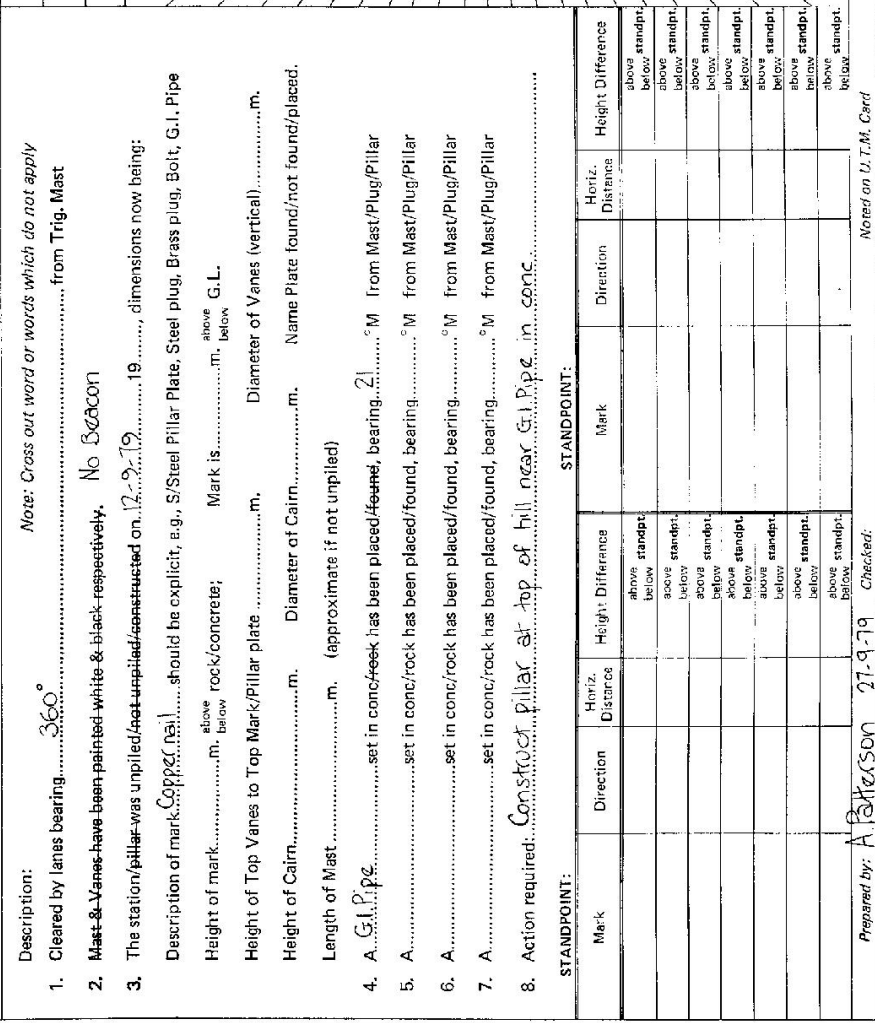

Checked

CENTRAL MAPPING AUTHORITY

GEODETTIC STATION RECONNAISSANCE and MAINTENANCE REPORT

Description: Note: Cross out word or words which do not apply

- Cleared by lens bearing 360° from Trig. Mast
- Mast & Vanes have been painted white & black respectively. No S&B CON
- The station/pillar was unplied/~~not unplied~~/~~constructed~~ on 12-9-19 dimensions now being: Description of mark: Copper Nail should be explicit, e.g., S/Steel Pillar Plate, Steel plug, Brass plug, Bolt, G.I. Pipe
Height of mark m. above rock/concrete; Mark is m. above G.L.
Height of Top Vanes to Top Mark/Pillar plate m. Diameter of Vanes (vertical) m.
Height of Cairn m. Diameter of Cairn m. Name Plate found/not found/placed.
Length of Mast m. (approximate if not unplied)
- A. G.I. Pipe set in conc/rock has been placed/vented, bearing 21° M from Mast/Plug/Pillar
- A. set in conc/rock has been placed/found, bearing M from Mast/Plug/Pillar
- A. set in conc/rock has been placed/found, bearing M from Mast/Plug/Pillar
- A. set in conc/rock has been placed/found, bearing M from Mast/Plug/Pillar
- Action required: Construct pillar at top of hill near G.I. Pipe in conc.

STANDPOINT:

Mark	Direction	Horiz. Distance	Height Difference	Mark	Direction	Horiz. Distance	Height Difference
			above standpt.				above standpt.
			below				below
			above standpt.				above standpt.
			below				below
Prepared by: A. Paterson 27-9-79 Checked: Noted on U.T.M. Card

GS

St 2735-2 D. West, Government Printer

STATION MOPPIY TS 6561	<p>Owner's Name: Frank Davidson Address: "Mogana" Moppity Road Phone: Young 822 617</p> <p>Current Occupant: Address: Phone:</p> <p style="text-align: center;"><u>ACCESS</u></p> <p>Access Report of 12.9.1987 was found suitable/unsuitable.</p> <p>km 0.0 From Young RD. head south along Lynch St 0.1 Turn left into Marina St which becomes Lachlan St 1.0 Turn left - follow road over railway bridge 2.2 Past Drive-in 5.5 Turn left & proceed through gate at top of rise 6.2 Through gate near shed & yards 6.6 Through gate & head up hill towards trees on top of rise 6.9 Site for pillar - near G.I. Pipe (G.S is copper nail 201M, 83m)</p>
Net to Scale	
Beacon Diagram	<p>This section to be completed by officer constructing pillar.</p> <p>Original station mark found/not found.</p> <p>Description of mark:</p> <p>Original beacon found/not found.</p> <p>Description of beacon:</p> <p>Height Top of Vanes to Top Mark.....m. above below above G.L.</p> <p>Height of mark.....m. rock/conc.....m. below</p> <p>Diameter of Vanes.....m. Height of Cairn.....m.</p> <p>Original Beacon has/has not been destroyed by me.</p>
Date	<p>28-8-79 I have spoken to Mr Davidson who has no objection to erection of pillar</p>
Record of Station	

TS 6561
No: 3194


STATION: MOPPIY G.S.

MAP SHEET
SCALE 1:250 000
COOTAMUNDRA

INSPECTED BY: P. CARR

DATE: 19-10-79

AUTHORITY: C.M.A.
FIELD BOOK: 1783

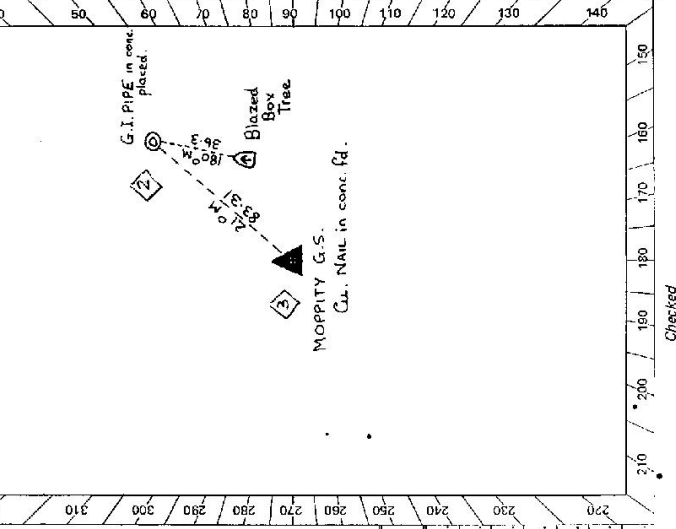

CENTRAL MAPPING AUTHORITY
GEODETTIC SURVEY OF N.S.W.
GEODETTIC STATION RECONNAISSANCE and MAINTENANCE REPORT

Description:
Note: Cross out word or words which do not apply

1. Cleared by lances bearing..... from Trig. Mast
2. Mast & Vanes have been painted white & black respectively.
3. The station/pillar was unpiled/not unpiled/constructed on.....19....., dimensions now being:
Description of mark C.M. NAIL.....should be explicit, e.g. S/Steel Pillar Plate, Steel plug, Brass plug, Bolt, G.I. Pipe
Height of mark.....m. above below rock/concrete; Mark is.....m. above below G.L.
4. A.....G.I. PIPE.....set in conc/rock has been placed/found, bearing.....21.....° M from Mast/Plug/Pillar
Height of Top Vanes to Top Mark/Pillar plate N/A.....m. Diameter of Vanes (vertical) N/A.....m.
5. A.....Cu. Nail.....set in conc/rock has been placed/found, bearing.....° M from Mast/Plug/Pillar
Height of Cairn.....N/A.....m. Diameter of Cairn.....m. Name Plate found/not found/placed.
6. A.....Cu. Nail.....set in conc/rock has been placed/found, bearing.....° M from Mast/Plug/Pillar
Length of Mast.....m. (approximate if not unpiled)
7. A.....Cu. Nail.....set in conc/rock has been placed/found, bearing.....° M from Mast/Plug/Pillar
8. Action required:.....

STANDPOINT: <u>Cu. NAIL in conc.</u>		STANDPOINT: <u>G.I. PIPE in conc.</u>	
Mark	Direction	Horiz. Distance	Height Difference
<u>PM 15765</u>	<u>0 00 00</u>		above standpt.
<u>YOUNG G.S.</u>	<u>0 00 00</u>		above standpt.
<u>G.I. PIPE in conc.</u>	<u>78 30 41</u>	<u>83.302</u>	above standpt.
<u>WILKIE G.S.</u>	<u>252 15 18</u>	<u>4.626</u>	above standpt.
			below standpt.
			above standpt.
			below standpt.
			above standpt.
			below standpt.
			above standpt.
			below standpt.
			above standpt.
			below standpt.

Prepared by: P. CARR /4/12/79
Checked: Checked
Noted on U.T.M. Card

GEODETIC SURVEY OF N.S.W.

CENTRAL MAPPING AUTHORITY


GEODETIC STATION RECONNAISSANCE and MAINTENANCE REPORT

STATION: **Moppity G.S (P)** No.: **6561**

MAP SHEET SCALE 1:250 000 **COOTAMUNDRA**

INSPECTED BY: **L. HITCHINS** DATE: **23 1.80**

AUTHORITY: **C.M.A** FIELD BOOK: **D.S.O.S**

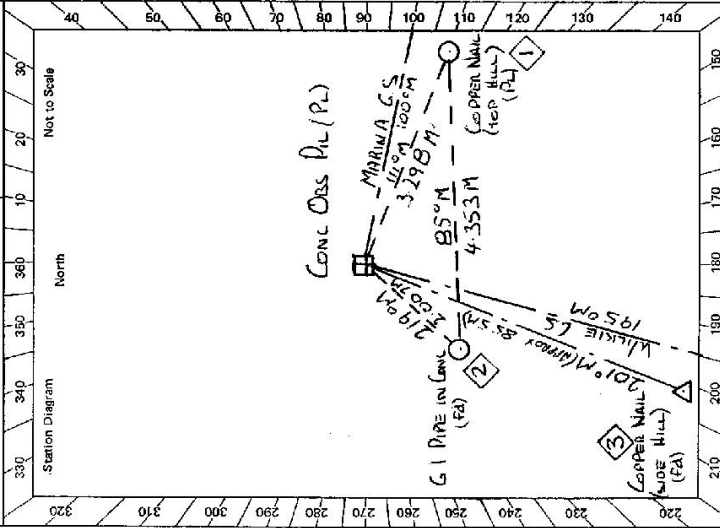

- Description: **36.0° M**
 Note: Cross out word or words which do not apply
 1. Cleared by lanes bearing..... from Trig. Mast
 2. Mast & Vanes have been painted white & black respectively.
 3. The ~~station~~/pillar was ~~emptied/not emptied~~/constructed on **11.1** **19.80** dimensions now being:
 Description of mark **S/S Pillar Plate** should be explicit, e.g. S/Steel Pillar Plate, Steel plug, Brass plug, Bolt, G.I. Pipe
 Height of mark **1.380** m. ~~above~~ ~~concrete~~ ~~hook~~ ~~concrete~~; Mark is **1.480** m. ~~above~~ ~~G.L.~~
 Height of Top Vanes to Top ~~Mark~~/Pillar plate **1.399** m. Diameter of Vanes (vertical) **0.753** m.
 Height of Cairn.....m. Diameter of Cairn.....m. Name Plate ~~found~~/not ~~found~~/placed.
 Length of Mast.....m. (approximate if not unpiled)
 4. A **G.I. PIPE** set in conc/~~hook~~ has been ~~placed~~/found, bearing **219**° M from ~~Mast~~/~~Flag~~/Pillar
 (SIDE HILL)
 5. A **COPPER NAIL** set in conc/~~hook~~ has been ~~placed~~/found, bearing **201**° M from ~~Mast~~/~~Flag~~/Pillar
 (TOP HILL)
 6. A **COPPER NAIL** set in conc/~~hook~~ has been ~~placed~~/found, bearing **111**° M from ~~Mast~~/~~Flag~~/Pillar
 (TOP HILL)
 7. A..... set in conc/~~hook~~ has been ~~placed~~/found, bearing.....° M from Mast/~~Flag~~/Pillar
 8. Action required:.....

Mark	Direction	Horiz. Distance	Height Difference	Mark	Direction	Horiz. Distance	Height Difference
WILKIE C.S. 1	0 60 00		above standpt.	WILKIE C.S. 1	0 60 00		above standpt.
COP NAIL (SIDE HILL)	6 31 20		above standpt.	COP NAIL (SIDE HILL)	6 42 25		above standpt.
G.I. PIPE 2	23 13 30	2 007	above standpt.	G.I. PIPE 2	69 21 35	4 353	above standpt.
MARINA G.S.	265 10 15		above standpt.	S/S PILLAR PLATE	95 28 10	3 300	above standpt.
COP NAIL (TOP HILL)	275 30 20	3 296	above standpt.	MARINA G.S.	265 07 50		above standpt.

STANDPOINT: **S/S PILLAR PLATE** STANDPOINT: **COPPER NAIL IN CONC (TOP HILL)**

Prepared by: *[Signature]* Checked: *[Signature]* Noted on U.T.M. Card

GS

STATION MOPPIY TS 6561	Owner's Name: F RANK DAVIDSON Address: YERANA MOPPIY ROAD Phone: 92767 Current Occupant: Address: Phone: ACCESS Access Report of 2/2/1979 was found suitable/ unsuitable .
Beacon Diagram Not to Scale 	This section to be completed by officer constructing pillar. Original station mark found/ not found . Description of mark: COPPER NAIL IN CONE SURF Original beacon found /not found. Description of beacon: Height Top of Vanes to Top Mark.....m. Height of mark 5.03 m. above mark/cone AT below ^{above} G.L. Diameter of Vanesm. Height of Cairnm. Original Beacon has been been destroyed by me .
	Date Record of Station

GEODETTIC SURVEY OF N.S.W.

CENTRAL MAPPING AUTHORITY

GEODETTIC STATION RECONNAISSANCE and MAINTENANCE REPORT

Description:

1. Cleared by lanes bearing..... Note: Cross out word or words which do not apply
..... from Trig. Mast
2. Mast & Vanes have been painted white & black respectively.
3. The station/pillar was unpiled/not unpiled/constructed on..... 19....., dimensions now being:
Description of mark..... should be explicit, e.g., S/Steel Pillar Plate, Steel plug, Brass plug, Bolt, G.I. Pipe
Height of mark.....m. above below rock/concrete; Mark is.....m. above G.L.
- Height of Top Vanes to Top Mark/Pillar plate.....m. Diameter of Vanes (vertical).....m.
- Height of Cairn.....m. Diameter of Cairn.....m. Name Plate found/not found/placed.
- Length of Mast.....m. (approximate if not unpiled)
4. A..... set in conc/rock has been placed/found, bearing.....° M from Mast/Plug/Pillar
5. A..... set in conc/rock has been placed/found, bearing.....° M from Mast/Plug/Pillar
6. A..... set in conc/rock has been placed/found, bearing.....° M from Mast/Plug/Pillar
7. A..... set in conc/rock has been placed/found, bearing.....° M from Mast/Plug/Pillar
8. Action required: **New Access** as at **6/9/89**.....

STANDPOINT:

Mark	Direction	Horiz. Distance	Height Difference	Mark	Direction	Horiz. Distance	Height Difference
			above standpt.				above standpt.
			below standpt.				below standpt.
			above standpt.				above standpt.
			below standpt.				below standpt.
Prepared by:

Checked:

Noted on U.T.M. Card

Checked

