

CENTRAL MAPPING AUTHORITY

Department of Lands

Trigonometrical Survey of N.S.W.

RECONNAISSANCE and MAINTENANCE REPORT

This Trig. Station has been:-

Note: Cross out word or words which do not apply

1. Completely cleared to permit 360° vision to surrounding Trigs.
2. Cleared by lanes bearing ..... from Trig. Mast
3. Trig. Mast & Vanes have been painted white & black respectively.
4. The Trig. was unpiled/not unpiled, dimensions now being: Original Station Mark found or found

Description of mark ..... should be explicit, e.g. Steel plug, Brass plug, Bolt, G.I. Pipe  
 Height of mark ..... m above below rock/concrete ..... m above below G.L.  
 Height of Top Vanes to Top Mark ..... m. Diameter of Vanes (vertical) ..... m.  
 Height of Cairn ..... m. Diameter of Cairn ..... m.  
 Length of Mast ..... m. (approximate if not unpiled)

5. A ..... set in conc/rock has been placed ..... m. bearing .....°M from Trig. Mast
6. A ..... set in conc/soil has been placed ..... m. bearing .....°M from Trig. Mast
7. A ..... set in conc/soil has been placed ..... m. bearing .....°M from Trig. Mast
8. A ..... set in conc/rock has been placed ..... m. bearing .....°M from Trig. Mast
9. Connection ..... to ..... m. bearing .....°M
10. Connection ..... to ..... m. bearing .....°M
11. Connection ..... to ..... m. bearing .....°M
12. Connection ..... to ..... m. bearing .....°M
13. Diff. Ht. .... is ..... m. above below
14. Diff. Ht. .... is ..... m. above below
15. Diff. Ht. .... is ..... m. above below
16. Diff. Ht. .... is ..... m. above below

Prepared by: *[Signature]* 14/12/77 Checked: *[Signature]*


Noted on U.T.M. Card

STATION MUMBIGLE TS 6562

Co: ASHBURNHAM Ph: MUMBIGLE

Map Sheet: FORBES No: 8531 IL&III  
 Inspected by: N. MORTON Date: DECEMBER 1977  
 Authority: Field Book:

Beacon Diagram Not to Scale

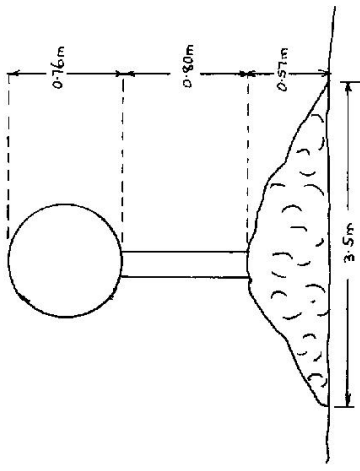

Date Record of Station



GEODETIC SURVEY OF R.S.W.

CENTRAL MAPPING AUTHORITY

GEODETIC STATION RECONNAISSANCE and MAINTENANCE REPORT

Description:

1. Cleared by lanes bearing 360° M Except TRIG BY 3509 from Trig, Mast  
*Note: Cross out word or words which do not apply*
2. Mast & Vanes have been painted white & black respectively. ✓
3. The ~~station~~/pillar was ~~reconstructed~~/constructed on 19....., dimensions now being:  
Description of mark S/S (G.I.) should be explicit, e.g., S/Steel Pillar Plate, Steel plug, Brass plug, Bolt, G.I. Pipe  
Height of mark 1.370.....m. <sup>above</sup> ~~below~~ concrete/concrete; Mark is 1.520.....m. <sup>above</sup> ~~below~~ G.L. ✓  
Height of Top Vanes to Top Mast/Pillar plate 1.390.....m. Diameter of Vanes (vertical): 0.150.....m.  
Height of Cairn.....m. Diameter of Cairn.....m. Name Plate ~~is placed~~/placed.  
Length of Mast.....m. (approximate if not unplied)
4. BOSS TAG PLUG set in conc/rock has been placed/found, bearing 280° M from Mast/Pillar
5. G.I. PIPE set in conc/rock has been placed/found, bearing 343° M from Mast/Pillar
6. G.I. PIPE set in conc/rock has been placed/found, bearing 50° M from Mast/Plug/Pillar
7. A..... set in conc/rock has been placed/found, bearing.....° M from Mast/Plug/Pillar
8. Action required.....

Mark	Direction	Horiz. Distance	Height Difference	Mark	Direction	Horiz. Distance	Height Difference
DULLUNTY (G.O)	0 00 00		above standpt	DULLUNTY (G.O)	0 00 00		above standpt
G.I. PIPE	44 56 40	3.202	below standpt	MILBANEH (G.O)	76 44 50		below standpt
MILBANEH (G.O)	76 42 50		above standpt	G.I. PIPE	114 50 50	3.917	above standpt
BOSS TAG PLUG	34 42 00	4.123	below standpt	CONC OBS PLUG	161 42 00	4.126	above standpt
			below				below
			above standpt				above standpt
			below				below
			above standpt				above standpt
			below				below

Prepared by: PLATE 254 MAR 2019 Checked: Z. M. [Signature] 14/4/2022 Noted on U.T.M. Card

Sr 2733-1

STATION: MUMBINDALE (G.S. (P)) TS No.: 6562

MAP SHEET SCALE 1:250 00P

INSPECTED BY: P. BOSS DATE: 19.3.80

AUTHORITY: C.M.A. FIELD BOOK: 1688

Station Diagram

North

Not to Scale

GS


**STATION MUMBINGALE (8810) TS 6562**

Owner's Name: Mk A S Hooper  
 Address: LINE VANE  
 Phone: (068) 533 172

Current Occupant: .....  
 Address: .....  
 Phone: .....

ACCESS: FROM FORBES PO TRAVEL NORTH (NEWELL HWY) FOR APT 7.8km TO BAROODBALSIE.

Access Report of 11.2/1980 was found suitable/unsuitable.  
VERTUZE  
DAROD BALSIE HEAD WEST TOWARDS RAILWAY LINE  
CROSS RAILWAY LINE  
TURN RIGHT SLOWLY'S ROAD  
END SEALED ROAD  
TURN LEFT TOWARDS IRON GATE SIGN. HB HOOPER LINE VANE  
TURN LEFT OFF MAIN ROAD JUST THROUGH GATEWAY  
DOUBLE IRON GATE.  
THRU 2 SETS OF DOUBLE IRON GATES. PIG SHED ON RIGHT. FOLLOW TRACK TO LEFT.  
DOUBLE IRON GATE GO THROUGH AND TURN RIGHT  
UP RIDGE - FOLLOW TRACK  
MUMBINGALE BS

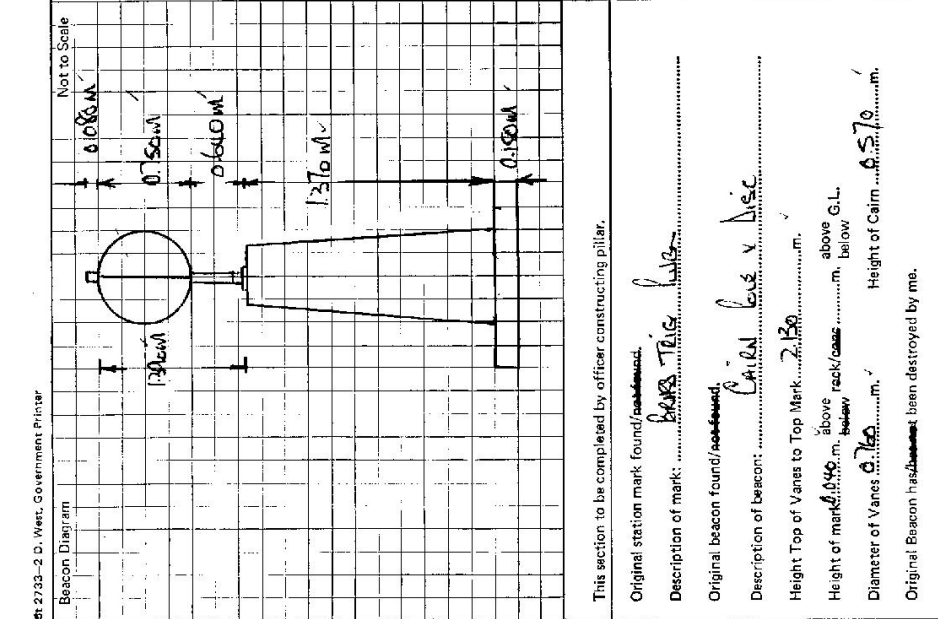

Date	Record of Station
21-9-89	Station visited for EDM <u>Alphata</u>