

CENTRAL MAPPING AUTHORITY

GEODETIC SURVEY OF N.S.W.

GEODETIC STATION RECONNAISSANCE and MAINTENANCE REPORT

Description:

1. Cleared by lanes bearing... *Note: Cross out word or words which do not apply*
 2. Mast & Vanes have been painted white & black respectively.
 3. The station/pillar was unpainted/not unpainted/constructed on.....19....., dimensions now being:

Description of mark.....should be explicit, e.g., S/Steel Pillar Plate, Steel plug, Brass plug, Bolt, G.I. Pipe

Height of mark.....m. ^{above} _{below} rock/concrete; Mark is.....m. ^{above} _{below} G.L.

Height of Top Vanes to Top Mark/Filler plate.....m. Diameter of Vanes (vertical).....m.

Height of Cairn.....m. Diameter of Cairn.....m. Name Plate ~~found~~/not found/~~placed~~.

Length of Mast.....m. (approximate if not unpiled)

4. A.....set in conc/rock has been placed/found, bearing.....°M from Mast/Plug/Pillar
 5. A.....set in conc/rock has been placed/found, bearing.....°M from Mast/Plug/Pillar
 6. A.....set in conc/rock has been placed/found, bearing.....°M from Mast/Plug/Pillar
 7. A.....set in conc/rock has been placed/found, bearing.....°M from Mast/Plug/Pillar

8. Action required: Can drive to station - exact pillar

STANDPOINT:

STANDPOINT:

Mark	Direction	Horiz. Distance	Height Difference	Mark	Direction	Horiz. Distance	Height Difference
			above below standpt				above below standpt
			above below standpt				above below standpt
Prepared by:

Checked: Kay/Hal 4/3/80

Noted on U.T.M. Card


Checked

Ss 2233-1

TS 6564-
 STATION: JINDALEE
 MAP SHEET
 SCALE 1:250 000
 INSPECTED BY: A PATTERSON
 DATE: 13-9-79
 AUTHORITY: C.M.A.
 FIELD BOOK: AB.1784

MAP SHEET
 SCALE 1:250 000
 INSPECTED BY: A PATTERSON
 DATE: 13-9-79
 AUTHORITY: C.M.A.
 FIELD BOOK: AB.1784

MAP SHEET
 SCALE 1:250 000
 INSPECTED BY: A PATTERSON
 DATE: 13-9-79
 AUTHORITY: C.M.A.
 FIELD BOOK: AB.1784

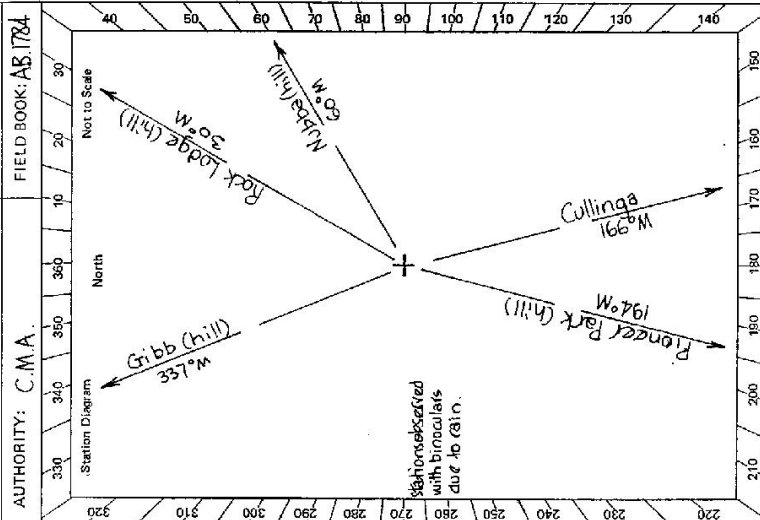

STATION

JINDALEE

IS 6564

Owner's Name

Eddie McInan

Current Occupant

Address

Phone

Access

ACCESS

Access Report of 13.9/1979 was found suitable/unsuitable.

Access km

0.0 - 18km north of Coofamundra on Olympic Way at Kallandbeen at Esso garage turn left & head west towards Temora

1.0 Over railway bridge & turn left towards Morrisons Hill

4.45 Under railway bridge

4.6 Straight ahead - follow railway line

6.8 Turn right & then over grid

6.9 Turn left before house & make way up hill

7.7 Station at top - can drive right to top

Not to Scale

Beacon Diagram

This section to be completed by officer constructing pillar.

Original station mark found/not found.

Description of mark:

Original beacon found/not found.

Description of beacon:

Height Top of Vane to Top Mark.

Height of mark above rock/conc below G.L.

Diameter of Vane

Height of Cairn

Original Beacon has/not been destroyed by ms.

CENTRAL MAPPING AUTHORITY

GEODETIC SURVEY OF N.S.W.

GEODETIC STATION RECONNAISSANCE and MAINTENANCE REPORT

Description:

1. Cleared by Janes bearing 360° with some ~~SATURATED TREES~~ ^{from Trig. Mast} Note: Cross out word or words which do not apply

2. Mast & Vanes have been painted white & black respectively.

3. The station/pillar was ~~emptied~~ ^{not emptied} constructed on 17.1 1980 , dimensions now being:

Description of marks/s Pillar Plate should be explicit, e.g., S/Steel Pillar Plate, Steel plug, Brass plug, Bolt, G.I. Pipe

Height of mark 1380 m. ^{above} ~~below~~ ^{above} ~~below~~ G.L. Mark is 1520 m. ^{above} ~~below~~ G.L.

Height of Top Vanes to Top Mark/Pillar plate 1394 m. Diameter of Vanes (vertical) 0.754 m.

Height of Cairn 0 m. Diameter of Cairn 0 m. Name Plate ~~found~~ ^{found} / not ~~found~~ ^{found} / placed.

Length of Mast 0 m. (approximate if not unplied)

4. A. Brass Trig. Plug 92° M set in conc/rock has been ~~placed~~ ^{placed} / found, bearing 92° M from Mast/Plug/Pillar

5. A. G.I. Pipe 117° M set in conc/rock has been ~~placed~~ ^{placed} / found, bearing 117° M from Mast/Plug/Pillar

6. A. 0 M set in conc/rock has been placed / found, bearing 0° M from Mast/Plug/Pillar

7. A. 0 M set in conc/rock has been placed / found, bearing 0° M from Mast/Plug/Pillar

8. Action required: 0 M


STANDPOINT: S/S PILLAR PLATE STANDPOINT: BRASS TRIG AUG

Mark	Direction	Horiz. Distance	Height Difference	Mark	Direction	Horiz. Distance	Height Difference
PIONEER PARK G.S.	000°	000.00	above standpt.	PIONEER PARK G.S.	000°	000.00	above standpt.
BRASS TRIG AUG	$257^\circ 17' 35"$	3702	above standpt.	S/S PILLAR PLATE	$77^\circ 15' 50"$	3705	above standpt.
G.I. PIPE	$181^\circ 30' 05"$	7820	below standpt.	G.I. PIPE	$300^\circ 23' 10"$	4693	below standpt.
CULLINGA G.S.	$327^\circ 15' 15"$	0	above standpt.	CULLINGA G.S.	$327^\circ 15' 35"$	0	above standpt.
			above standpt.				above standpt.
			below standpt.				below standpt.
			below standpt.				below standpt.
			below standpt.				below standpt.
			below standpt.				below standpt.

Prepared by: *[Signature]*Checked: *[Signature]*

Noted on U.T.M. Card

S: 2733-1

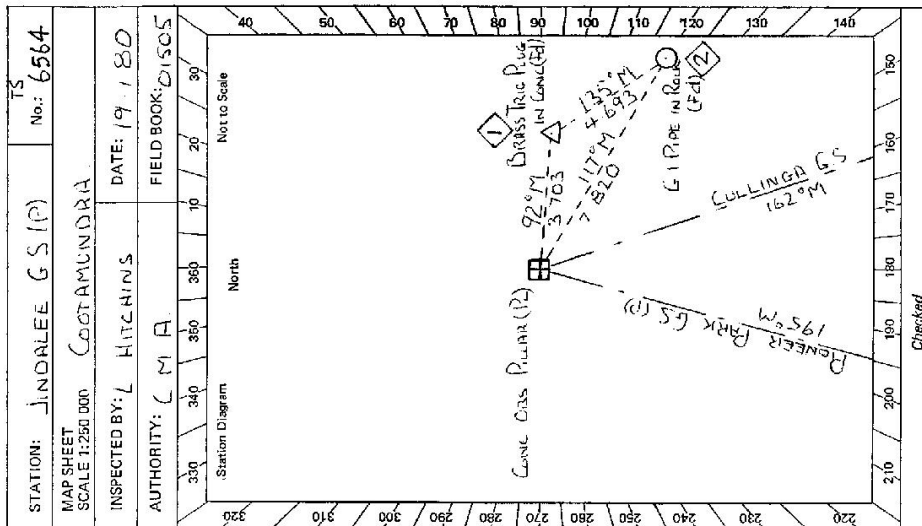

STATION JINDALEE GS (P)^{TS} 6564	<div style="display: flex; justify-content: space-between;"> <div> <p>Owner's Name: MR. J. J. HOLIHAN</p> <p>Address: AVONDALE YOUNG RD</p> <p>Phone: 4325520</p> </div> <div> <p>Current Occupant:</p> <p>Address:</p> <p>Phone:</p> </div> </div> <p style="text-align: center;">ACCESS</p> <p>Access Report of 13/9/19th was found suitable/unsuitable:</p>
Beacon Diagram	
<p>This section to be completed by officer constructing pillar.</p> <p>Original station mark found/not found.</p> <p>Description of mark: BRASS TRIG PLUG IN CONCRETE</p> <p>Original beacon found/not found.</p> <p>Description of beacon: CAIRN POLE + DISCS</p> <p>Height Top of Vanes to Top Mark 2.943 m.</p> <p>Height of mark 2.075 m. above G.L. below G.L.</p> <p>Diameter of Vanes 1.180 m. Height of Cairn 0.925 m.</p> <p>Original Beacon has/has not been destroyed by me.</p>	
Date	Record of Station

LAND INFORMATION CENTRE

GEODETIC SURVEY OF N.S.W.

GEODETIC STATION RECONNAISSANCE and MAINTENANCE REPORT

Description:

1. Cleared by lanes bearing..... *Note: Cross out word or words which do not apply*
2. Mast & Vanes have been painted white & black respectively. from Trig. Mast
3. The station/pillar was unpiled/not unpiled/constructed on..... 19....., dimensions now being:
- Description of mark..... should be explicit, e.g., S/Steel Pillar Plate, Steel plug, Brass plug, Bolt, G.I. Pipe
- Height of mark.....m. ^{above} rock/concrete; Mark is.....m. ^{above} G.L. _{below}
- Height of Top Vanes to Top Mark/Pillar platem. Diameter of Vanes (vertical).....m.
- Height of Cairn.....m. Diameter of Cairn.....m. Name Plate found/not found/placed.
- Length of Mastm. (approximate if not unpiled)
4. A.....set in conc/rock has been placed/found, bearing.....°M from Mast/Plug/Pillar
5. A.....set in conc/rock has been placed/found, bearing.....°M from Mast/Plug/Pillar
6. A.....set in conc/rock has been placed/found, bearing.....°M from Mast/Plug/Pillar
7. A.....set in conc/rock has been placed/found, bearing.....°M from Mast/Plug/Pillar
8. Action required:.....

STANDPOINT:

STANDPOINT:

Mark	Direction	Horiz. Distance	Height Difference	Mark	Direction	Horiz. Distance	Height Difference
			above standpt.				above standpt.
			below				below
			above standpt.				above standpt.
			below				below
Prepared by:

Checked:

Noted on U.T.M. Card

S: 2735-1

STATION: JINDALEE(P)

MAP SHEET
SCALE 1:250 000


No.: 6564

INSPECTED BY: R. ELLIS

DATE: 24/6/96.

AUTHORITY: LIC

FIELD BOOK:

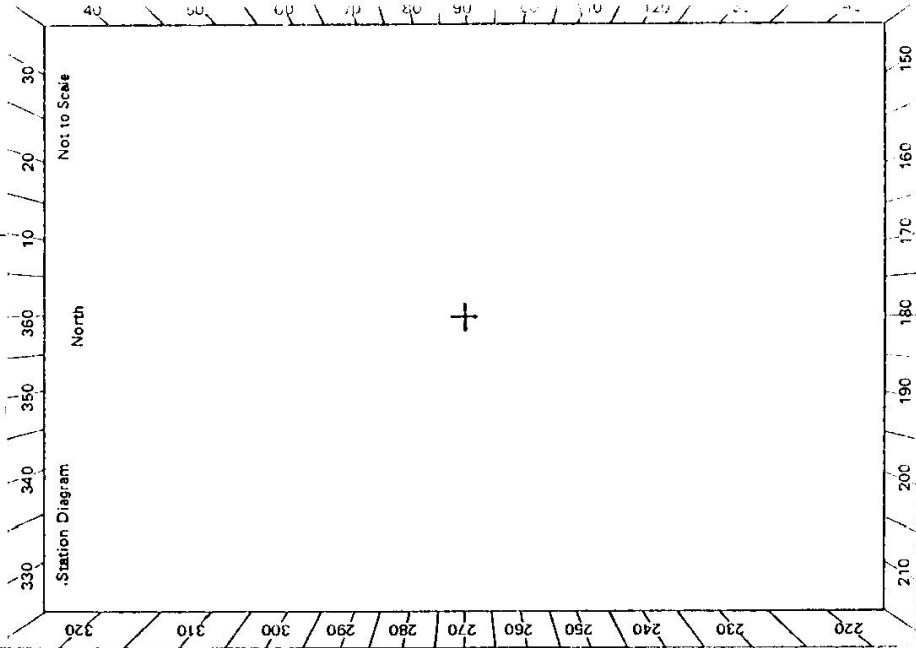

Checked

ST 2733--2 D. West, Government Printer

STATION		JINDALEE (P) TS 6564	
Owner's Name: <u>Mr. J.J. Holihan</u>	Current Occupant: <u>Mr. Anderson</u>	Address: <u>"Avondale" Yang Rd</u>	Address: <u>Morrison Hill Road</u>
Address: <u>Cooramburra</u>			Address: <u>Jindalee (see access)</u>
Phone: <u>069 432520</u>			Phone:
ACCESS			
Access Report of <u>13.9.1979</u> was found <u>suitable/unsuitable</u> .			
<p><u>Km</u></p> <p>0.00 At the intersection of the Olympic Way & Nth Jindalee Road follow Gravel Road</p> <p>0.03 Pass West Jindalee Rd</p> <p>1.00 Pass under Rail Bridge.</p> <p>2.00 Pass over rail bridge.</p> <p>3.09 Pass windmill on RHS</p> <p>4.8 Turn left into Blondval Lane</p> <p>5.7 Turn left into Morrison Hill Road</p> <p>7.7 Property owners entrance (Mr Anderson)</p> <p>7.8 Out of owners place ~ turn right and head west along Morrison Hill Road.</p> <p>8.0 Over rail bridge</p> <p>8.2 Through double white gates.</p> <p>8.25 Follow fence to left on dirt track.</p> <p>8.3 Through fenced gate and follow fence on left the drive to hill top.</p> <p>8.4 Pass water tank on right</p> <p>8.6 End of fenceline which veers left - drive to top of hill</p> <p>9.0 JINDALEE (P)</p>			
Date	Record of Station		
<u>24/6/96</u>	<u>Goos GPS 360° and cleared hill 360°.</u>		
<p>This section to be completed by officer constructing pillar.</p> <p>Original station mark found/not found.</p> <p>Description of mark:</p> <p>Original beacon found/not found.</p> <p>Description of beacon:</p> <p>Height Top of Vanes to Top Markm.</p> <p>Height of markm. above rock/contm. below G.L.</p> <p>Diameter of Vanesm. Height of Cairnm.</p> <p>Original Beacon has/has not been destroyed by me.</p>			