

TS 6565

No.: 3243

CENTRAL MAPPING AUTHORITY

GEODETTIC STATION RECONNAISSANCE and MAINTENANCE REPORT

Description:

1. Cleared by lanes bearing.....  $360^\circ$  VISION. *Note: Cross out word or words which do not apply*

2. Mast & Vanes have been painted white & black respectively. MAST & VANES DESTROYED

3. The station/pillar was unplaced/constructed on..... 19....., dimensions now being:   
 Description of mark.....  $1.0 \times 1.0$  m. should be explicit, e.g., S/Steel Pillar Plate, Steel plug, Brass plug, Bolt, G.I. Pipe

Height of mark..... m. above rock/concrete; Mark is..... m. above G.L.

Height of Top Vanes to Top Mark/Pillar plate..... m. Diameter of Vanes (vertical)..... m.

Height of Cairn..... m. Diameter of Cairn..... m. Name Plate found/not found/placed.

Length of Mast..... m. (approximate if not unplaced)

4. A..... set in conc/rock has been placed/found, bearing..... M from Mast/Plug/Pillar

5. A..... set in conc/rock has been placed/found, bearing..... M from Mast/Plug/Pillar

6. A..... set in conc/rock has been placed/found, bearing..... M from Mast/Plug/Pillar

7. A..... set in conc/rock has been placed/found, bearing..... M from Mast/Plug/Pillar

8. Action required: CONCRETE PILLAR TO BE ERASED

STANDPOINT: TRIG PLUG LOOSE

Mark	Direction	Horiz. Distance	Height Difference	Mark	Direction	Horiz. Distance	Height Difference
			above standpt.				above standpt.
			below				below
			above standpt.				above standpt.
			below				below
Prepared by: P. CARR 19/12/79

Checked:

St 2733-1

Noted on U.T.M. Card

Checked

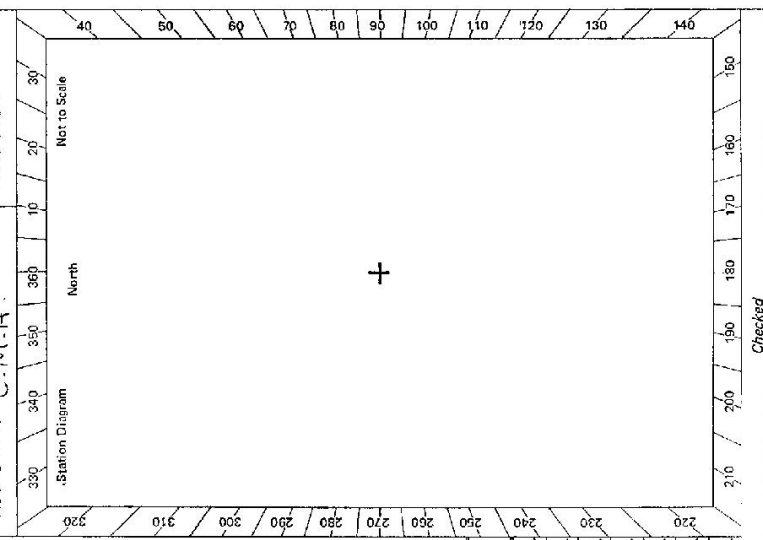

MAP SHEET SCALE 1:250 000

INSPECTED BY: P. CARR

AUTHORITY: C.M.A.

DATE: 28/11/79

FIELD BOOK:

Not to Scale

65

STATION <b>MUGINCUBLE G.S. TS 6565</b>	Owner's Name: ..... Address: <b>Access Ref. 7.6 km</b> ..... Phone: .....	Current Occupant: ..... Address: ..... Phone: .....	
Access Report of <b>28/11/79</b> was found suitable/unavailable.		ACCESS	
Beacon Diagram	Not to Scale	Access Report of <b>28/11/79</b> was found suitable/unavailable.	
This section to be completed by officer constructing pillar.			
Original station mark found/not found.			
Description of mark: .....			
Original beacon found/not found.			
Description of beacon: .....			
Height Top of Vanes to Top Mark.....m.			
Height of mark.....m. above rock/conc.....m. below G.L.			
Diameter of Vanes .....m. Height of Cairn .....m.			
Original Beacon has/not been destroyed by me.			

0.0 PARKES P.O. Head towards Orange  
 1.3 Turn right at East St.  
 1.6 Cross railway  
 1.8 Turn right  
 2.0 Turn left into Fisher St.  
 5.6 Turn left and cross wooden bridge  
 6.1 Turn left and go through grid "Battleys Creek"  
 6.65 Grid.  
 7.1 Grid  
 7.4 Take right fork  
 7.6 Follow track to left around owner's house  
 7.7 Gate. Straight ahead. Turn right after sheds + follow track  
 7.8 Gate. Turn left after yards + go towards hayshed along track.  
 8.1 Veer right.  
 8.4 Causeway.  
 8.7 Follow track through gate on right.  
 9.1 Gate. 9.9 Gate. 10.7 Gate.  
 10.9 Turn left at end of fence + follow fence along rough track.  
 11.9 Gate. Turn left + follow fence after gate.  
 12.1 Follow fence to right.  
 12.7 Gate on L.H.S. Go through + follow fence to right.  
 12.9 Through break in fence on right Go up to top of rise  
 13.1 ~~Follow along track to 5.0 of rocky ridge.~~

Checked, BL 28-12-79

Record of Station

Date: 6

CENTRAL MAPPING AUTHORITY

GEODETIC SURVEY OF N.S.W.

GEODETIC STATION RECONNAISSANCE and MAINTENANCE REPORT

Description:

1. Cleared by lanes bearing  $260^\circ$ . Note: Cross out word or words which do not apply  
 from Trig. Mast

2. Mast & Vanes have been painted white & black respectively. ✓

3. The ~~standpoint~~ pillar was ~~constructed~~/constructed on ~~24 MARCH 1960~~, dimensions now being:

Description of marks ~~S.P. (G.S.P.)~~ could be explicit, e.g., S/Steel Pillar Plate, Steel plug, Brass plug, Bolt, G.I. Pipe

Height of mark  $1.370$  m. above ~~concrete~~/concrete; Mark is  $1.520$  m. above G.L.

Height of Top Vanes to Top ~~Mast~~/Pillar plate  $1.110$  m. Diameter of Vanes (vertical)  $0.760$  m.

Height of Cairn.....m. Diameter of Cairn.....m. Name Plate ~~found~~/not ~~found~~/placed.

Length of Mast.....m. (approximate if not unplied)

4. ~~BRASS TOE PLATE~~ set in ~~conc~~/rock has been ~~placed~~/found, bearing  $163^\circ$  M from ~~standpoint~~/Pillar

5. ~~G.I. PIPE~~ set in ~~conc~~/rock has been placed/~~found~~, bearing  $180^\circ$  M from ~~standpoint~~/Pillar

6. ~~G.I. PIPE~~ set in ~~conc~~/rock has been placed/~~found~~, bearing  $220^\circ$  M from ~~standpoint~~/Pillar

7. A..... set in ~~conc~~/rock has been placed/~~found~~, bearing..... M from Mast/~~standpoint~~/Pillar

8. Action required:.....

Mark	Direction	Horiz. Distance	Height Difference	Mark	Direction	Horiz. Distance	Height Difference
HILBRANCH (G.S.P.)	0 00 00		above standpoint	HILBRANCH (G.S.P.)	0 00 00		above standpoint
CLARINDA (G.S.P.)	32 14 10		above standpoint	CLARINDA (G.S.P.)	32 14 20		above standpoint
BRASS TOE PLATE	161 28 40	3.409	1.615	G.I. PIPE	287 37 20	4.318	1.605
G.I. PIPE	237 22 26	3.509	-1.563	CONC. OBE. PILLAR	341 27 10	3.469	1.615
			above standpoint				above standpoint
			below				below
			above standpoint				above standpoint
			below				below
			above standpoint				above standpoint
			below				below

STANDPOINT: CONCRETE OBEYING PILLAR

STANDPOINT: BRASS TOE PLATE

Prepared by: P. BERTS, 28th MARCH 1960


Checked:.....

SI 2733-1

STATION: MUDAIN GABLE (G.S.P.) No: 6565

MAP SHEET SCALE 1:250 000 INSPECTED BY: P. BERTS DATE: 25-3-80

AUTHORITY: C.M.A. FIELD BOOK: 1688

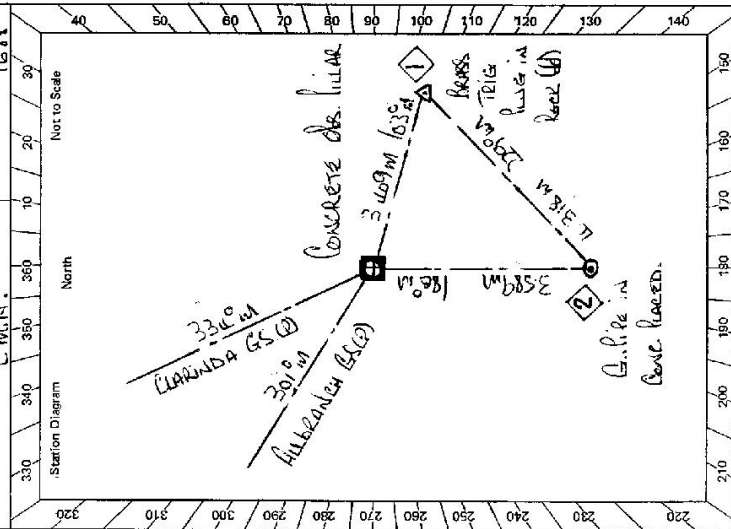

Checked

GS 2

STATION MUNICIPALITY GS 2 TS 6565


Owner's Name: M.R. P. S. S. Current Occupant: .....

Address: Ref to Access 760 KM Address: .....

Phone: 677-393 6066 677-528 office Phone: .....

ACCESS

Access Report of 28/11/19 was found suitable/unavailable.

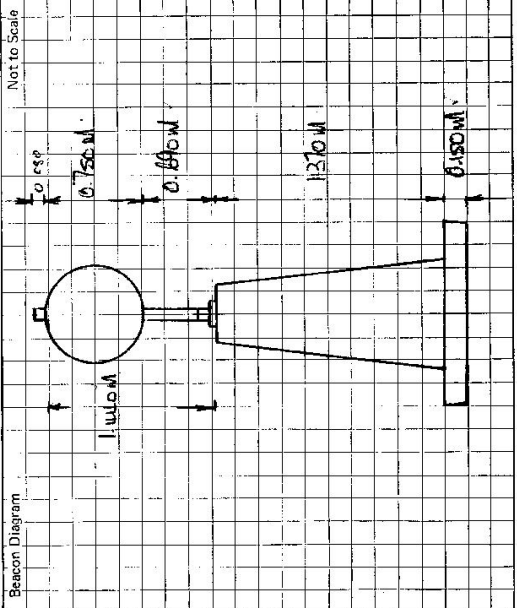

This section to be completed by officer constructing pillar.

Original station mark found/~~unavailable~~

Description of mark: 60x30cm Tile Rule

Original beacon found/~~unavailable~~

Description of beacon: Caib box x Disc

Height Top of Vanas to Top Mark: 2.175 m.

Height of mark: 0.065 m above rock/~~below~~ 0.015 m. below G.L.

Diameter of Vanas: 0.910 m. Height of Cairn: 0.70 m.

Original Beacon has ~~been~~ been destroyed by me.

Date	Record of Station