

GEODETTIC SURVEY OF N.S.W.

CENTRAL MAPPING AUTHORITY

GEODETTIC STATION RECONNAISSANCE and MAINTENANCE REPORT

- Description:
- Note: Cross out word or words which do not apply
- Cleared by lanes bearing..... from Trig. Mast
 - Mast & Vanes have been painted white & black respectively.
 - The station/pillar was unpiled/not unpiled/constructed on..... 19....., dimensions now being:
Description of mark.....should be explicit, e.g., S/Steel Pillar Plate, Steel plug, Brass plug, Bolt, G.I. Pipe
Height of mark.....m. ^{above} rock/concrete; Mark is.....m. ^{above} G.L.
Height of Top Vanes to Top Mark/Pillar platem. Diameter of Vanes (vertical).....m.
Height of Cairn.....m. Diameter of Cairn.....m. Name Plate found/not found/placed.
Length of Mast.....m. (approximate if not unpiled)
 - A.....set in conc/rock has been placed/found, bearing.....° M from Mast/Plug/Pillar
 - A.....set in conc/rock has been placed/found, bearing.....° M from Mast/Plug/Pillar
 - A.....set in conc/rock has been placed/found, bearing.....° M from Mast/Plug/Pillar
 - A.....set in conc/rock has been placed/found, bearing.....° M from Mast/Plug/Pillar
 - Action required:.....

STANDPOINT:

Mark	Direction	Horiz. Distance	Height Difference	Mark	Direction	Horiz. Distance	Height Difference
			above standpt				above standpt
			below				below
			above standpt				above standpt
			below				below
Prepared by: *[Signature]* 30/1/60. Checked: *[Signature]* Noted on U.T.M. Card

SI 2733-1

STATION: **BLACK CAMP** No.: **6586**
 MAP SHEET SCALE 1:250 000 **WARWICK**
 INSPECTED BY: **M. Morrison** DATE: **14/1/60**
 AUTHORITY: **C.M.A.** FIELD BOOK: **1799**

Station Diagram

North

Not to Scale

TRIG STATION IN GOOD ORDER
 VERY OVERGROWN WITH VINES ETC.
 APT 1 WEEK TO CLEAR VINES ETC
 + UNDERGROWTH
 CONCRETE PILLAR POSSIBLE

NO OTHER MARKS LOCATED FOR
 TO LOCATE
 Copper Nail in conc 320m 4.00m
 G.I. Pipe in conc. 232m 3.20m

Checked


STATION **BLACK CAMP (P) 6586**

Owner's Name: **FORESTRY COMMISSION**
 Address:
 Phone:
 Current Occupant:
 Address:
 Phone:

ACCESS

Access Report of 12/8/1980 was found suitable/unsuitable.

- W/M**
- 0.00 MALLANGANEE P.O. HEADING TOWARDS CASINO
 - 0.10 TURN LEFT
 - 0.60 TURN RIGHT BRUXNER HWY.
 - 2.80 MALLANGANEE TICK GATE
 - 3.00 TURN LEFT ON TO CAMBRIDGE PLATEAU RD.
 - 15.00 SIX GRIDS AT 3.10, 5.70, 6.30, 7.10, 9.20, 13.50
 - 15.80 CAMBRIDGE PLATEAU PICNIC AREA ON RIGHT
 - 18.80 TURN LEFT SIGN "MT. TRINNEY RD"
 - 19.20 TURN LEFT TOP OF RIDGE
 - 19.40 TURN LEFT FOLLOW BLAZED TRACK
 - 19.40 BLACK CAMP G.S.

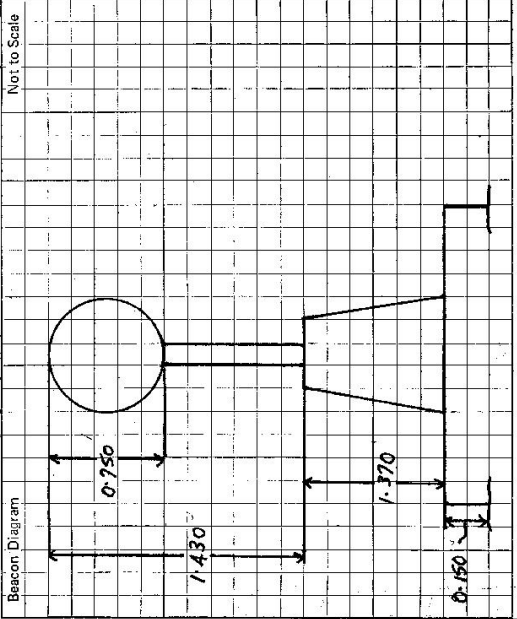

This section to be completed by officer constructing pillar.

Original station mark found/~~not found~~.
 Description of mark: **CARTRIDGE CASE**
 Original beacon found/~~not found~~.
 Description of beacon: **CAIRN MAST & VANES**
 Height Top of Vanes to Top Mark: **3.300** m.
 Height of mark: **0.200** m. above rock/case. **3.50** m. above G.L. below
 Diameter of Vanes: **1.015** m. Height of Cairn: **1.000** m.
 Original Beacon has/~~has not~~ been destroyed by me.

Date	Record of Station