

7491

Department of Lands

RECONNAISSANCE and MAINTENANCE REPORT

STATION KELLY T.S. 6588

Co: Dunblair Ph: Clive
 Map Sheet: Clive (N) No: 9239
 Inspected by: DAVID J. KAIN Date: 7th June 1975
 Authority: Field Book: O1328

Note: Cross out word or words which do not apply


This Trig. Station has been:-

1. Completely cleared to permit 360° vision to surrounding Trigs. ✓
 Note: Station is cleared for 360° vision EXTERNAL SIX SHADE TREES ATOP OF HILL.
2. Cleared by fence-bearing ~~from Trig. Mast~~

3. Trig. Mast & Vanes have been painted white & black respectively. ✓
4. The Trig. was unpiled/~~not unpiled~~, dimensions now being:
 Description of mark CONCRETE ~~base~~ should be explicit, e.g. Steel plug, Brass plug, Bolt, G.I. Pipe
 Height of mark 0.005 m ^{plastic} above ~~below~~ rock/concrete At m ~~above~~ ^{below} G.L.
 Height of Top Vanes to Top Mark 3.340 m. Diameter of Vanes (vertical) 0.010 m.
 Height of Cairn 0.080 m. Diameter of Cairn 1.650 m.
 Length of Mast 3.445 m. (approximate if not unpiled)
5. A CONCRETE set in conc/~~soil~~ has been placed 3.341 m. bearing 332 ^{plug} from Trig. Mast
6. A G.I. PIPE set in conc/~~soil~~ has been placed 2.726 m. bearing 88 ^{plug} from Trig. Mast
7. A set in conc/~~soil~~ has been placed m. bearing from Trig. Mast
8. A set in conc/~~soil~~ has been placed m. bearing from Trig. Mast
9. Connection CONCRETE to G.I. PIPE: 5.000 m. bearing 122 ^{plug}
10. Connection to: m. bearing
11. Connection to: m. bearing
12. Connection to: m. bearing
13. Diff. Ht. is m. ^{above} ~~below~~
14. Diff. Ht. is m. ^{above} ~~below~~
15. Diff. Ht. is m. ^{above} ~~below~~
16. Diff. Ht. is m. ^{above} ~~below~~

Prepared by: A. Nally Checked: Noted on U.T.M. Card A. Nally

Beacon Diagram

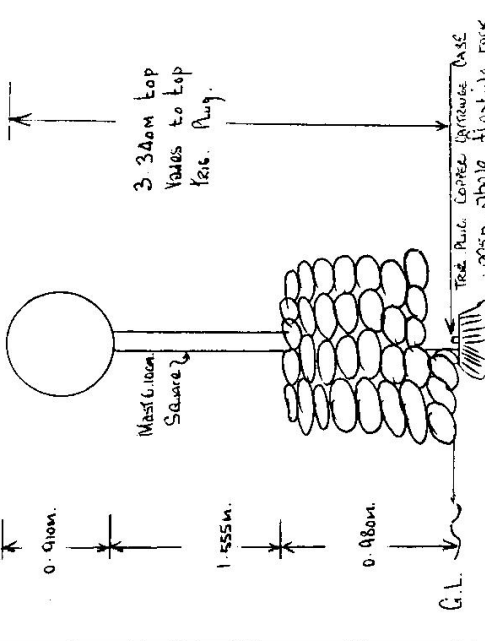

Note: A New Horizontal Trig Mast HAS ASSEMBLED AT Ground Level. VANES AND PLUGS OVER TRIG. PLUG. TRIG. NOME STAMPED INTO VANES, ↑ CUT INTO WASTE.

Date	Record of Station

TS 6588

GEODETTIC SURVEY OF N.S.V.

CENTRAL MAPPING AUTHORITY

STATION: *KELLY* No.: *267A*
 MAP SHEET SCALE 1:250 000
 INSPECTED BY: *G. DICKSON* DATE: *7/11 NOV 1979*
 AUTHORITY: *C.M.A.* FIELD BOOK: *1804*

Station Diagram
 DANGER CONTAMINATED
 PERMISSION TO CLEAN & PILLAR
 Not to Scale

GEODETTIC STATION RECONNAISSANCE and MAINTENANCE REPORT

Description:
 Note: Cross out word or words which do not apply

- Cleared by lances bearing $0^\circ - 360^\circ$ from Trig. Mast
- Mast & Vanes have been painted white & black respectively.
- The station/pillar was supplied/not unpiled/erected on $1\frac{1}{2}$ Masts/legs, 19.79, dimensions now being: Description of mark should be explicit, e.g., S/Steel Pillar Plate, Steel plug, Brass plug, Bolt, G.I. Pipe

Description of mark should be explicit, e.g., S/Steel Pillar Plate, Steel plug, Brass plug, Bolt, G.I. Pipe

Height of mark 0.915 m. above rock/concrete; Mark is 0.915 m. above G.L.

Height of Top Vanes to Top Mark/Pillar plate 0.915 m. Diameter of Vanes (vertical) 0.915 m.

Height of Cairn 0.915 m. Diameter of Cairn 0.915 m. Name Plate found/not found/erected.

Length of Mast 3.24 m. (approximate if not unpiled)

- A 3.24 m. set in conc/rock has been placed/erected/removed 2.70 m from Mast/Pillar/Pillar
- A 3.24 m. set in conc/rock has been placed/erected/removed 3.24 m from Mast/Pillar/Pillar
- A 3.24 m. set in conc/rock has been placed/erected/removed 3.24 m from Mast/Pillar/Pillar
Action required: STATION 3.24 m. PILLAR 3.24 m. NAME PLATE 3.24 m. FOUND 3.24 m.

STANDPOINT:

Mark	Direction	Horiz. Distance	Height Difference	Mark	Direction	Horiz. Distance	Height Difference
			above standpt.				above standpt.
			below standpt.				below standpt.
			above standpt.				above standpt.
			below standpt.				below standpt.
Prepared by: *J. Kelly* Checked: *G. Dickson*

Noted on U.T.M. Card

St 2733-2 D. Watt, Government Printer

STATION

KELLY IS 6588

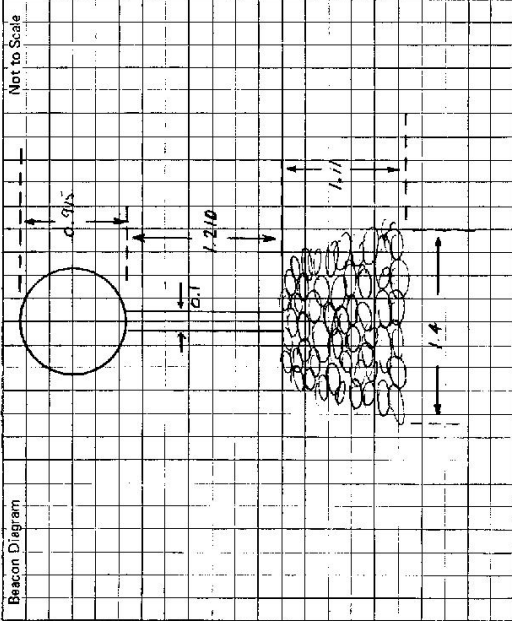

Owner's Name: SANDY WATT
 Address: 'BONDONGA'
 Phone: 5757 6211
 Access Report of 7.6.1975 was found ~~unsuitable~~ unsuitable.
 Features:
 RD TENTEDFIELD ADJACENT TOWARDS SINTHODICE
 TURN LEFT BOWSMAN RD. CROSS RAILWAY LINE.
 PASS 'BACK CREEK RD' ON RIGHT
 PASS 'CUBALSTAR RD' ON LEFT - THIS ROAD LEADS TO OWNERS PROPERTY 'BONDONGA'.
 TURN LEFT OFF HIGHWAY 180' BACK TO GATE
 GATE (SUN ABANDONED). TAKEWAY GATE AND STRAIGHT AHEAD ALLEY
 APPROX WOODS GATE (MILK LARK FENCED 225'M TO GATE)
 TURN RIGHT ON ROSE 23'M TO TAKE 25'M TO WOODS GATE.
 STRAIGHT ON RIGHT
 STAY OF SANDY THICKER.
 FENCE AND TOP OF HILL & ROCK BUMP.
 (PERMISSION GRANTED TO LAY FENCE DOWN).

ACCESS 7-11-1979

PERMISSION TO CLIMB AND PILLAR.

- 41.9
- 43.0
- 42.55
- 42.00
- 42.4
- 43.6
- 43.1

This section to be completed by officer constructing pillar.

Original station mark found/net found.

Description of mark: _____

Original beacon found/~~not found~~.

Description of beacon: Cairn, 6.5' dia

Height Top of Vanes to Top Mark: _____m.

Height of mark: _____m. above G.L. _____m. below G.L.

Diameter of Vanes 0.91 _____m. Height of Cairn 1.11 _____m.

Original Beacon ~~has~~ has not been destroyed by me.

Date

Record of Station

NOTE COULD BE RECCY AFTER EXTENDED RAINS.

GEODETTIC SURVEY OF N.S.W.

CENTRAL MAPPING AUTHORITY

GEODETTIC STATION RECONNAISSANCE and MAINTENANCE REPORT

- Description:
- Note: Cross out word or words which do not apply
- Cleared by lanes bearing..... 3.60..... from Trig. Mast
 - Mast & Vanes have been painted white & black respectively. ✓
 - The station/pillar was ~~erected~~ ^{erected} / ~~not erected~~ / constructed on 2..... 19.30..... dimensions now being: Description of mark/pillar/plate..... should be explicit, e.g., S/Steel Pillar Plate, Steel plug, Brass plug, Bolt, G.I. Pipe
Height of mark..... 3.70..... m. ^{above} ~~below~~ rock/concrete; Mark is..... 5.22..... m. ^{above} ~~below~~ G.L.
Height of Top Vanes to Top Mark/Pillar plate..... 4.35..... m. Diameter of Vanes (vertical)..... 7.55..... m.
Height of Cairn..... m. Diameter of Cairn..... m. Name Plate found/not found/placed.
Length of Mast..... m. (approximate if not unplied)
 - A. Carriage Case set in conc/rock has been placed/removed, bearing..... 1.9..... °M from Mast/Plug/Pillar
 - A. Carriage Case set in conc/rock has been placed/removed, bearing..... 91..... °M from Mast/Plug/Pillar
 - A. Carriage Case set in conc/rock has been placed/removed, bearing..... 3.76..... °M from Mast/Plug/Pillar
 - A..... set in conc/rock has been placed/removed, bearing..... °M from Mast/Plug/Pillar
 - Action required.....


STANDPOINT: CONCRETE PILLAR

Mark	Direction	Horiz. Distance	Height Difference	Mark	Direction	Horiz. Distance	Height Difference
DUMARLESQ GS	359 59 60		above standpt.	DUMARLESQ GS	359 59 60		above standpt.
GIBBALTAR GS	299 12 15		above standpt.	G.I. PILLAR	45 46 30	2.726	0.010 below standpt.
COPPER NAIL	239 11 00	2.703	below standpt.	SAILOR JACK GS	187 30 25		below standpt.
SAILOR JACK GS	197 29 40		above standpt.	COPPER NAIL	295 01 10	3.350	above standpt.
CARRIDGE CASE	169 18 50	3.113	below standpt.	GIBBALTAR GS	274 13 40		above standpt.
G.I. PILLAR	111 25 35	2.005	below standpt.	KIELLY PILLAR	344 17 15	3.118	below standpt.

STANDPOINT: CARRIDGE CASE

Mark	Direction	Horiz. Distance	Height Difference
G.I. PILLAR	45 46 30	2.726	0.010 below standpt.
SAILOR JACK GS	187 30 25		below standpt.
COPPER NAIL	295 01 10	3.350	above standpt.
GIBBALTAR GS	274 13 40		above standpt.
KIELLY PILLAR	344 17 15	3.118	below standpt.

Prepared by: [Signature] Checked: [Signature] Noted on U.T.M. Card

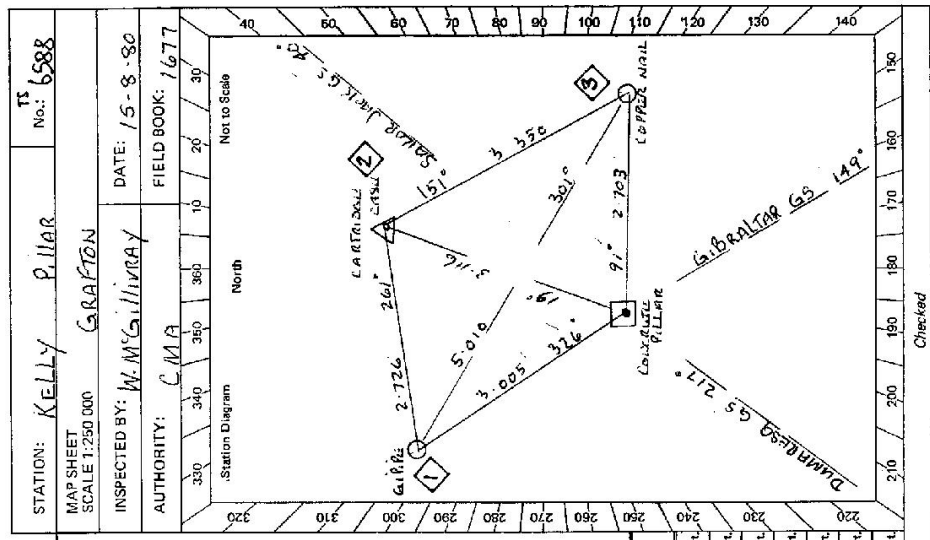

STATION: KELLY PILLAR No.: 6588

MAP SHEET SCALE 1:250 000

INSPECTED BY: W.M. GILLIBRAY

AUTHORITY: CMA


DATE: 15-8-80

FIELD BOOK: 1677

Checked

SI 2733-2 D. West, Government Printer

Beacon Diagram

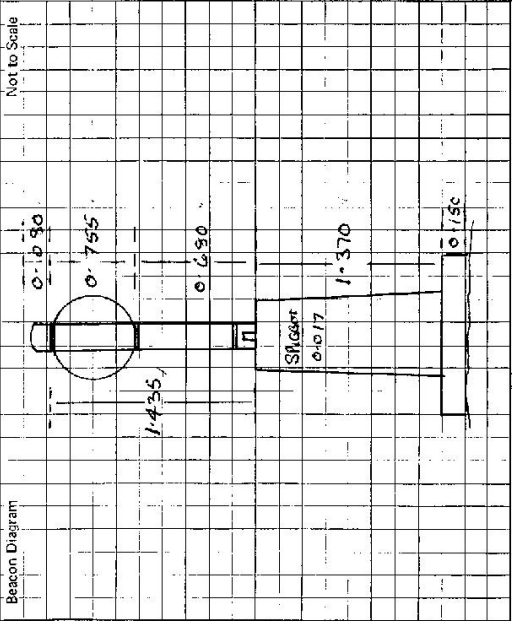

This section to be completed by officer constructing pillar.

Original station mark found/~~not found~~.

Description of mark: ~~SAFETY SIGN~~ ~~IN CORNER~~

Original beacon found/~~not found~~.

Description of beacon: ~~BLACK~~ ~~WOODEN~~ ~~POST~~ ~~WITH~~ ~~GLASS~~

Height Top of Vanes to Top Mark: ~~3.360~~ m.

Height of mark ~~4.4~~ m. above below G.L.

Diameter of Vanes: ~~0.170~~ m. Height of Cairn: ~~1.30~~ m.

Original Beacon has ~~not~~ been destroyed by me.

STATION Kelly Pillar IS 6588

Owner's Name: SANDY WATT
 Address: BONDRONGA
MOLE RIVER
 Phone: 3757 2 x 14 L

Current Occupant:
 Address:
 Phone:

ACCESS

Access Report of 1.11.1973 was found suitable/~~unsuitable~~.

- 0.0 POST OFFICE TENTERFIELD, PROCEED TOWARD STANTHORPE.
- 5.3 TURN LEFT ONTO BONSHAW RD CROSS RAILWAY.
- 35.75 PASS GIBRALTAR ROAD ON LEFT.
- 41.9 TURN SHARP LEFT OF H/WAY 180° TO GATE.
- 42.0 GATE. GO THROUGH AND GO STRAIGHT AHEAD
- 42.35 WOODEN GATE. "CHINA LOCK" FOLLOW FAINT TRACK
- 43.4 STEEP GULLY ON RIGHT.
- 44.1 FENCE. THIS FENCE CAN BE LAID DOWN 50M DOWN TO RIGHT FROM CORNER POST

Date

Record of Station