

CENTRAL MAPPING AUTHORITY

GEODETTIC SURVEY OF N.S.W.

GEODETTIC STATION RECONNAISSANCE and MAINTENANCE REPORT

Description:

1. Cleared by ~~James bearing~~ completely ~~timbered~~ 360° from Trig. Mast
 Note: Cross out word or words which do not apply

2. Mast & Vanes have been painted white & black respectively.

3. The station/pillar was unpiled/not unpiled/constructed on..... 19....., dimensions now being:

Description of mark..... should be explicit, e.g., S/Steel Pillar Plate, Steel plug, Brass plug, Bolt, G.I. Pipe

Height of mark.....m. ^{above} rock/concrete; Mark is.....m. ^{above} G.L.

Height of Top Vanes to Top Mark/Pillar plate.....m. Diameter of Vanes (vertical).....m.

Height of Cairn.....m. Diameter of Cairn.....m. Name Plate found/not found/placed.

Length of Mast.....m. (approximate if not unpiled)

4. A..... set in conc/rock has been placed/found, bearing.....°M from Mast/Plug/Pillar

5. A..... set in conc/rock has been placed/found, bearing.....°M from Mast/Plug/Pillar

6. A..... set in conc/rock has been placed/found, bearing.....°M from Mast/Plug/Pillar

7. A..... set in conc/rock has been placed/found, bearing.....°M from Mast/Plug/Pillar

8. Action required: Met 2-3 days clearing.

STANDPOINT:

STANDPOINT:

Mark	Direction	Horiz. Distance	Height Difference	Mark	Direction	Horiz. Distance	Height Difference
			above standpt.				above standpt.
			below standpt.				below standpt.
			above standpt.				above standpt.
			below standpt.				below standpt.
Prepared by: Stt.

Checked:

Noted on U.T.M. Card

SI 2733-1

STATION: PRENTICE	No. TS6591
MAP SHEET SCALE 1:250 000	WAGWICK
INSPECTED BY: A. Silverstein	DATE: 25-1-1978
AUTHORITY: CMA	FIELD BOOK: 1622

Station Diagram

No mark found, no witness marks found.

Heavy rain and mist - apart from Sugarloaf and South Obelisk, no other As seen.

1-2 days clearing.

+

Top of hill consists of large boulders.

STATION		PRENTICE TS 6591	
Owner's Name: A.D. Robertson		Current Occupant:	
Address: 18 WIRINYA ST		Address:	
Phone:		Phone:	
ACCESS 25-1-1978			
Access Report of 16/12/1978 was found suitable/unusable.			
<p>km</p> <p>0.0 Tenterfield P.O., head north</p> <p>1.2 Turn right onto Mt Lindsay Hwy.</p> <p>5.85 Pass "Summerlands Rd" on Right.</p> <p>8.9 Bridge over Washbox Creek.</p> <p>11.1 Washpool Creek</p> <p>14.5 Spring Creek</p> <p>15.7 Pass "MURDOCH" Sign (Turnoff to Resurrection A)</p> <p>19.75 Swamp Creek</p> <p>22.45 Resurrection Creek</p> <p>23.05 Turnoff to "Boonoo Boonoo Falls" on RHS-pass 35.65</p> <p>23.6 Boonoo Boonoo River</p> <p>27.6 Bridge</p> <p>28.7 Pass turnoff to "Bald Rock National Park" on left.</p> <p>35.65 Turn left just after earth causeway and go to left of blaze on she-oak. Follow wheel tracks</p> <p>36.6 Edge of swamp. Trig due north (approx) on L.H. ridge. 15 minutes easy walk.</p>			
Date		Record of Station	
Beacon Diagram			
Not to Scale			
Mast and vanes found destroyed on ground.			
This section to be completed by officer constructing pillar.			
Original station mark found/not found.			
Description of mark:			
Original beacon found/not found.			
Description of beacon:			
Height Top of Vanes to Top Mark:m.			
Height of mark:m. above G.L. below			
Diameter of Vanesm. Height of Calmm.			
Original Beacon has/has not been destroyed by me.			

CENTRAL MAPPING AUTHORITY

GEODETTIC SURVEY OF N.S.M.

GEODETTIC STATION RECONNAISSANCE and MAINTENANCE REPORT

STATION: PRENTICE (P)	TS No.: 6591
MAP SHEET SCALE 1:250 000 WARWICK	
INSPECTED BY: G. L. FORD	DATE: 7-8-80
AUTHORITY: C. M. A.	FIELD BOOK: 1682

Description:

1. Cleared by lanes bearing **360°**.
Note: Cross out word or words which do not apply

2. Mast & Vanes have been painted white & black respectively. ✓

3. The station/pillar was ~~unretrieved~~ constructed on **6-8-1980**, dimensions now being:
 Description of mark **PILLAR PLATE** should be explicit, e.g., **Steel plate, cross plug, Bolt, G.I. Pipe**
 Height of mark **1.718** m. ^{above} ~~below~~ **rock/concrete**; Mark is **1.928** m. ^{above} ~~below~~ **G.L.**
 Height of Top Vanes to Top **Mast**/Pillar plate **1.450** m. Diameter of Vanes (vertical) **0.750** m.
 Height of Cairn **0.450** m. Diameter of Cairn **0.450** m. Name Plate **found/not found**/placed.
 Length of Mast **0.450** m. (approximate if not unplied)

4. A **COPPER NAIL** set in conc/rock has been placed/**found**, bearing **317°** M from **Mast/Plug/Pillar**

5. A **G.I. PIPE** set in conc/rock has been placed/**found**, bearing **239°** M from **Mast/Plug/Pillar**

6. A set in conc/rock has been placed/**found**, bearing **0°** M from **Mast/Plug/Pillar**

7. A set in conc/rock has been placed/**found**, bearing **0°** M from **Mast/Plug/Pillar**

8. Action required:

STANDPOINT: ROOF TOP PILLAR

Mark	Direction	Horiz. Distance	Height Difference
TIMBARRA G.S.	0 00 00		above standpt.
G.I. PIPE	57 33 40	3.037	2.103 below standpt.
BALD ROCK	67 44 50		above standpt.
COPPER NAIL	134 02 20	1.942	1.971 below standpt.
SUGAR LOAF	156 05 40		above standpt.
BOOROOK	269 56 20		above standpt.


STANDPOINT: COPPER NAIL

Mark	Direction	Horiz. Distance	Height Difference
TIMBARRA G.S.	0 00 00		above standpt.
G.I. PIPE	21 22 40	3.200	0.233 below standpt.
BALD ROCK	67 44 20		above standpt.
SUGAR LOAF	156 05 50		above standpt.
BOOROOK	269 56 30		above standpt.
STEEL PILLAR	314 01 20	1.945	1.973 below standpt.

Prepared by: **G. Ford**

Checked: _____

Noted on U.T.M. Card

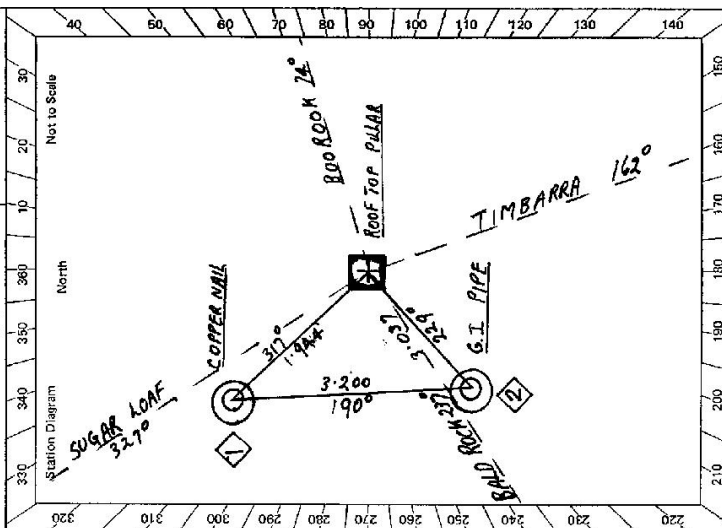

Checked

