

CENTRAL MAPPING AUTHORITY

GEODETIC SURVEY OF N.S.W.

GEODETIC STATION RECONNAISSANCE and MAINTENANCE REPORT

Description:

1. Cleared by lanes bearing.....
 Note: Cross out word or words which do not apply
 from Trig, Mast

2. Mast & Vanes have been painted white & black respectively.

3. The station/pillar was unpiled/not unpiled/constructed on..... 19....., dimensions now being:

Description of mark.....should be explicit, e.g., S/Steel Pillar Plate, Steel plug, Brass plug, Bolt, G.I. Pipe

Height of mark.....m. ^{above} rock/concrete; Mark is.....m. ^{above} G.L. _{below}

Height of Top Vanes to Top Mark/Pillar platem. Diameter of Vanes (vertical).....m.

Height of Cairn.....m. Diameter of Cairn.....m. Name Plate found/not found/placed.

Length of Mastm. (approximate if not unpiled)

4. A.....set in conc/rock has been placed/found, bearing.....° M from Mast/Plug/Pillar

5. A.....set in conc/rock has been placed/found, bearing.....° M from Mast/Plug/Pillar

6. A.....set in conc/rock has been placed/found, bearing.....° M from Mast/Plug/Pillar

7. A.....set in conc/rock has been placed/found, bearing.....° M from Mast/Plug/Pillar

8. Action required: REPAIR AND NEW MAST NEAR TRIG PLUG STANDPOINT: R112 577m in conc for


Mark	Direction	Horiz. Distance	Height Difference	Mark	Direction	Horiz. Distance	Height Difference
			<small>above standpt. below standpt.</small>				<small>above standpt. below standpt.</small>
MARQUELO G.S.	0 00 00 ✓		above standpt.	MARQUELO G.S.	0 00 00 ✓		above standpt.
FEAGAN G.S.	22 09 35 ✓		above standpt.	FEAGAN G.S.	22 08 55 ✓		above standpt.
R112	72 30 15 / 13 700 / 0.126		below standpt.	TRIG PLUG	259 32 25 / 3.710 / 0.126		above standpt.
			below standpt.				below standpt.
			above standpt.				above standpt.
			below standpt.				below standpt.
			above standpt.				above standpt.
			below standpt.				below standpt.

Prepared by: [Signature]

Checked: [Signature] Noted on U.T.M. Card

SI 2783-1

STATION: Faunce G.S. No: 2037
 MAP SHEET SCALE 1:250 000
 INSPECTED BY: G Dickson DATE: 30/6/20
 AUTHORITY: C.M.A. FIELD BOOK: 1785

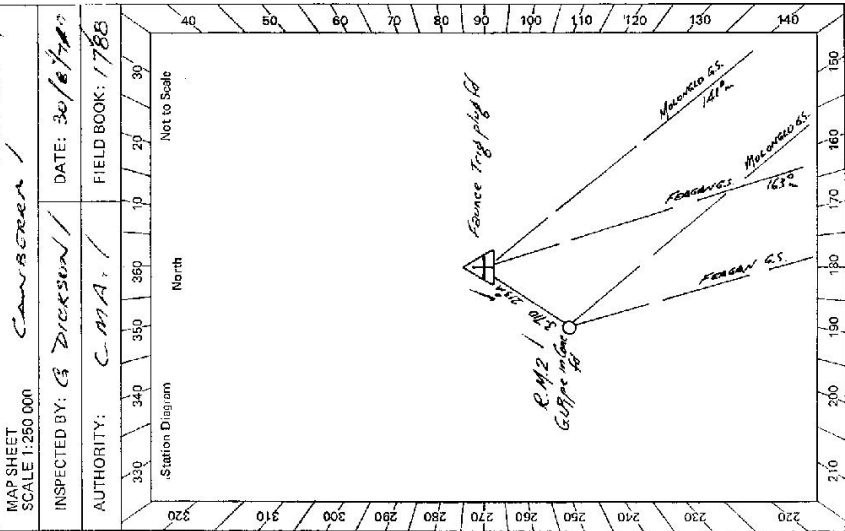

TS-6595

No.: 2037


GEODETTIC SURVEY OF N.S.W. **CENTRAL MAPPING AUTHORITY** **GEODETTIC STATION RECONNAISSANCE and MAINTENANCE REPORT**

STATION: **FAUNCE G.S.**

MAP SHEET SCALE 1:250 000 **CANBERRA**

INSPECTED BY: **R. LAUNDER** DATE: **12-4-80**

AUTHORITY: **C.M.A.** FIELD BOOK: **88 1861**

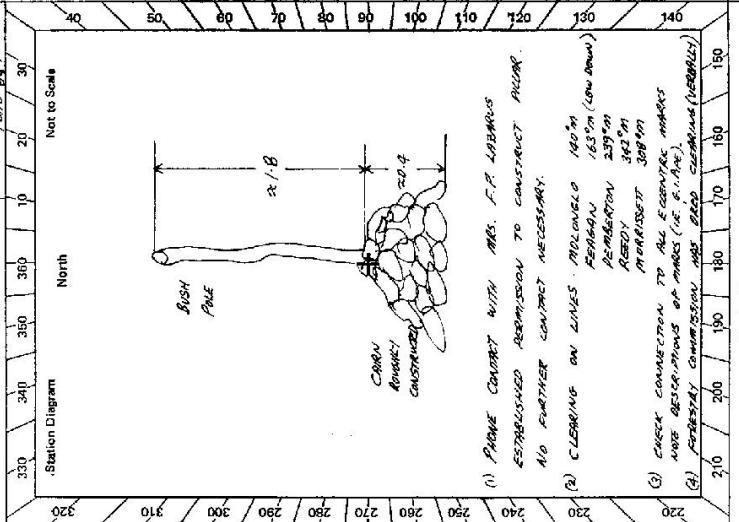

- (1) PHONE CONTACT WITH MRS. F.A. LABARUS ESTABLISHED PERMISSION TO CONSTRUCT PILLAR. NO FURTHER CONTACT NECESSARY.
- (2) CLEARING ON LINES MIDLANDS 1407M PERABIAN 1637M (LOW DOWN) PERABIAN 2397M ALBANY 2427M MERRIDIST 3087M
- (3) CHECK CONNECTION TO ALL EXISTING MARKS HAVE DESIGNATIONS OF MARKS (i.e. G.I.P.E.).
- (4) PRESENTLY PERMISSION HAS BEEN OBTAINED (VERBALLY)

- Description:
- Note: Cross out word or words which do not apply*
1. Cleared by lanes bearing..... **135° M, 143° M, 156° M, 165° M, 221° M, 229° M, 237° M, 245° M** from Trig. Mast
 2. Mast & Vanes have been painted white & black respectively. **REMOVED**
 3. The station/pillar was unplaced/not unplaced/constructed on..... **19**..... dimensions now being:
Description of mark..... should be explicit, e.g., S/Steel Pillar Plate, Steel plug, Brass plug, Bolt, G.I. Pipe
Height of mark..... ^{above} _{below} rock/concrete; Mark is..... ^{above} _{below} G.L.
 - Height of Top Vanes to Top Mark/Pillar plate..... **0.1**.....m. Diameter of Vanes (vertical).....m.
 - Height of Cairn..... **0.1**.....m. Diameter of Cairn.....m. Name Plate found/not found/placed.
 - Length of Mast **1.8**.....m. (approximate if not unplaced)
 4. **A. 6.1.1. (Pillar)** set in conc/rock has been placed/removed/lost, bearing..... **215**.....° M from Mast/Plug/Pillar
 5. **A. 5.7.2. (Pillar)** set in conc/rock has been placed/removed/lost, bearing..... **82**.....° M from Mast/Plug/Pillar
 6. **A. 5.7.3. (Pillar)** set in conc/rock has been placed/removed/lost, bearing..... **320**.....° M from Mast/Plug/Pillar
 7. **A. 5.7.4. (Pillar)** set in conc/rock has been placed/removed/lost, bearing..... **210**.....° M from Mast/Plug/Pillar
 8. Action required: **PILLAR CONSTRUCTION. PILLAR TO BE SET AT 210° AS SHOWN.**

STANDPOINT:

Mark	Direction	Horiz. Distance	Height Difference	Mark	Direction	Horiz. Distance	Height Difference
			above standpt				below
			below standpt				above
			above standpt				below
			below standpt				above
Prepared by: **R. LAUNDER** Checked: **[Signature]** Noted on U.T.M. Card

RES FOR TONG CAMPION
2021/05/31

6: 2733-2 D. West, Government Printer

Beacon Diagram	Not to Scale	STATION	FRANCE	G.S.	TS 6595
<p>Current Occupant:</p> <p>Address:</p> <p>Phone:</p>					
<p>ACCESS</p> <p>Access Report of 12.1.18: 1180 was found suitable/unsuitable, 3.95 ST. GEORGE'S ROAD WEST WARD. ROAD IN AREA</p>					
0.00		0.00	GO STRAIGHT AHEAD, KEEP UNDER POWER LINES		
0.50		4.60	TURN LEFT AT BUAL POWER PILES.		
0.95		4.65	CROSS UNDER POWER LINES, THEN TURN LEFT.		
1.50		5.00	GO THROUGH MAIN GATE.		
1.70		5.40	KEEP LEFT		
1.75		5.45	KEEP RIGHT		
1.85		5.55	KEEP LEFT		
2.20		5.65	BYPASS OLD SHED ON RIGHT		
2.25		5.70	GO THROUGH LINE AT FURNITURE JOB AFTER CORNER		
3.40		5.80	KEEP LEFT OFF MAIN TRACK		
3.60		6.05	BYPASS LOG ON RIGHT KEEP TO TRACK MARKING		
3.65		6.45	UPHILL. STAY ON THIS TRACK		
		6.55	GO THROUGH OLD WIRE GATE.		
		8.45	CROSS UNDER POWER LINE		
			STOP AT TAG ON LEFT OF TRACK.		
Record of Station					
Date					
Description of mark:					
Original station mark found/not found.					
Description of beacon:					
Original beacon found/not found.					
Height Top of Vanes to Top Mark:m,					
Height of mark:m, above G.L.					
below					
Diameter of Vanesm, Height of Cairnm.					
Original Beacon has/has not been destroyed by me.					

CENTRAL MAPPING AUTHORITY

GEODETIC STATION RECONNAISSANCE and MAINTENANCE REPORT


GEODETIC SURVEY OF N.S.W.

STATION: FAUNCE (P) TS NO.: 6595

MAP SHEET SCALE 1:250 000

INSPECTED BY: H.C. BORDER DATE: 15-1-80

AUTHORITY: C.M.A. FIELD BOOK: 1678

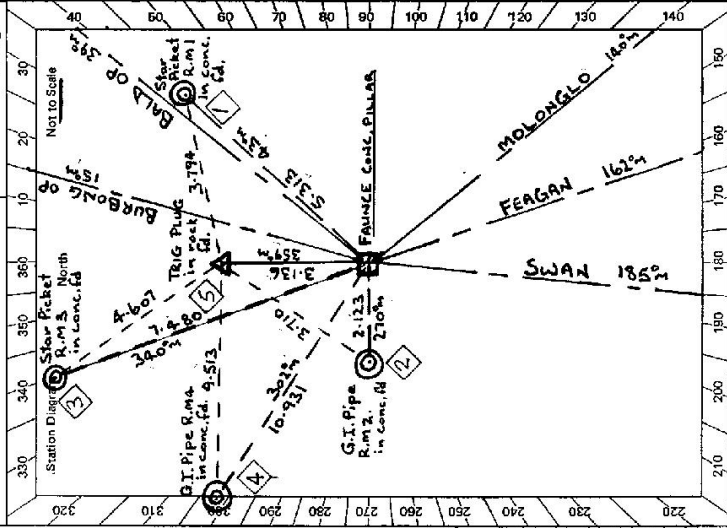

- Description:
- Cleared by lanes bearing **36.0°** ^m. Note: Cross out word or words which do not apply from ~~Trig Plug~~ **Pillar**.
 - Mast & Vanes have been painted white & black respectively. ✓
 - The ~~station~~ pillar was ~~unplaced/not erected~~/constructed on **12th JULY 1980**, dimensions now being: Description of material **S/Steel Pillar Plate, Steel plug, Brass plug, Bolt, G.I. Pipe**. Height of mark **1.375** m. ^{above} ~~mark~~ **hook/concrete**; Mark is **1.625** m. ^{above} ~~hook~~ **G.L.**. Height of Top Vanes to Top Mark/Pillar plate **1.445** m. Diameter of Vanes (vertical) **0.755** m. Height of ~~Coin~~ **1.525** m. Diameter of ~~Coin~~ **R.I.**. Name Plate ~~found/not found~~/placed. Length of Mast **1.525** m. (approximate if not unplaced)
 - A **Bronze Trig Plug** set in ~~conc/rock~~ has been ~~placed~~/found, bearing **359** °M from ~~Monolith~~/Pillar
 - A **Star Picket R.M. 1** set in ~~conc/rock~~ has been ~~placed~~/found, bearing **43** °M from ~~Monolith~~/Pillar
 - A **G.I. Pipe R.M. 2** set in ~~conc/rock~~ has been ~~placed~~/found, bearing **270** °M from ~~Monolith~~/Pillar
 - A **G.I. Pipe R.M. 4** set in ~~conc/rock~~ has been ~~placed~~/found, bearing **302** °M from ~~Monolith~~/Pillar
 - A **Star Picket R.M. 3** set in ~~conc~~ has been ~~found~~, bearing **340** °M from ~~Monolith~~/Pillar
 - Action required **Place Name Plate**.

STANDPOINT: Conc. PILLAR			STANDPOINT: TRIG PLUG		
Mark	Direction	Horiz. Distance	Mark	Direction	Horiz. Distance
FEAGAN	359 59 60		FEAGAN	359 59 60	above standpt.
STAR PICKET R.M. 1	22 21 50		CONC. PILLAR	15 26 50	above standpt.
G.I. PIPE R.M. 2	107 59 20	2.123	STAR PICKET R.M. 3	72 27 00	above standpt.
G.I. PIPE R.M. 4	139 59 00	10.931	G.I. PIPE R.M. 2	50 21 30	above standpt.
STAR PICKET R.M. 3	177 18 00	7.480	G.I. PIPE R.M. 4	124 13 00	above standpt.
TRIG PLUG	145 28 30	3.136	STAR PICKET R.M. 3	165 02 30	above standpt.
BURBONGLO OP	216 53 10	1.616	BURBONGLO OP	216 53 10	above standpt.
STAR PICKET R.M. 4	240 10 20	5.313	STAR PICKET R.M. 4	215 43 50	above standpt.
			STAR PICKET R.M. 1	275 43 50	below standpt.

Prepared by: H.C. BORDER Checked: Noted on U.T.M. Card

AMENDED (6.1) Brown 13-10-80

Checked

STATION FAUNCE (P) TS-6595 FORESTRY COMMISSION Owner's Name: TS S. BAN RADIG Address: 182 GOYNER ST MARRUBINDI (ACT) Phone: F. LAZARUS (BROTHER IN-LAW) Phone: 062-972425	Current Occupant: SURROUNDING PROPERTY CONTRIBUTE BY L. L. YOD GEORGE LAZARUS 182 GOYNER ST MARRUBINDI (ACT) F. LAZARUS (BROTHER IN-LAW) Phone: 062-972425	TR. BRIG. S. J. SIMPSON S. J. SIMPSON Phone: 7514193 ACCESS	Access Report of 17/1/1988 was found suitable/unavailable. QUEANBEYAN POST OFFICE. Travel towards BRADWOOD, (N.E along MONARO ST). 0.50 ACROSS QUEANBEYAN RIVER (QUEEN'S BRIDGE), towards BRADWOOD 4.60 Turn off to right. CAPTAIN'S FLAT RD. 6.85 Turn off to right. GRAVEL RD. WANNA-WANNA RD. 8.35 Grid 8.60 Grid 9.60 Passing Property "CARINYA on R.H.S 10.00 Wooden Bridge 10.50 Grid 10.55 Turn Right onto dirt track & follow along fence line (Pine forest area) 11.50 Turn Right through GATE. straight ahead. 12.15 Track intersection Turn right (Good track) straight ahead, along ridge. 12.40 Through fence line gate open. 13.10 Through open fence line 14.50 Through GATE L.H.S straight ahead. 15.60 FAUNCE CONC. PILLAR R.H.S of Track.
Beacon Diagram Not to Scale 		This section to be completed by officer constructing pillar. Original station mark found/ not found . Description of mark: Brass Trig Plug in rock Original beacon found/ not found . Description of beacon: Cairn (only) Height Top of Vanes to Top Mark.....m. Height of mark.....m. above G.L. Diameter of Vanes.....m. Height of Cairn 0.500m. Original Beacon has/ has not been destroyed by.....	
		Date Record of Station	


ALSO SEE ACCESS. R. LAMBER 12-4-80

75-103

TS 2057 TS 6595
STATION FAUNCLE PILLAR

Co: MURRAY P/B: CARWoola
Map Sheet: QUEANBEYAN No: 8727
Inspected by: W McGILLIVRAY Date: 6-5-83
Authority: LANDS Field Book:

Beacon Diagram Not to Scale

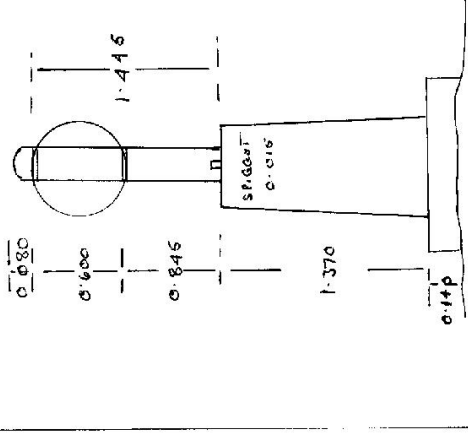

Date: 6-5-83
Record of Station: REPLACE MAST & VANES
Replacement & Vans

Department of Lands
Integration of N.S.W.
RECONNAISSANCE and MAINTENANCE REPORT

Note: Cross out word or words which do not apply

This Trig. Station has been:-

1. Completely cleared to permit 360° vision to surrounding Trigs.
2. Cleared by limes bearing from Trig. Mast
3. Trig. Mast & Vanes have been painted white & black respectively.
4. The Trig. was unpiled/not unpiled, dimensions now being:
 - Description of mark: CONCRETE PILLAR (should be explicit, e.g. Steel plug, Brass plug, Bell, Concrete Pillar)
 - Height of mark: 1.370 m above rock concrete 1.510 m above G.L.
 - Height of Top Vanes to Top Mark/Top pillar plate: 1.445 m Diameter of Vanes (vertical): m.
 - Height of Cairn: m. Diameter of Cairn: m.
 - Length of Mast: 1.525 m. (approximate if not unpiled)
5. A set in conc/rock has been placed/fd m. bearing °M from Trig. Mast/pillar
6. A set in conc/soil has been placed/fd m. bearing °M from Trig. Mast/pillar
7. A set in conc/soil has been placed/fd m. bearing °M from Trig. Mast/pillar
8. A set in conc/rock has been placed/fd m. bearing °M from Trig. Mast/pillar

9. Connection to m. bearing °M
10. Connection to m. bearing °M
11. Connection to m. bearing °M
12. Connection to m. bearing °M
13. Diff. Ht. is m. above/below
14. Diff. Ht. is m. above/below
15. Diff. Ht. is m. above/below
16. Diff. Ht. is m. above/below

Prepared by: _____
Checked: _____


6595
TS 2057 STATION FAUN LE PILLAR

Owners Name Current Occupant

Address Address

Access **6-5-83**

- 0-00 CUMBARJIAN POST OFFICE, TAKE BANGKENDALE RD (KING HWY)
- 4-5 TURN RIGHT CAPTAINS FLAT ROAD.
- 6-7 TURN RIGHT ONTO WIANNA WIANNA ROAD.
- 9-3 CARINYA ON RIGHT.
- 9-8 LOW WOODEN BRIDGE.
- 10-2 TURN RIGHT AT BRID & GATE
- 10-8 LOCKED GATE. "NANGARRA" LANDS GOFT ~~LOCK~~ PLACED
- 11-1 SMALL TIN SHED ON RIGHT.
- 11-7 T JUNCTION GO RIGHT.
- 12-1 FORK GO RIGHT
- 12-4 FENCE LINE
- 13-8 LOCKED GATE. FENCE LAID DOWN.
- 14-1 ROAD JUNCTION GO LEFT.
- 14-9 FAUN LE PILLAR.

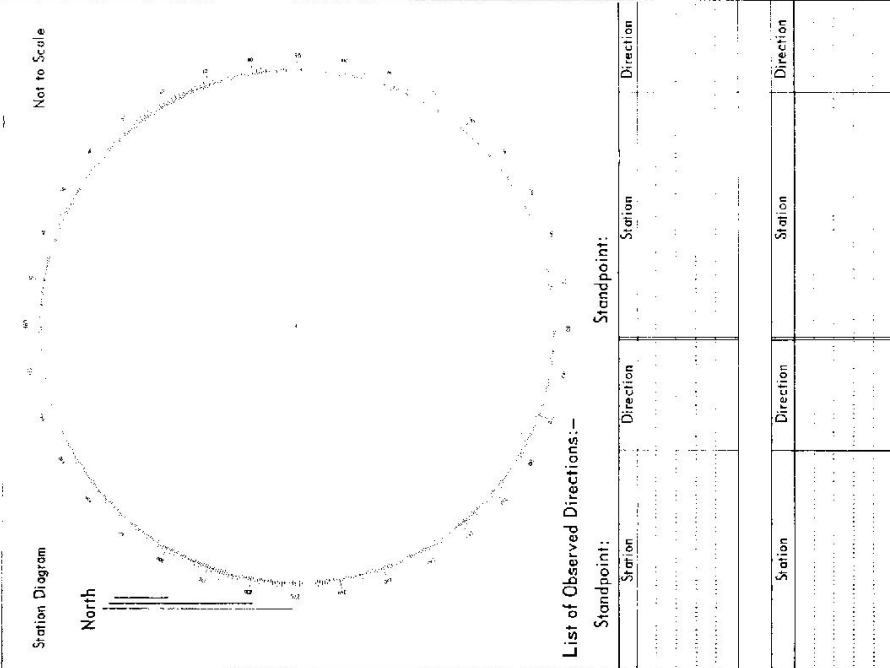

CENTRAL MAPPING AUTHORITY

GEODETIC SURVEY OF N.S.W.

GEODETIC STATION RECONNAISSANCE and MAINTENANCE REPORT

Description:

Note: Cross out word or words which do not apply

1. Cleared by lanes bearing..... from Trig. Mast
2. Mast & Vanes have been painted white & black respectively.
3. The station/pillar was unpiled/not unpiled/constructed on..... 19....., dimensions now being:
Description of mark..... should be explicit, e.g., S/Steel Pillar Plate, Steel plug, Brass plug, Bolt, G.I. Pipe
Height of mark.....m. above rock/concrete; Mark is.....m. above G.L.
Height of Top Vanes to Top Mark/Pillar plate.....m. Diameter of Vanes (vertical).....m.
Height of Cairn.....m. Diameter of Cairn.....m. *C.N. Name Plate found/not found/placed.*
Length of Mast.....m. (approximate if not unpiled)
4. A..... set in conc/rock has been placed/found, bearing.....°M from Mast/Plug/Pillar
5. A..... set in conc/rock has been placed/found, bearing.....°M from Mast/Plug/Pillar
6. A..... set in conc/rock has been placed/found, bearing.....°M from Mast/Plug/Pillar
7. A..... set in conc/rock has been placed/found, bearing.....°M from Mast/Plug/Pillar
8. Action required:.....

STANDPOINT:

Mark	Direction	Horiz. Distance	Height Difference	Mark	Direction	Horiz. Distance	Height Difference
			above standpt. below				above standpt. below
			above standpt. below				above standpt. below
STATION:

MAP SHEET SCALE 1:250 000

INSPECTED BY: P. Roberts


DATE: 10.10.13

AUTHORITY: C.M.A.

FIELD BOOK: 147

STATION: FOUNICE GS (C)

No: 6595

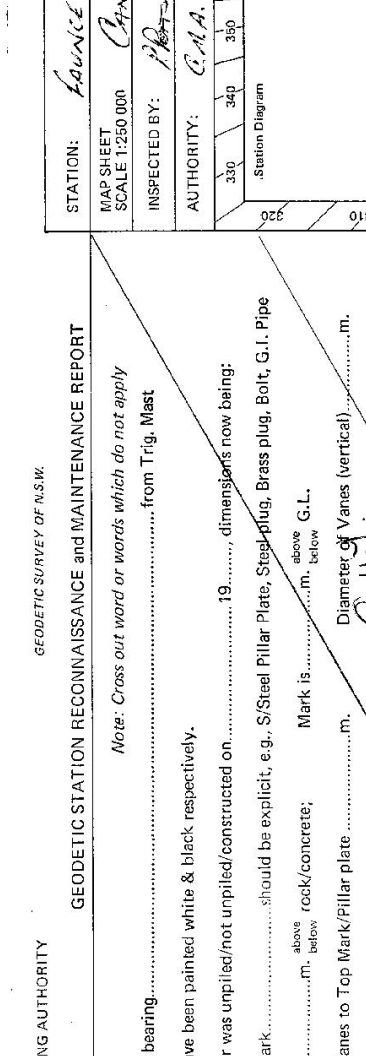


Prepared by: P. Roberts

Checked: P. Roberts

Noted on U.T.M. Card

Checked

SI 2733-2 D. West, Government Printer

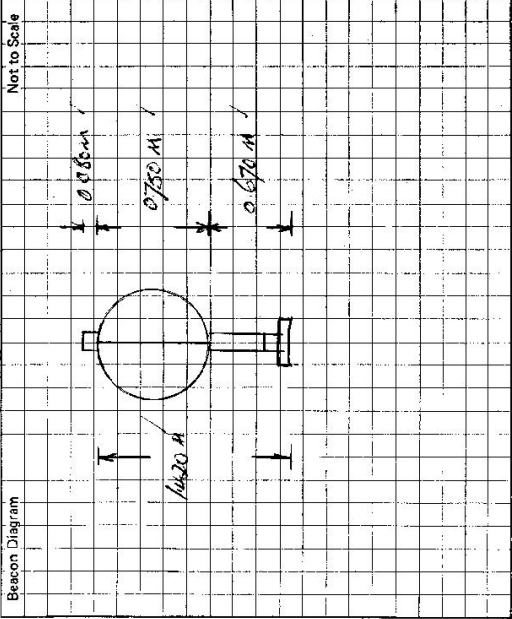

This section to be completed by officer constructing pillar.

Original station mark found/not found.

Description of mark:

Original beacon found/not found.

Description of beacon:

Height Top of Vanes to Top Mark:m.

Height of mark:m. above rock/concm. below G.L.

Diameter of Vanes:m.

Height of Cairn:m.

Original Beacon has/has not been destroyed by me.

STATION

LAUNCE 65 (P) TS 6595

Owner's Name: FORESTRY COMMISSION

Address: RESERVE #116

Phone: SA 7549 0330000

Access Report of 10/10/19 was found suitable/unsuitable.

Current Occupant:

Address:

Phone:

Date

Record of Station