


TS 6602

STATION: WATTMAN G.S. No: 457E

MAPSHEET SCALE 1:250 000

INSPECTED BY: P. CLARR DATE: 26-9-80

AUTHORITY: C.M.A. FIELD BOOK: 1893

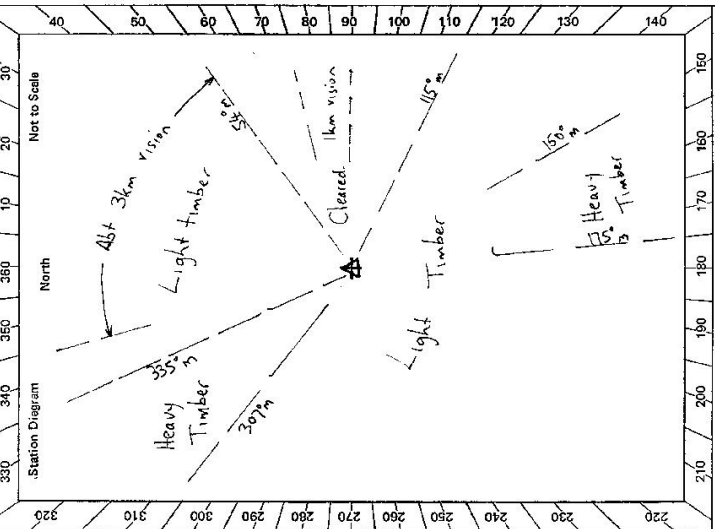

Checked

CENTRAL MAPPING AUTHORITY

GEODETIC STATION RECONNAISSANCE and MAINTENANCE REPORT

Description: Note: Cross out word or words which do not apply

1. Cleared by lanes bearing: See station diagram

2. Mast & Vanes have been painted white & black respectively.

3. The station/pillar was unpiled/not unpiled/constructed on 2.6.9.19.80, dimensions now being:

Description of mark: should be explicit, e.g. S/Steel Pillar Plate, Steel plug, Brass plug, Bolt, G.I. Pipe

Height of mark: above/below rock/concrete; Mark is: above/below G.L.

Height of Top Vanes to Top Mark/Pillar plate: Diameter of Vanes (vertical): m.

Height of Cairn: Diameter of Cairn: m. Name Plate found/not found/placed.

Length of Mast: (approximate if not unpiled)

4. A. Copper: Nil exist (but not searched)

5. A. G.I. Pipe: set in conc/rock has been placed/found/bearing: 2.7.11. M from Mast/Plug/Pillar

6. A. set in conc/rock has been placed/found, bearing: 8. M from Mast/Plug/Pillar

7. A. set in conc/rock has been placed/found, bearing: M from Mast/Plug/Pillar

8. Action required: CONC. PILLAR TO BE CONSTRUCTED (see over for further details)

CLEARING REQUIRED 335 M - 150 M OR 360 IF POSSIBLE. LANE AT 6.0 M ESSENTIAL


STANDPOINT: 115 M - 307 M

Mark	Direction	Horiz. Distance	Height Difference	Mark	Direction	Horiz. Distance	Height Difference
			above standpt.				above standpt.
			below standpt.				below standpt.
			above standpt.				above standpt.
			below standpt.				below standpt.
Noted on U.T.M. Card

Checked: 2/10/80

Prepared by: Keith Walker

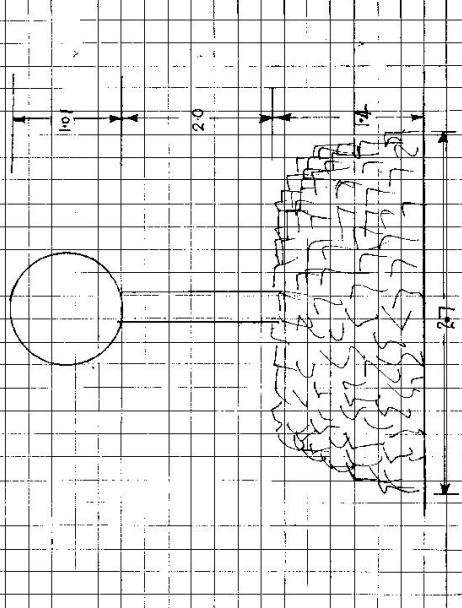ST 2735-2 D. West, Government Printer Beacon Diagram	STATION WATTMAN G.S. IS 6602	Owner's Name: Address: Phone: Current Occupant: Address: Phone: ACCESS Access Report of 26.9.1980 was found suitable/unsuitable. 0.0 CROSWELL POST OFFICE Head north along Groulburn Street ✓ 0.8 Turn left towards Gunning ✓ 4.3 Garbage tip on left. 5.3 Owner's house on right (Owner of land on way to trig) ✓ 5.7 Through gate on right. Follow gravel road. 6.3 Keep left. 6.5 At gravel pit. Head straight across pit towards track on opposite side. Follow track. 6.9 Through wire gate. 7.1 Trig on right.
Not to Scale 	Note: Trig is on T.R. 18764 ✓ Contact Kevin Osborne at Shire Chambers for further information. Ph (048) 321022	Date: Record of Station:
This section to be completed by officer constructing pillar. Original station mark found/not found. Description of mark: Original beacon found/not found. Description of beacon: Height Top of Varies to Top Mark:m. Height of mark:m. above G.L. below Diameter of Vases:m. Height of Cairn:m. Original Beacon has/not been destroyed by me.		

CENTRAL MAPPING AUTHORITY

GEODETIC STATION RECONNAISSANCE and MAINTENANCE REPORT

GEODETIC SURVEY OF N.S.W.

STATION: **WATTMAN PILLAR** No: **6602**
 MAP SHEET SCALE 1:250 000 **GOULBURN**
 INSPECTED BY: **W.M. GILLIBRAY** DATE: **23/10/80**
 AUTHORITY: **CMA** FIELD BOOK: **1677**

Station Diagram
 Not to Scale
 North

- Description: *Note: Cross out word or words which do not apply*
- Cleared by lanes bearing 180° - 79.6° - 332° - 151° from Trig. Mast
 - Mast & Vanes have been painted white & black respectively.
 - The station/pillar was ~~unplaced~~ ~~not placed~~ /constructed on 2.7 m. 19 S.O., dimensions now being: Description of mark **PILLAR PLATE** should be explicit, e.g., S/Steel Pillar Plate, Steel plug, Brass plug, Bolt, G.I. Pipe
 Height of mark 3.70 m. ~~above~~ ~~below~~ ~~rock~~ ~~concrete~~; Mark is 520 m. ~~above~~ ~~below~~ G.L.
 Height of Top Vanes to Top ~~Mark~~ /Pillar plate 1.940 m. Diameter of Vanes (vertical) 7.55 m.
 Height of Cairn 0 m. Diameter of Cairn 0 m. Name Plate found/not found/placed.
 Length of Mast 1.520 m. (approximate if not unplied)
 - BRASS PLAG** set in ~~stone~~ /rock has been ~~placed~~ /found, bearing 255° M from ~~Mast~~ /Plug/Pillar ✓
 - COPPER NAIL** set in ~~conc~~ /~~rock~~ has been ~~placed~~ /found, bearing 163° M from ~~Mast~~ /Plug/Pillar ✓
 - C.I. PIPE** set in ~~conc~~ /~~rock~~ has been ~~placed~~ /found, bearing 219° M from ~~Mast~~ /Plug/Pillar ✓
 - A** set in ~~conc~~ /~~rock~~ has been placed /found, bearing 0° M from ~~Mast~~ /Plug/Pillar ✓
 - Action required: 0 m from ~~Mast~~ /Plug/Pillar ✓

STANDPOINT: CONCRETE PILLAR			STANDPOINT: BRASS PLAG				
Mark	Direction	Horiz. Distance	Height Difference	Mark	Direction	Horiz. Distance	Height Difference
MARAWA PILLAR	359 59 60		above standpt.	MARAWA PILLAR	359 59 60		above standpt.
PEGAR G.S.	186 10 40		above standpt.	WATTMAN PILLAR	157 06 40	3.162	below standpt. 1.494
PEPMORE G.S.	196 16 30		above standpt.	PEGAR G.S.	186 09 55		above standpt.
COPPER NAIL	247 02 10	2.533	above standpt. 1.542	COPPER NAIL	195 46 50	4.052	above standpt. 0.556
C.I. PIPE	302 17 30	5.321	above standpt. 1.446	PEPMORE G.S.	196 15 55		above standpt.
BRASS PLAG	337 04 45	3.163	above standpt. 1.484	C.I. PIPE	268 46 20	3.269	above standpt. 0.033

Prepared by: *Noted on U.T.M. Card*

Checked:


Checked:

2723 - 2 D. West, Government Printer

STATION WATTMAN PILLAR TS 6602

Owner's Name: TRIG RESERVE 1974 Current Occupant: _____
 Address: LAND ROAD OFFICE Address: _____
COULSBURN Phone: _____
 Phone: _____

ACCESS
 Access Report of 26/7/1980 was found suitable/unsuitable.
POST OFFICE CROSSWELL HEAD NORTH ALONG COULSBURN ST
TURN LEFT SIGN GUNNING
GRABBLE TIP ON LEFT
DWARDS HOUSE ON RIGHT
THROUGH GATE ON RIGHT FOLLOW GRABBLE ROAD
POLE ON LEFT
AT GRABBLE PIT HEAD STRAIGHT ACROSS TRACK ON RIGHT
WIRE GATE
G.S.

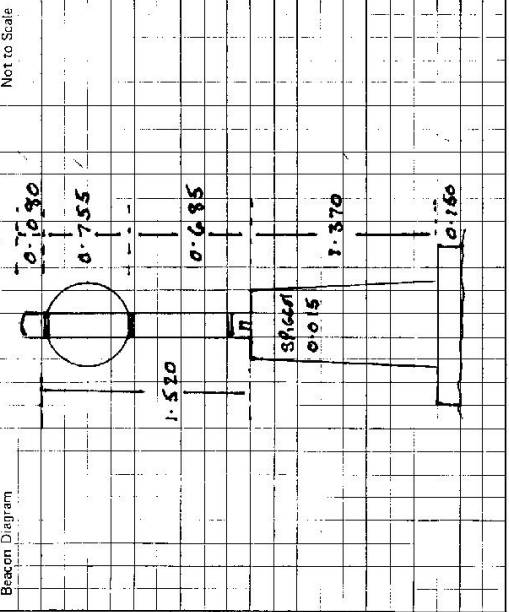

This section to be completed by officer constructing pillar.

Original station mark found/not found.
 Description of mark: ROCK PILE IN ROCK
 Original beacon found/not found.
 Description of beacon: ROCK CAIRN MADE OF STONES
 Height Top of Vanes to Top Mark 9.920 m.
 Height of mark: 0.560 m. above G.L. / below rock/level
 Diameter of Vanes 1.010 m. / Height of Cairn 1.50 m.
 Original Beacon has/not been destroyed by ma.

Date	Record of Station

GEODETTIC SURVEY OF A.S.W.

CENTRAL MAPPING AUTHORITY

GEODETTIC STATION RECONNAISSANCE and MAINTENANCE REPORT

Description:

1. Cleared by James bearing 175° to 305° 325° to 155° Mac. from Trig. Mast
 Note: Cross out word or words which do not apply

2. Mast & Vanes have been painted white & black respectively. ✓

3. The station/pillar was unpiled/not unpiled/constructed on 19....., dimensions now being:

Description of mark: Steel Pillar (K should be explicit, e.g., S/Steel Pillar Plate, Steel plug, Brass plug, Bolt, G.I. Pipe)

Height of mark.....m. ^{above} rock/concrete; Mark is.....m. ^{above} G.L.

Height of Top Vanes to Top Mark/Pillar plate.....m. Diameter of Vanes (vertical).....m.

Height of Cairn.....m. Diameter of Cairn.....m. Name Plate found/~~not found~~/~~plac~~ed.

Length of Mast.....m. (approximate if not unpiled)

4. A.....set in conc/rock has been placed/found, bearing.....°M from Mast/Plug/Pillar

5. A.....set in conc/rock has been placed/found, bearing.....°M from Mast/Plug/Pillar

6. A.....set in conc/rock has been placed/found, bearing.....°M from Mast/Plug/Pillar

7. A.....set in conc/rock has been placed/found, bearing.....°M from Mast/Plug/Pillar

8. Action required:.....

STANDPOINT:

STANDPOINT:

Mark	Direction	Horiz. Distance	Height Difference	Mark	Direction	Horiz. Distance	Height Difference
			above standpt.				above standpt.
			below				below
			above standpt.				above standpt.
			below				below
Prepared by: [Signature]


Checked: AS 7/11

Noted on U.T.M. Card [Signature]

Checked [Signature] 2/12/84

STATION: WATMAN CS (P) No: 6602
 MAP SHEETS SCALE 1:250 000 GOULBURU SCALE 1:400 000 CRUOKWELL
 INSPECTED BY: L. HITCHINS DATE: 25th Sep '84
 AUTHORITY: C.M.A. FIELD BOOK: 1959

64 2733 - 2 D. West. Government Printer

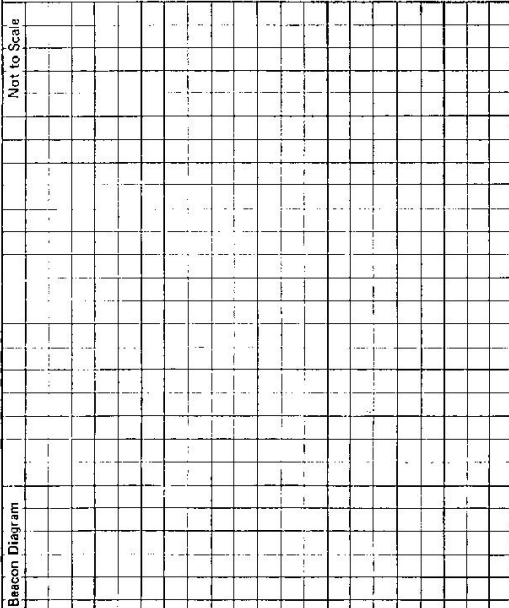Beacon Diagram 	<p style="text-align: center;">STATION WATTMAN CS (1) TS 6602</p> <p>Owner's Name: A J JE SCHROEDER Address: WATTLE CLEN CHARREN CULLEN ROAD (DROOKWELL 2585) Phone:</p> <p style="text-align: center;">ACCESS</p> <p>Access Report of 25/11/2021 was found suitable/unusable. DROOKWELL DO HEAD DOWN MAIN STREET TOWARDS BATHURST 0-84 TURN LEFT ONTO CUNNINGHAM ROAD 5-21 PASS HOUSE ON RIGHT 5-64 TURN RIGHT THROUGH IRON GATE (C.M.A. LOCK) 6-24 FOLLOW TRACK TO LEFT 6-41 CARUEL SWAMPY FOLLOW TRACK TO RIGHT OF SWAMPY + UP HILL 6-79 FOLLOW TRACK TO RIGHT 6-82 THROUGH GAP IN FENCE 7-07 TURN RIGHT OFF TRACK 7-09 WATTMAN CS (1P)</p>	<p>Current Occupant:</p> <p>Address:</p> <p>Phone:</p>
This section to be completed by officer constructing pillar. Original station mark found/not found.		Record of Station
Description of mark: Original beacon found/not found.		Date
Description of beacon: Height Top of Vanes to Top Markm. above below Height of markm. rock/concm. below G.L. Diameter of Vanesm. Height of Cairnm. Original Beacon has/has not been destroyed by me.	