

Proposed Name  
**LEGUME**


TS No.: **6609**

STATION: **WARWICK**

MAP SHEET SCALE 1:250 000

INSPECTED BY: **J. Judge** DATE: **14.5.80**

AUTHORITY: **C.M.A.** FIELD BOOK: **AB 1847**

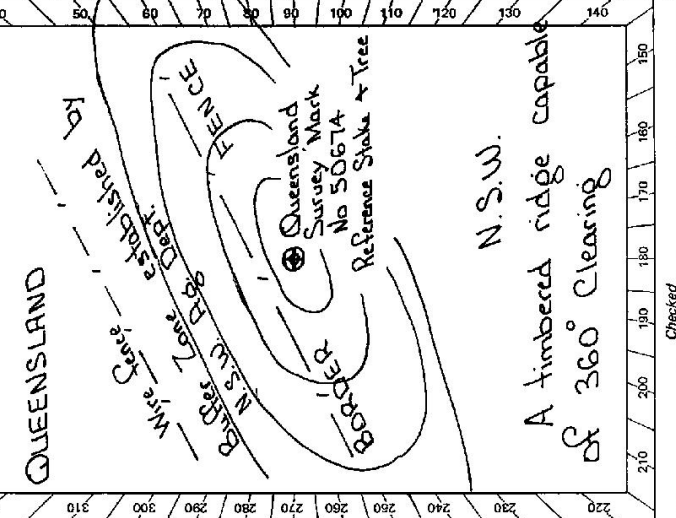

GEODETTIC SURVEY OF N.S.W.

GEODETTIC STATION RECONNAISSANCE and MAINTENANCE REPORT

- Description: *Note: Cross out word or words which do not apply*
- Cleared by lanes bearing..... from Trig. Mast
  - Mast & Vanes have been painted white & black respectively.
  - The station/pillar was unpiled/not unpiled/constructed on..... 19....., dimensions now being: Description of mark..... should be explicit, e.g., S/Steel Pillar Plate, Steel plug, Brass plug, Bolt, G.I. Pipe
- Height of mark.....m. <sup>above</sup>/<sub>below</sub> rock/concrete; Mark is.....m. <sup>above</sup>/<sub>below</sub> G.L.
- Height of Top Vanes to Top Mark/Pillar plate.....m. Diameter of Vanes (vertical).....m.
- Height of Cairn.....m. Diameter of Cairn.....m. Name Plate found/not found/placed.
- Length of Mast.....m. (approximate if not unpiled)
- A..... set in conc/rock has been placed/found, bearing.....° M from Mast/Plug/Pillar
  - A..... set in conc/rock has been placed/found, bearing.....° M from Mast/Plug/Pillar
  - A..... set in conc/rock has been placed/found, bearing.....° M from Mast/Plug/Pillar
  - A..... set in conc/rock has been placed/found, bearing.....° M from Mast/Plug/Pillar
8. Action required.....

STANDPOINT: Top of hill				STANDPOINT: Top of hill			
Mark	Direction	Horiz. Distance	Height Difference	Mark	Direction	Horiz. Distance	Height Difference
Mount Start	331° M		above standpt.	Under cliff station	196° M		above standpt.
A Hill	342° M		above standpt.	Sugarloaf hill	204° M		above standpt.
Acacia hill	53° M		above standpt.	Cullendore station	232° M		above standpt.
South Obelisk Hill	118° M		above standpt.	Rokeby hill	261° M		above standpt.
Pocahontas hill	131° M		above standpt.	Silverwood hill	267° M		above standpt.
Mandle station	150° M		above standpt.				above standpt.
River tree hill	170° M		above standpt.				above standpt.

Prepared by: **J. Judge** 5.6.80 Checked: **C.M.A.**

GS

PROPOSED NAME  
STATION LEGUME IS 6609

N.S.W Owner's Name: Mr. Affleck  
 Address: Legume 2476  
 Phone: 0216 664117  
 Queenstand Owner Not Yet Located  
 Address:  
 Phone:

ACCESS

Access Report of 14/5/19 was found suitable/unsuitable.

ACCESS. AWD and 2 minute walk or 2WD and 10 minute walk.  
 From Legume P.O. 432100 E 6857400 N  
 Take the Warwick road for 100m to wooden church on the corner.  
 Turn left here into gravel lane. Cross creek, Cross grid  
 at 0.8km. and take the left fork. Pass through wire  
 gate at 1.0km reaching owners house at the end of  
 the road at 1.4 km. See the owner.  
 Take track on the R.H.S. of the garages. Follow fence  
 to the flat then follow track up ridge and generally  
 up and into the hill. Track fades about 2.4 km or so.  
 Follow nose, on foot or A.W.D, to base of short,  
 sheep climb to station. A 2 minute climb to top.  
 Station on top of ridge 430100 E 6859000 N.

6.2733. 2 D. West, Government Printer

Beacon Diagram	Not to Scale
Scaled Coords of station	
430100E 6859000N	
Obtained from Warwick 1:100000	
9341.	

This section to be completed by officer constructing pillar.

Original station mark found/not found.

Description of mark:

Original beacon found/not found.

Description of beacon:

Height Top of Vanes to Top Mark.....m.

Height of mark.....m. above G.L. below G.L.

Diameter of Vanes .....m. Height of Cairn .....m.

Original Beacon has/hus not been destroyed by me.

Date	Record of Station
	Note Station is to be established about 2 metres from the Border Fence and on N.S.W side.
	N.S.W owner has given permission for clearing and construction on HIS LAND
	Queenstand owner is still to be identified.



