

TS 6623

STATION: **BANYABBA**
 MAP SHEET SCALE 1:250 000
 INSPECTED BY: **D. KINLYSIDE**
 AUTHORITY: **C.M.A.**

No.: **5404**
 DATE: **5-6-80**
 FIELD BOOK: **1B7D**

CENTRAL MAPPING AUTHORITY
 GEODETTIC SURVEY OF N.S.W.
 GEODETTIC STATION RECONNAISSANCE and MAINTENANCE REPORT


Description: *Note: Cross out word or words which do not apply*

1. Cleared by lanes bearing..... *See diagram*..... from Trig. Mast
2. Mast & Vanes have been painted white & black respectively
3. The station/pillar was unpiled/not unpiled/constructed on..... 19....., dimensions now being:
 Description of mark. *S/S*..... should be explicit, e.g., S/Steel Pillar Plate, Steel plug, Brass plug, Bolt, G.I. Pipe
 Height of mark..... m. *above* rock/concrete; Mark is *0.10*..... m. *above* G.L.
 Height of Top-Vanes-to-Top-Mark/Pillar-plate..... m. Diameter of Vanes (vertical)..... m.
 Height of Cairn..... m. Diameter of Cairn..... m. Name Plate found/not found/placed.....
 Length of Mast..... m. (approximate if not unpiled)
4. A..... *1*..... set in *stone* block has been placed/ found, bearing..... *268*..... °M from Mast/Plug/Pillar
5. A..... *Copper Nail*..... set in conc/rock has been placed/ found, bearing..... *307*..... °M from Mast/Plug/Pillar
6. A..... set in conc/rock has been placed/ found, bearing..... °M from Mast/Plug/Pillar
7. A..... set in conc/rock has been placed/ found, bearing..... °M from Mast/Plug/Pillar
8. Action required: *Construct Pillar. Add 2 x 1.5 m. x 1.5 m. x 1.5 m. with cross mark. Clear timber towards Marsh (Mast sited 21.7.80)*

STANDPOINT:

Mark	Direction	Horiz. Distance	Height Difference	Mark	Direction	Horiz. Distance	Height Difference
PINNACLES	<i>133° 22' 49"</i>		above standpt				above standpt
BRACEMAR	<i>0° 55'</i>		above standpt				above standpt
STRABANABALE	<i>59° 51'</i>		below standpt				below standpt
MARSH	<i>277° 01'</i>		above standpt				above standpt
NEVILLE	<i>304° 21'</i>		below standpt				below standpt
COAL GAP	<i>253° 23'</i>		above standpt				above standpt

Prepared by: *P. Holden* 7-7-80
 Checked: *Thyge*
 Noted on U.T.M. Card

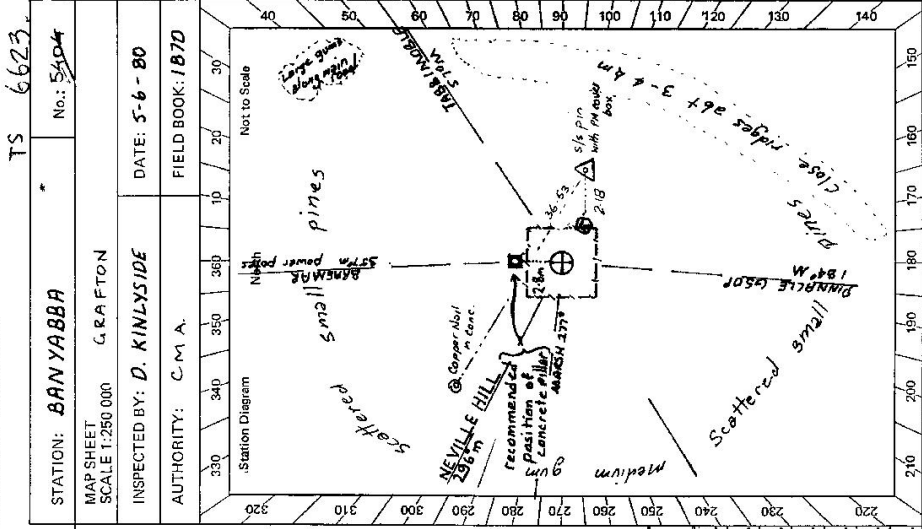

612733-2 D. West, Government Printer

Beacon Diagram A120 known as: CMB 7-054 PM 32767	Not to Scale 	STATION BAN YABBA 6623	Owner's Name: BAN YABBA STRIKE FOREST Address: Phone: Current Occupant: Address: Phone: ACCESS Access Report of 5.1.1980 was found suitable/unsuitable. Whoprie P.O. (halfway between Grafton and Casino) heading south towards Grafton Dept of Agriculture Tick Gate Bridge over Railway line 5.3 Turn RIGHT then cross grid. 5.35 Turn LEFT and follow fence 6.0 Turn RIGHT 6.3 Straight ahead 6.5 Forestry Commission steel pillar
This section to be completed by officer constructing pillar. Original station mark found/not found. Description of mark: Original beacon found/not found. Description of beacon: Height Top of Vanes to Top Markm. Height of markm. above G.L. below Diameter of Vanesm. Height of Cairnm. Original Beacon has/not been destroyed by me.		Record of Station Date 31.7.80 Mr. Banks - permission for pillar construction in clearing towards MARSH line cleared towards Marsh.	

GEODETTIC SURVEY OF R.S.W.

CENTRAL MAPPING AUTHORITY


GEODETTIC STATION RECONNAISSANCE and MAINTENANCE REPORT

STATION: **BANYASSA (P)** No.: **6623**

MAP SHEET SCALE 1:250 000 **GRAFTON**

INSPECTED BY: **H. C. BORDER** DATE: **4-11-80**

AUTHORITY: **C. M. A** FIELD BOOK: **1684**

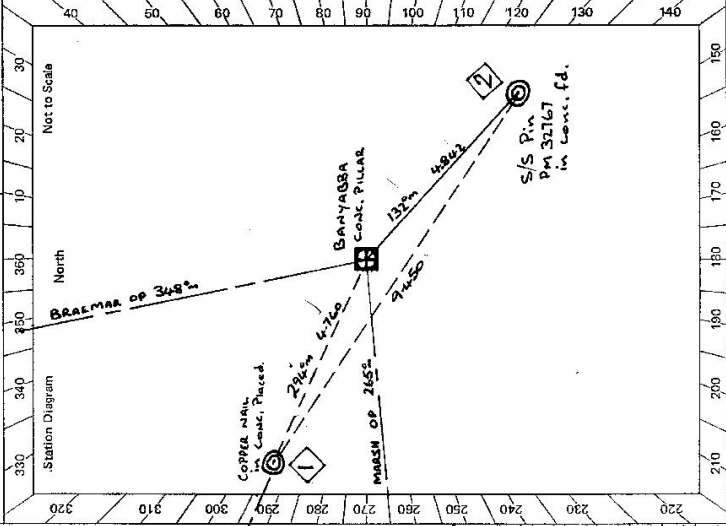

Note: Cross out word or words which do not apply

- Cleared by lanes bearing **261° to 267°**, **292° to 321°**, **330° to 371°**, **441° to 501°** from **Trig-Mast**
51° to 77°, **102° to 163°**, **168° to 183°**, **212° to 230°**
- Mast & Vanes have been painted white & black respectively. ✓
- The station/pillar was ~~emptied~~ ~~emptied~~ /constructed on **1 October**..... 19**80**...., dimensions now being:
 Description of mark: **S/S Pillar** Plate should be explicit, e.g., S/Steel Pillar Plate, Steel plug, Brass plug, Bolt, G.I. Pipe
 Height of mark: **1.370**.....m. ^{above} ~~below~~ **rock/concrete**; Mark is **1530**.....m. ^{above} ~~below~~ G.L.
 Height of Top Vanes to Top Mark/Pillar plate **1.450**.....m. ✓ Diameter of Vanes (vertical) **0.755**.....m. ✓
 Height of ~~Cap~~.....m. ✓ Diameter of ~~Cap~~.....m. ✓ Name Plate ~~found/not found~~ /placed.
 Length of Mast **1.530**.....m. (approximate if not unpiled)
- S/S Pin** **Pm 321767**.....set in conc/~~rock~~ has been ~~placed~~ /found, bearing **132°**.....°M from ~~Mounting~~ /Pillar
- A COPPER NAIL**.....set in conc/~~rock~~ has been ~~placed~~ /found, bearing **294**.....°M from ~~Mounting~~ /Pillar
- A**.....set in conc/~~rock~~ has been placed /found, bearing.....°M from Mast/Plug/Pillar
- A**.....set in conc/~~rock~~ has been placed /found, bearing.....°M from Mast/Plug/Pillar
- Action required:.....

STANDPOINT: CONC. PILLAR				STANDPOINT: S/S Pin Pm 321767			
Mark	Direction	Horiz. Distance	Height Difference	Mark	Direction	Horiz. Distance	Height Difference
MARSH OP	359 59 60		above standpt.	MARSH OP	359 59 60		below standpt.
NEVILLE	27 14 00		above standpt.	NEVILLE	27 13 30		above standpt.
COPPER NAIL	29 02 50	4.760	above standpt.	COPPER NAIL	39 17 00	9.450	above standpt.
BRAEMAR OP	83 48 44		above standpt.	CONC. PILLAR	49 22 26	4.842	above standpt.
S/S Pin Pm 321767	229 21 50	4.841	above standpt.				below

Prepared by: **H. C. BORDER** Checked: *[Signature]* Noted on U.T.M. Card

Checked

St 2733-2 D. West, Government Printer

STATION **BANYASSA (P)** * **6623**

Owner's Name: **FORESTRY COMMISSION**
 Address: **BANYASSA STATE FOREST**
RICHMOND ARCADE CASINO
 Phone: **BRIAN BOURKE (066) 621 688**


Current Occupant: **PINE FOREST**
 Address:
 Phone:

ACCESS

Access Report of **5/6/1982** was found suitable/~~unsuitable~~.

Km's:
0.0 WHIPORE Post Office (halfway between GRAFTON & CASINO) heading South towards GRAFTON
3.1 Dept. of Agriculture Tick Gate
4.0 Bridge over Railway line
5.5 Turn Right, then across grid, turning Left & following track along fence line
6.25 Turn Right & Straight ahead
6.80 Conc, OBS, PILLAR

(Signs 2.4.5 just before turning Right)
BANYASSA STATE FOREST
RICHMOND RANGE

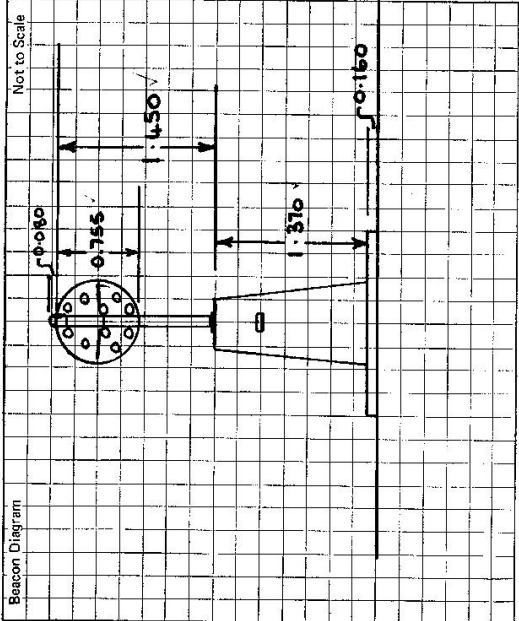

This section to be completed by officer constructing pillar.

Original station mark found/~~not found~~.

Description of mark: **S/S Pin P.M 3767**
 in conc. with cover box over it.

Original ~~height~~ found/~~not found~~.

Description of beacon:

Height ~~Top of Vane to Top Mark~~

Height of markm, ~~above~~ **0.440** above G.L. ~~below~~

Diameter of Vanem. Height of Gaffm.

Original Beacon ~~height~~ ~~not~~ ~~been~~ ~~destroyed~~ by me.

Date	Record of Station