

CENTRAL MAPPING AUTHORITY

GEODETIC SURVEY OF N.S.W.

GEODETIC STATION RECONNAISSANCE and MAINTENANCE REPORT

Description:

1. Cleared by lanes bearing **62°M - 81°N** **260°M - 278°N**. *Note: Cross out word or words which do not apply*
2. Mast & Vanes have been painted white & black respectively. *from Trig. Mast*
3. The station/**pillar** was unpiled/**not unpiled/constructed** on **4th Junc.** **19.80**., dimensions now being:
Description of mark/**ASL. Concrete** should be explicit, e.g., S/Steel Pillar Plate, Steel plug, Brass plug, Bolt, G.I. Pipe
Height of mark **1.16** m. ^{above} ~~below~~ rock/concrete; Mark is **.....** m. ^{above} ~~below~~ G.L.
Height of Top Vanes to Top Mark/**Pillar plate** **4.035** m. Diameter of Vanes (vertical) **10.5** m.
Height of Cairn **1.0** m. Diameter of Cairn **1.2** m. Name Plate found/not found/placed.
Length of Mast **4.035** m. (approximate if not unpiled)
4. A **SSM** set in conc/**rock** has been **placed**/found, bearing **242** °M from **Mast/Plug/Pillar**
5. A **G.I. Pipe** set in conc/**rock** has been **placed**/found, bearing **216** °M from **Mast/Plug/Pillar**
6. A set in conc/**rock** has been placed/found, bearing **.....** °M from **Mast/Plug/Pillar**
7. A set in conc/**rock** has been placed/found, bearing **.....** °M from **Mast/Plug/Pillar**
8. Action required: **4 MTS Concrete for 360° station**

STANDPOINT:

Mark	Direction	Horiz. Distance	Height Difference	Mark	Direction	Horiz. Distance	Height Difference
			above standpt.				above standpt.
			below standpt.				below standpt.
			above standpt.				above standpt.
			below standpt.				below standpt.
Prepared by: **R. LAUNDER**

Checked: **.....**

Noted on U.T.M. Card

S: 2733-1


STATION: **BOORABEE G.S.** No: **6633**
 MAPSHEET SCALE 1:250 000 **TWEED HEADS**
 INSPECTED BY: **R. LAUNDER** DATE: **4-6-80**
 AUTHORITY: **C.M.A.** FIELD BOOK: **AB 1844**

STATION **BOORABEE (P)** 6633

Owner's Name: **R. O'REILLY** Current Occupant:
 Address: **28 CANNON ST** Address:
 Phone: **321193** Phone:

ACCESS

Access Report of **16/11/82** was found suitable/unsuitable.
POST OFFICE KYOGLE HILL TOWARDS CANNON
 0.00 TURN LEFT WELBOS ROAD
 4.70 CROSS RAILWAY LINE
 5.30 TURN SHARP LEFT follow bend.
 7.85
 11.10
 12.05 TURN LEFT BOORABEE ROAD
 17.40 CROSS WOODEN BRIDGE. THEN GOID HOUSE on LEFT.
 18.20
 18.35
 18.40
 18.45 CROSS GOID V SWING LEFT OVER BRIDGE
 19.95 TURN RIGHT.
 15.00 WHILE WOODEN GATE, YARDS on RIGHT KEEP YARDS = FENCE on RIGHT
 15.10 IRON GATE. SWING LEFT.
 15.60 THROUGH GATE. GO STRAIGHT AHEAD.
 15.70 TURN RIGHT OVER BRIDGE TO GOID FARM.
 16.35 WIRE GATE OVER BRIDGE ONTO TRACK.
 17.10 TURN RIGHT ONTO TRACK UP ROAD LINE
 18.35 WIRE GATE KEEP TO MAIN TRACK.
 18.55 FARM GO RIGHT
 19.59 GO STRAIGHT AHEAD UP HILL.
 19.68 DOWN ON LEFT
 19.71 TURN SHARP RIGHT. FOLLO TRACK follow to ROCKS NEAR S.S. 19.73

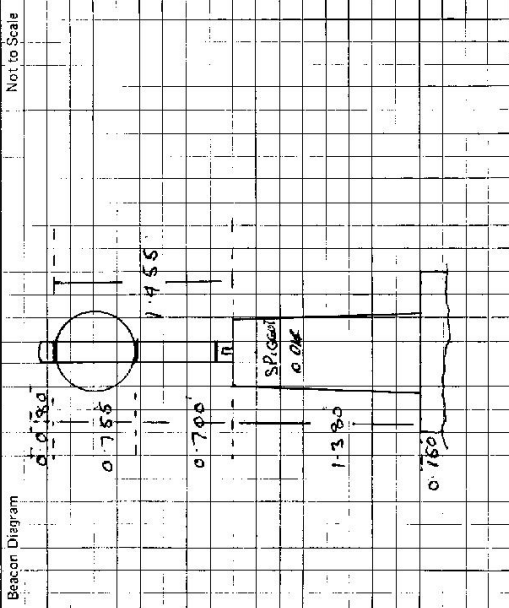

This section to be completed by officer constructing pillar.

Original station mark found/net found.
 Description of mark: **A.S.C. PARABEE**
 Original beacon found/net found.
 Description of beacon: **ROCKS, CANNON, MOUNT V. VINDLES**
 Height Top of Vanes to Top Mark: **2.000** m.
 Height of mark: **6.2** m. above below
 Diameter of Vanes: **1.000** m. Height of Cairn: **1.000** m.
 Original Beacon has/has not been destroyed by ms.

Date Record of Station