


TS-6634  
No. 2262

STATION: GOONENGERRY GS

MAP SHEET  
SCALE 1:250 000

INSPECTED BY: D. FREDRIKSEN  
DATE: 15/3/80

AUTHORITY: CMA  
FIELD BOOK: 1852.

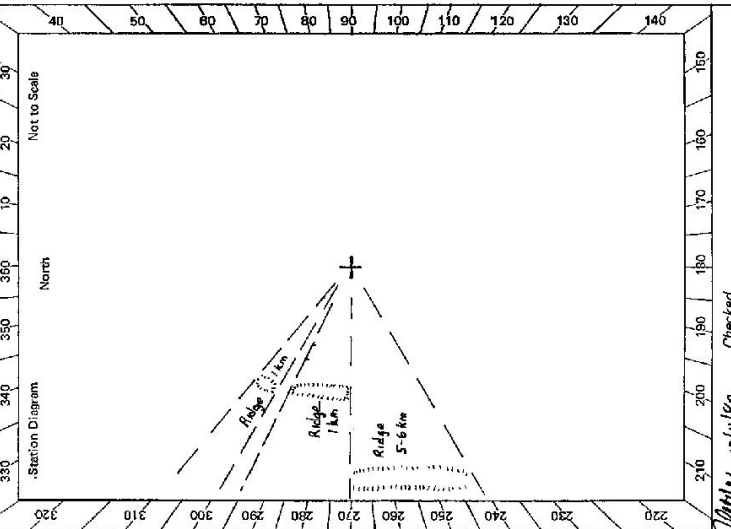

CENTRAL MAPPING AUTHORITY  
GEODETTIC SURVEY OF A.S.W.  
GEODETTIC STATION RECONNAISSANCE and MAINTENANCE REPORT

Description: Note: Cross out word or words which do not apply

1. Cleared by lanes bearing *hill* ~~hill~~ *steering* ~~steering~~ from Trig. Mast
2. Mast & Vanes have been painted white & black respectively, and temporarily repiled
3. The station/pillar was unplaced/not unplaced *15.3.3* ~~15.3.3~~ dimensions now being: Description of mark *R.A.S.C. Ridge* ~~R.A.S.C. Ridge~~ should be explicit, e.g., S/Steel Pillar Plate, Steel plug, Brass plug, Bolt, G.I. Pipe  
Height of mark *above* ~~below~~ rock/concrete; Mark is *above* ~~below~~ G.L.  
Height of Top Vanes to Top Mark/Pillar-plate *3.72* ~~3.72~~ m. Diameter of Vanes (vertical) *1.22* ~~1.22~~ m.  
Height of Cairn *0* ~~0~~ m. Diameter of Cairn *0* ~~0~~ m. Name Plate found/not found/placed.  
Length of Mast *3.72* ~~3.72~~ m. (approximate if not unplaced)
4. *G.I. Pipe* ~~G.I. Pipe~~ set in conc/rock has been placed/found, bearing *5.7* ~~5.7~~ ° M from Mast/Plug/Pillar *3.78* ~~3.78~~ m.
5. *Sk. Nail* ~~Sk. Nail~~ set in conc/rock has been placed/found, bearing *4.38* ~~4.38~~ ° M from Mast/Plug/Pillar *2.87* ~~2.87~~ m.
6. *A* ~~A~~ set in conc/rock has been placed/found, bearing *0* ~~0~~ ° M from Mast/Plug/Pillar
7. *A* ~~A~~ set in conc/rock has been placed/found, bearing *0* ~~0~~ ° M from Mast/Plug/Pillar
8. Action required: *Remove* ~~Remove~~ *Pillar* ~~Pillar~~

STANDPOINT:		STANDPOINT:		STANDPOINT:		STANDPOINT:	
Mark	Direction	Horiz. Distance	Height Difference	Mark	Direction	Horiz. Distance	Height Difference
PALMWOOD (hill)	343° 25' 0"	Provided	above standpt	NUNULGI	ridge 211° 21'		above standpt
BURRINGBAR (hill)	7° 41'	hill	below standpt				below standpt
CHINGLOSON GS	38° 40'	P	above standpt				below standpt
BURNSWICK GS	47° 47'	P	below standpt				below standpt
BOOKLET	65° 154° 58'	P	below standpt				below standpt
CLUNES	hill 182° 41'	Provided	above standpt				below standpt
MCLELLAN RUBE	hill 190° 41'	Provided	below standpt				below standpt

Prepared by: *R.H. H. H.*  
Checked: *8/03/17/18*  
Noted on U.T.M. Card  
Checked: *20/11/80*

STATION **GOONENBERRY GS TS 6634**

Beacon Diagram

OTHER TRIGS LOCATED FOR

Not to Scale

Station	Asimuth	Description
PERCH MOUNTAIN	292° 40'	Na. on
MATHESON	247° 54'	Vertical bull heady like
JEANSEN	320° 12'	Na. on
DUNGOON	233° 50'	Na. on
GRANVILLE	170° 11'	Na. on
CAPE BYRON	93° 20'	Na. on
JULIAN	172° 37'	Na. on
BYRON VIEW		Na. on

Owner's Name: **J. VARDER**  
 Address: **SUNRISE FARM**  
 Phone: **MAL RD**  
 Current Occupant:  
 Address:  
 Phone:

Access Report of **15/3/1988** was found ~~at~~ **un** suitable.

**ACCESS**

0.00 Public School Goonangery travelling towards Mullumbimby  
 0.35 Turn LEFT against 'SGF Forest', 'Mill Rd'  
 0.46 Pass turn off to owners house on R.H.S.  
 1.26 Turn right through mangrove before old cowbats  
 and then right up steep ridge.  
 1.80 At trig

This section to be completed by officer constructing pillar.

Original station mark found/not found.

Description of mark: .....

Original beacon found/not found.

Description of beacon: .....

Height Top of Vanes to Top Mark ..... m.  
 above rock/conc ..... m. above G.L.  
 below  
 Height of mark ..... m. below  
 Diameter of Vanes ..... m. Height of Cairn ..... m.  
 Original Beacon has/has not been destroyed by me.

Date	Record of Station
	<i>All permissions granted</i>

GEODETIC SURVEY OF M.S.I.K

CENTRAL MAPPING AUTHORITY

GEODETIC STATION RECONNAISSANCE AND MAINTENANCE REPORT

Description: 260° Note: Cross out word or words which do not apply

1. Cleared by lanes bearing 260° from Trig. Mast

2. Mast & Vanes have been painted white & black respectively ✓

3. The station/pillar was ~~unplaced~~ not unplaced /constructed on 28.11.80 dimensions now being:

Description of mark: S/S S/Steel Pillar Plate, Steel plug, Brass plug, Bolt, G.I. Pipe

Height of mark: 1.3.0 above rock/concrete; Mark is 1.55.0 m. above G.L.

Height of Top Vanes to Top Mark/Pillar plate: 1.415 m. Diameter of Vanes (vertical): 0.715 m.

Height of Cairn: ..... m. Diameter of Cairn: ..... m. Name Plate found/not found/placed.

Length of Mast: ..... m. (approximate if not unplaced)

4. A.S.C. BRASS RANGE set in conc/rock has been placed/found, bearing: 283° M from Mast/Plug/Pillar


5. A. COPPER NAIL set in conc/rock has been placed/found, bearing: 245° M from Mast/Plug/Pillar

6. A. G.I. PIPE set in conc/rock has been placed/found, bearing: 239° M from Mast/Plug/Pillar

7. A..... set in conc/rock has been placed/found, bearing: .....° M from Mast/Plug/Pillar

8. Action required: .....

Mark	Direction	Horiz. Distance	Height Difference	Mark	Direction	Horiz. Distance	Height Difference
CHINCOGAN (S.P)	0 00 00		above standpt.	CHINCOGAN (S.P)	0 00 00		above standpt.
BALUNSWICK (S.P)	15 07 00		above standpt.	BALUNSWICK (S.P)	15 06 25		above standpt.
COPPER NAIL	210 52 20	2.483	above standpt.	G.I. PIPE	31 03 55	3.770	above standpt.
A.S.C. BRASS RANGE	259 45 00	4.269	above standpt.	S/S PILLAR PLATE	79 43 25	4.269	above standpt.
G.I. PIPE	317 34 55	3.343	above standpt.	COPPER NAIL	119 26 25	2.808	above standpt.
			below standpt.				below standpt.
			above standpt.				above standpt.
			below standpt.				below standpt.

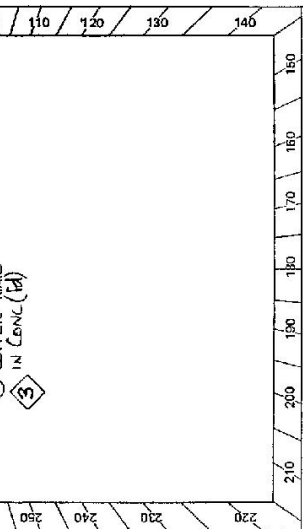

Prepared by: [Signature] Noted on U.T.M. Card

St 2733-1


Checked

STATION: GODDENGERRY (S.P) No: 6634  
 MAP SHEET: TWEED HEADS  
 SCALE: 1:250 000  
 INSPECTED BY: L. HITCHINS DATE: 29/11/80  
 AUTHORITY: CMA FIELD BOOK: 1876

STATION **GOONENGERY GS (P) 6634**

Owner's Name: **J. VADDER**  
 Address: **"SPURRISE FARM" MILL ROAD GOONENGERY**  
 Phone: **ACCESS 29-11-1980**  
 Current Occupant:  
 Address:  
 Phone:

Access Report of **15/3/1980** was found suitable/unavailable.  
 O O PUBLIC SCHOOL GOONENGERY TRAVELLING TOWARDS MULLUMBIMBY  
 O 35 TURN LEFT SIGNPOST "B.G.F. FOREST", "MILL RD."  
 O 46 PASS TURN OFF TO OWNERS HOUSE ON RHS (END OF TRACK)  
 1-26 TURN RIGHT THROUGH IRON GATE AND THEN RIGHT  
 AGAIN UP STEEP GRADE. (4WD)  
 1-80 GOONENGERY GS (P)

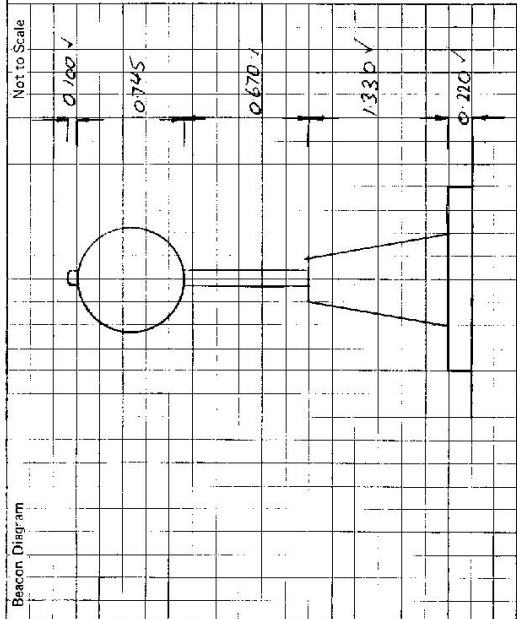

This section to be completed by officer constructing pillar.

Original station mark found/~~not found~~.  
 Description of mark: **ASIANIAN SANDY LERP BRASS PLATE**  
 Original beacon found/~~not found~~.  
 Description of beacon: **CAIRN PILE OF STONES**  
 Height Top of Vanes to Top Mark: **3.725** m.  
 Height of mark: **At** above peak/conc. **At** above G.L. **Below**  
 Diameter of Vanes: **0.10** m. Height of Cairn **1.00** m.  
 Original Beacon has/~~has not~~ been destroyed by me.

Date	Record of Station