

TI- 6638
No.: 1873

GEODETTIC SURVEY OF N.S.W.

GEODETTIC STATION RECONNAISSANCE and MAINTENANCE REPORT

STATION: **DRAKE**

MAP SHEET
SCALE 1:250 000

INSPECTED BY: **M.L. Morrison**

DATE: **24/10/19**

AUTHORITY: **C.M.A.**


FIELD BOOK: **1798**

- Description:**
 1. Cleared by James bearing.....
 Note: Cross out word or words which do not apply
 from Trig, Mast
2. Mast & Vanes have been painted white & black respectively.
3. The station/pillar was unpiled/not unpiled/constructed on.....
 dimensions now being:
- Description of mark..... should be explicit, e.g., S/Steel Pillar Plate, Steel plug, Brass plug, Bolt, G.I. Pipe
- Height of mark.....
 above below
 Mark is.....
 above below
 G.L.
- Height of Top Vanes to Top Mark/Pillar plate
 Diameter of Vanes (vertical).....m.
- Height of Cairn.....
 Diameter of Cairn.....m. Name Plate found/not found/placed.
- Length of Mast
 (approximate if not unpiled)
4. A..... set in conc/rock has been placed/found, bearing.....°M from Mast/Plug/Pillar
5. A..... set in conc/rock has been placed/found, bearing.....°M from Mast/Plug/Pillar
6. A..... set in conc/rock has been placed/found, bearing.....°M from Mast/Plug/Pillar
7. A..... set in conc/rock has been placed/found, bearing.....°M from Mast/Plug/Pillar
8. Action required.....

STANDPOINT:

Mark	Direction	Horiz. Distance	Height Difference	Mark	Direction	Horiz. Distance	Height Difference
			above standpt.				above standpt.
			below standpt.				below standpt.
			above standpt.				above standpt.
			below standpt.				below standpt.
Prepared by: *[Signature]* Checked: *[Signature]*
 Noted on U.T.M. Card

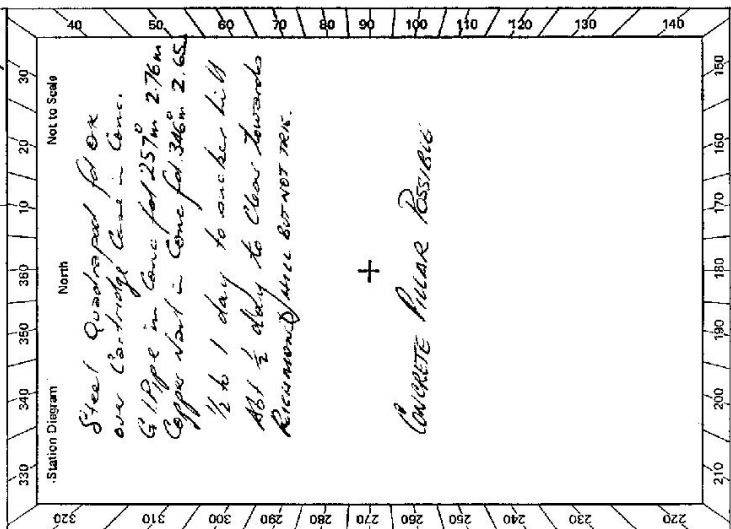

CENTRAL MAPPING AUTHORITY

GEODETIC STATION RECONNAISSANCE and MAINTENANCE REPORT


GEODETIC SURVEY OF A.S.W.

STATION: **DRAKE G.S. (P)** No: **TS 6638**

MAP SHEET SCALE 1:250 000 **WJALWICK**

INSPECTED BY: **C. PAKKES** DATE: **7/11/80**

AUTHORITY: **C.M.A.** FIELD BOOK: **1809**

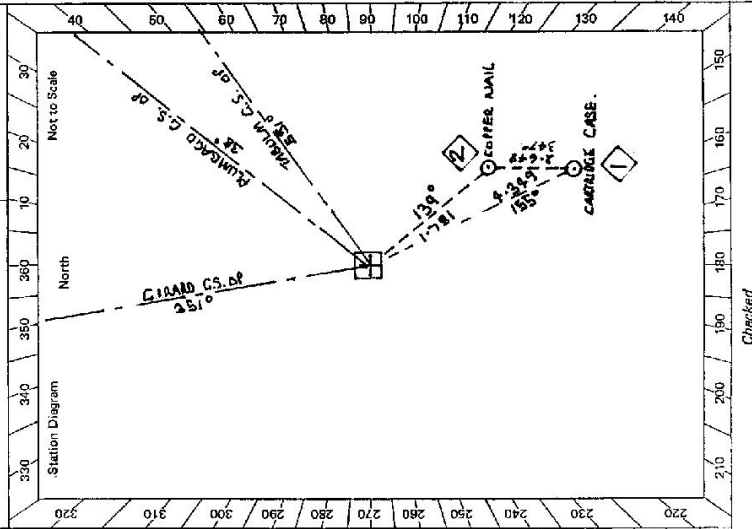

Description:
 1. Cleared by lanes bearing **335° 14' 14.3"** *Note: Cross out word or words which do not apply* from Trig. Mast

2. Mast & Vanes have been painted white & black respectively. ✓

3. The station/pillar was ~~improved~~ ~~not improved~~ / constructed on **2.9 m² 70x7** **19.80** dimensions now being:

Description of mark: **S/S PILLAR PLATE** would be explicit, e.g. S/Steel Pillar Plate, Steel plug, Brass plug, Bolt, G.I. Pipe

Height of mark: **1.965** m. ^{above} ~~below~~ **1.515** m. ^{above} ~~below~~ G.L.

Height of Top Vanes to Top Mark/Pillar plate: **1.935** m. Diameter of Vanes (vertical) **0.755** m.

Height of Cairn: m. Diameter of Cairn: m. Name Plate ~~found/not found~~ / placed.

Length of Mast: m. (approximate if not uplited)

4. A. **COPPER MAIL** set in conc/~~rock~~ ~~found~~ bearing **129** °M from Mast/Plug/Pillar

5. A. **CARTRIDGE CASE** set in conc/~~rock~~ ~~found~~ bearing **155** °M from Mast/Plug/Pillar

6. A. set in conc/rock has been placed/~~found~~ bearing °M from Mast/Plug/Pillar

7. A. set in conc/rock has been placed/~~found~~ bearing °M from Mast/Plug/Pillar

8. Action required:

STANDPOINT: **CONC. PILLAR** STATIONPOINT: **CARTRIDGE CASE**

Mark	Direction	Horiz. Distance	Height Difference	Direction	Mark	Horiz. Distance	Height Difference
GIARAD G.S. (P)	0 00 00		above standpt.	0 00 00	GIARAD G.S. (P)		above standpt.
PULMADGO G.S.	49 29 50		above standpt.	49 29 50	PULMADGO G.S.		above standpt.
TABULAM G.S. (P)	65 49 00		above standpt.	65 48 20	TABULAM G.S. (P)		above standpt.
COPPER MAIL	153 07 40	1.781	below standpt.	346 38 10	PILLAR PLATE	4.348	1.782
CARTRIDGE CASE	146 37 20	4.289	below standpt.	355 40 40	COPPER MAIL	2.648	0.056
			above standpt.				above standpt.
			below standpt.				below standpt.


Prepared by: **C. PAKKES**

Checked: *Noted on U.T.M. Card*

Checked

SI: 2733-2 D. West, Government Printer

Beacon Description

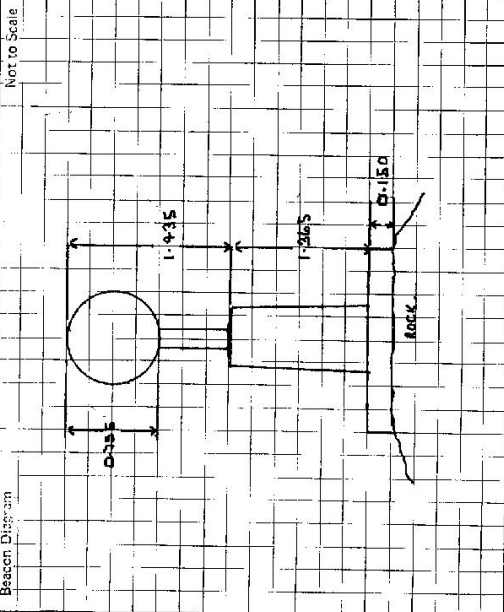

This section to be completed by officer constructing pillar.

Original station mark found/~~not found~~.

Description of mark: CANTONDA CASE

Original beacon found/~~not found~~.

Description of beacon: TRIPOD + BEACON

Height Top of Vanes to Top Mark: 0.510 m.

Height of mark: 0.310 m. above G.L. / 0.150 m. below

Diameter of Vanes: 0.310 m. Height of Cairn 0.150 m.

Original Beacon has/~~has not~~ been destroyed by me.

Owner's Name: FOREST COMMISSION
 Address: CAMINO CANAD STATE FOREST
 Phone: TEMICFIELD 017 361303

Current Occupant
 Address
 Phone

ACCESS

Access Report of 30/05/1979 was found suitable/~~unsuitable~~.

KM	FEATURE
0-0	TEMICFIELD RD. HEAD NORTH TOWARDS STANTHORPE
0-19	TURN RIGHT INTO BRUNNER HWY HEAD TOWARDS LAINDO.
39-00	ARRIVE OVER CROOKED CREEK
40-33	PASS "RED ROCK RD" ON LEFT
41-89	TURN RIGHT OFF HIGHWAY OPPOSITE WHITE OF GREEN MAILBOX + SIGN "LEIARD STATE FOREST"
41-95	TAKE LEFT FORK SIGN "RICHMOND FOREST RD"
42-98	STRAIGHT AHEAD OVER "BOWENBARD FOREST RD"
42-61	PASS TRACK ON LEFT (ALONG TELEPHONE LINE)
42-99	PASS TRACK ON RIGHT
42-58	TAKE LEFT FORK
42-64	PASS TRACK ON RIGHT
44-39	PASS TRACK AND WATER TANK ON LEFT.
45-04	TAKE TRAIL TO LEFT
45-44	PASS TRAIL ON RIGHT
45-73	TAKE RIGHT FORK
45-82	TRIG.

Date

Record of Station

STATION DRAKE GS (A) TS 6638

GEODETTIC SURVEY OF M.S.M.

CENTRAL MAPPING AUTHORITY

GEODETTIC STATION RECONNAISSANCE and MAINTENANCE REPORT

- Description: *Note: Cross out word or words which do not apply*
- Cleared by Janes bearing..... from Trig. Mast
 - Mast & Vanes have been painted white & black respectively.
 - The station/pillar was unpiled/not unpiled/constructed on.....¹⁹....., dimensions now being:
Description of mark.....should be explicit, e.g., S/Steel Pillar Plate, Steel plug, Brass plug, Bolt, G.I. Pipe
Height of mark.....^{above} rock/concrete; Mark is.....^{above} G.L.
Height of Top Vanes to Top Mark/Pillar platem. Diameter of Vanes (vertical).....m.
Height of Cairn.....m. Diameter of Cairn.....m. Name Plate found/not found/placed.
Length of Mastm. (approximate if not unpiled)
 - A.....set in conc/rock has been placed/found, bearing.....° M from Mast/Plug/Pillar
 - A.....set in conc/rock has been placed/found, bearing.....° M from Mast/Plug/Pillar
 - A.....set in conc/rock has been placed/found, bearing.....° M from Mast/Plug/Pillar
 - A.....set in conc/rock has been placed/found, bearing.....° M from Mast/Plug/Pillar
 - Action required.....

STANDPOINT:

Mark	Direction	Horiz. Distance	Height Difference	Mark	Direction	Horiz. Distance	Height Difference
			above standpt.				above standpt.
			below				below
			above standpt.				above standpt.
			below				below
Prepared by: Checked:
Noted on U.T.M. Card

STATION: Droke G.S. (P) No.: 6638
 MAP SHEET SCALE 1:250 000
 INSPECTED BY: W. J. J. J. DATE: 7/11/80
 AUTHORITY: C.M.A. FIELD BOOK: 1208

Station Diagram
 Not to Scale
 North